


2/24/2012 2:30:52 PM V:\NBS3\octive\9530033_1092\Highway\PlotFiles\133 XS-US2.dwg

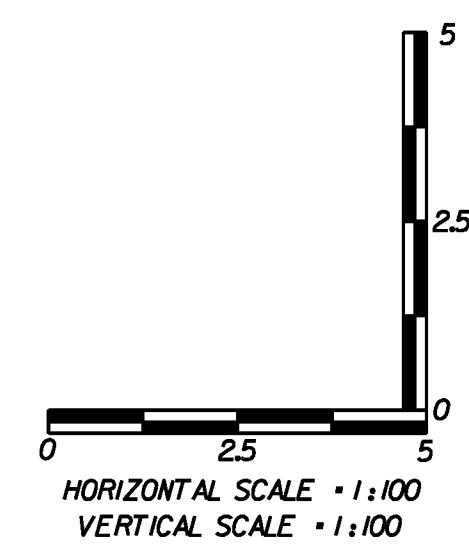

**REPLACEMENT SHEETS
ISSUED 02/24/12**

PROJECT NAME: DANVILLE	
PROJECT NUMBER: F EGC 028-3(32)	
FILE NAME: ...PlotFiles\133 XS-US2.dwg	PLOT DATE: 2/24/2012
DESIGN SUPERVISOR: GARY SANTY	DRAWN BY: STANTEC
DESIGNED BY: STANTEC	CHECKED BY: STANTEC
US ROUTE 2 CROSS SECTIONS - MLX-5	
SHEET 229 OF 306	

STA 18+670 TO 18+700