




18+762.4
CONC. & GRAVEL DRIVE, LT

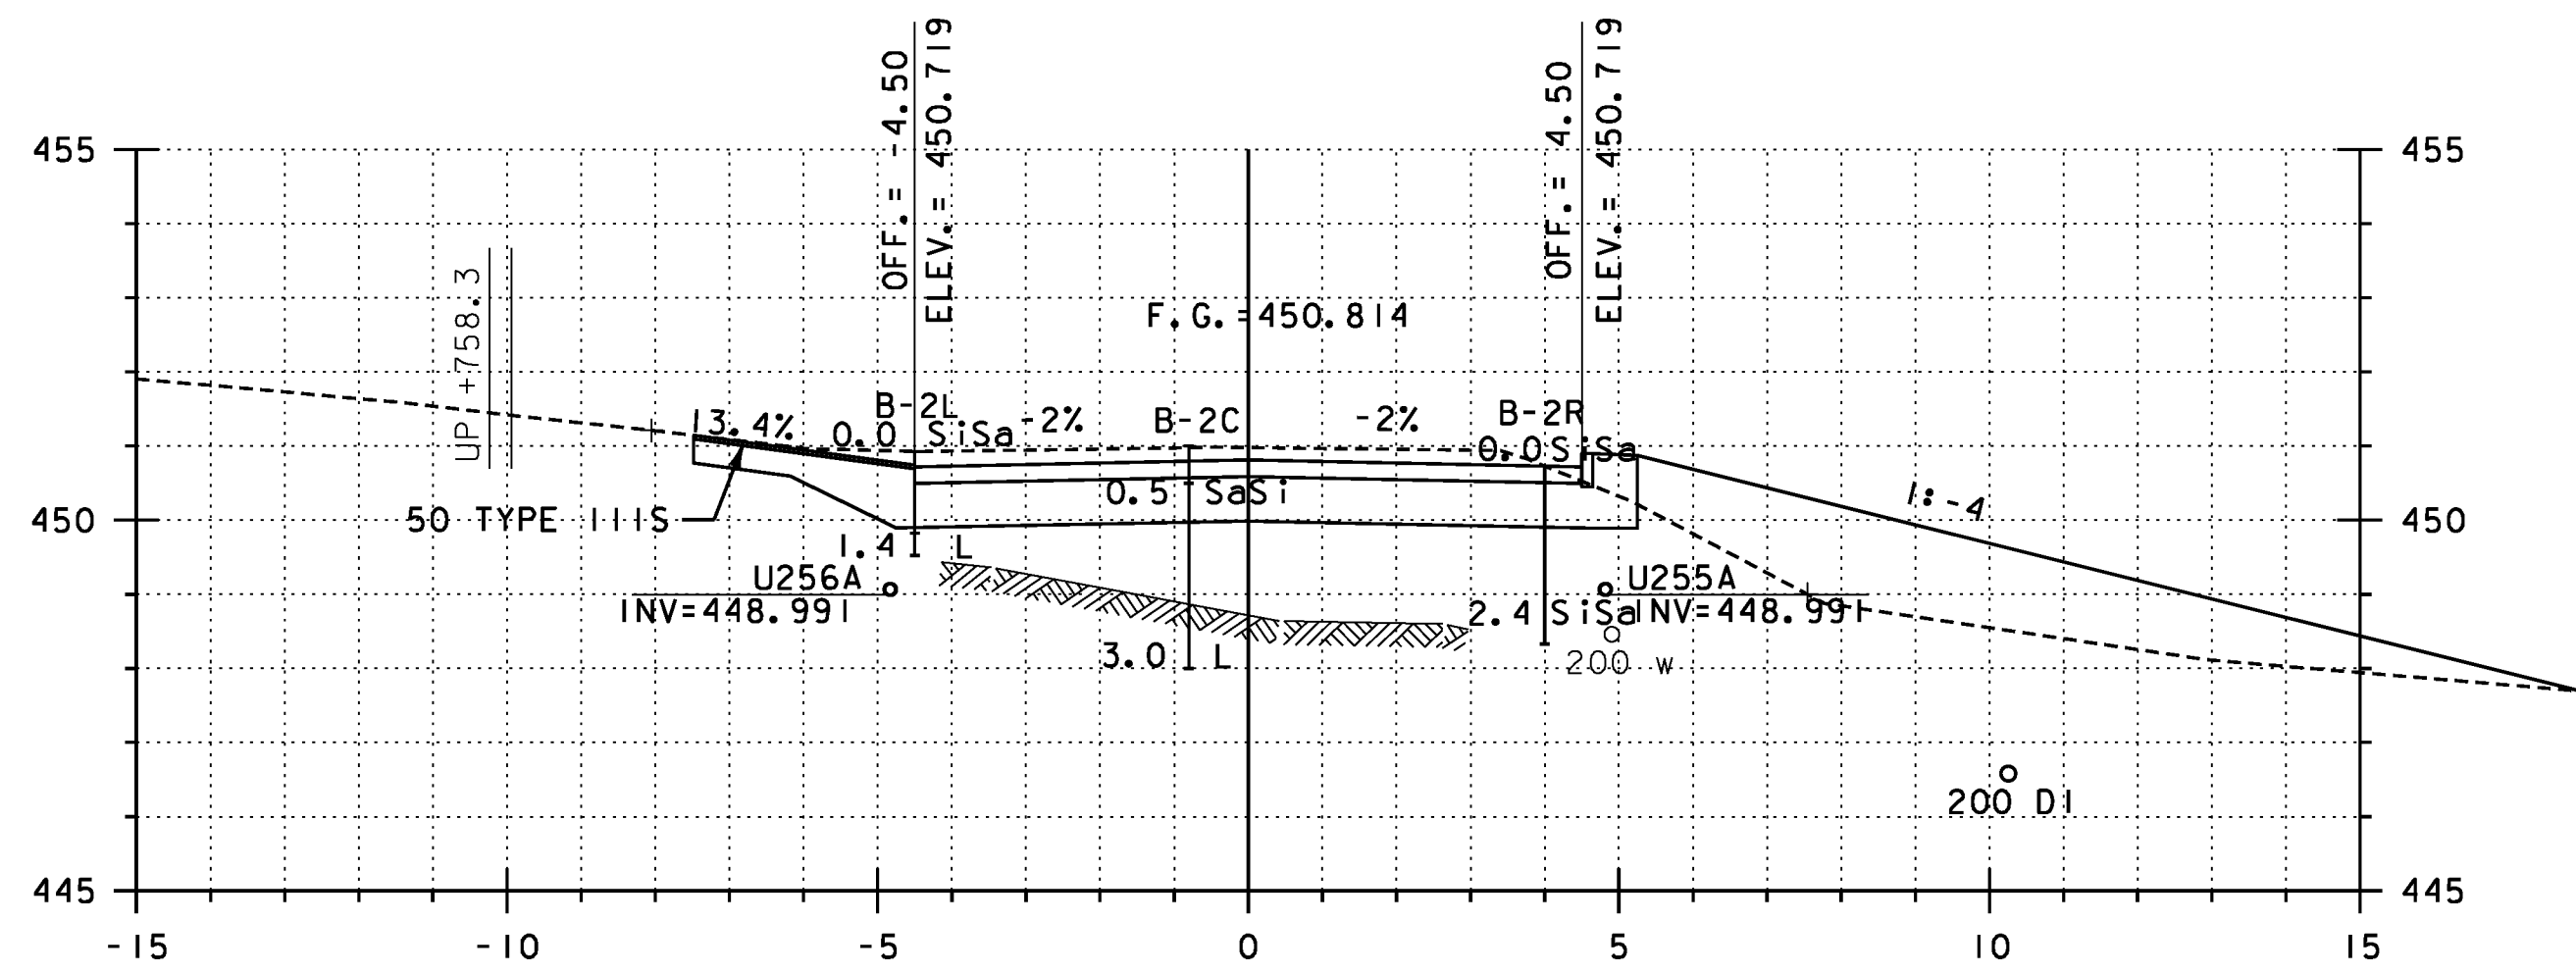


18+760

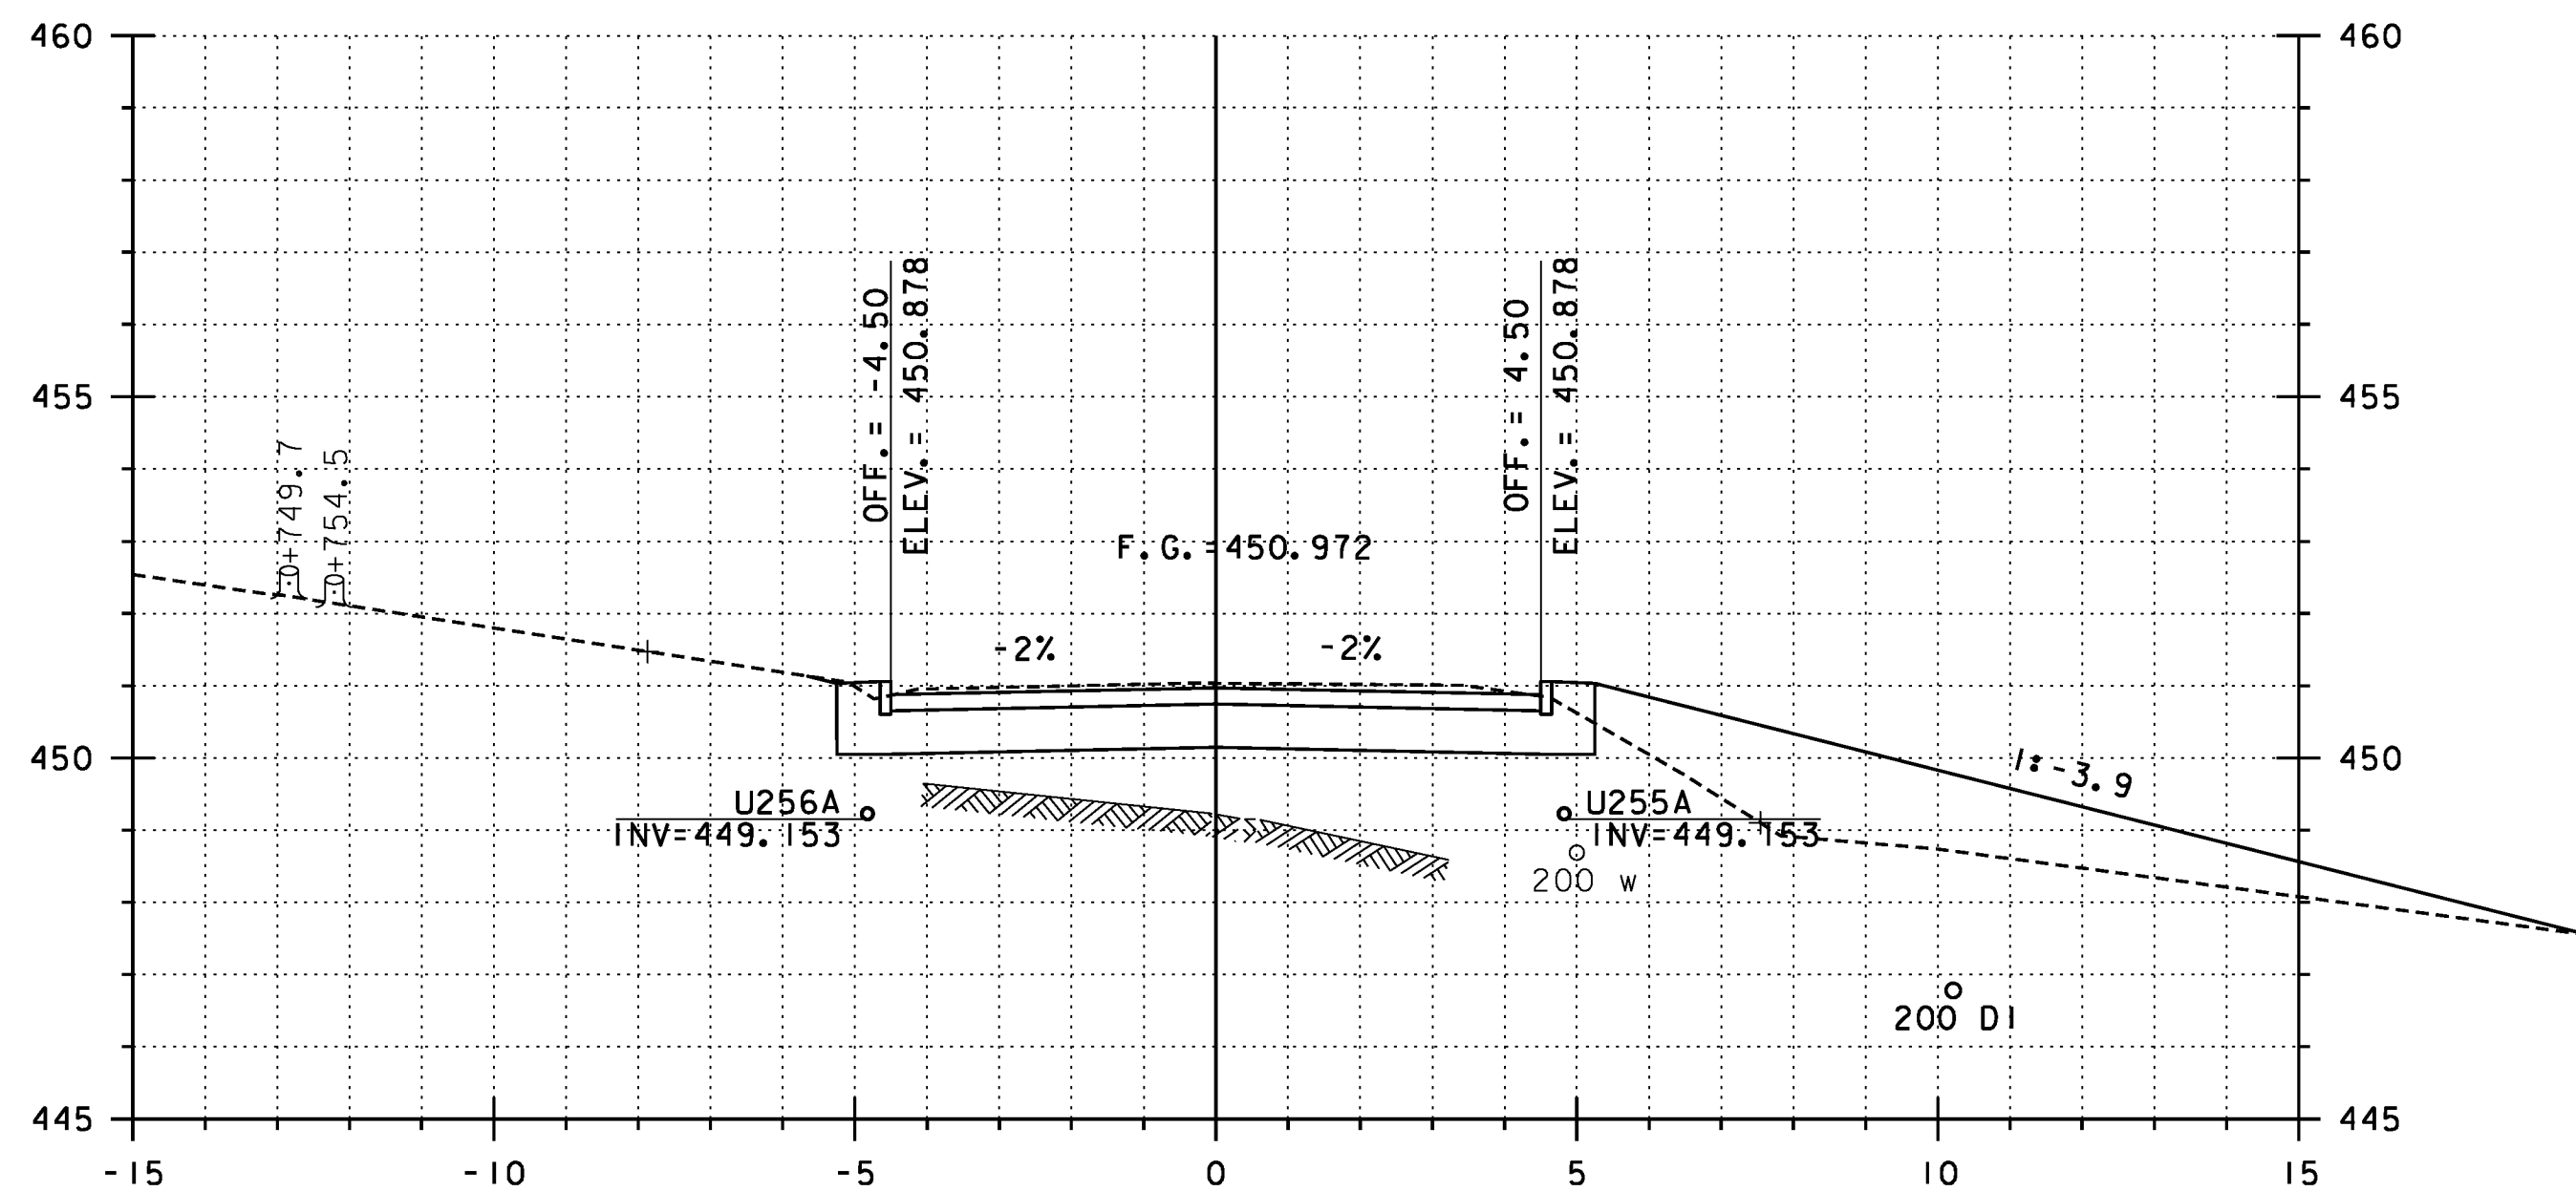

18+750

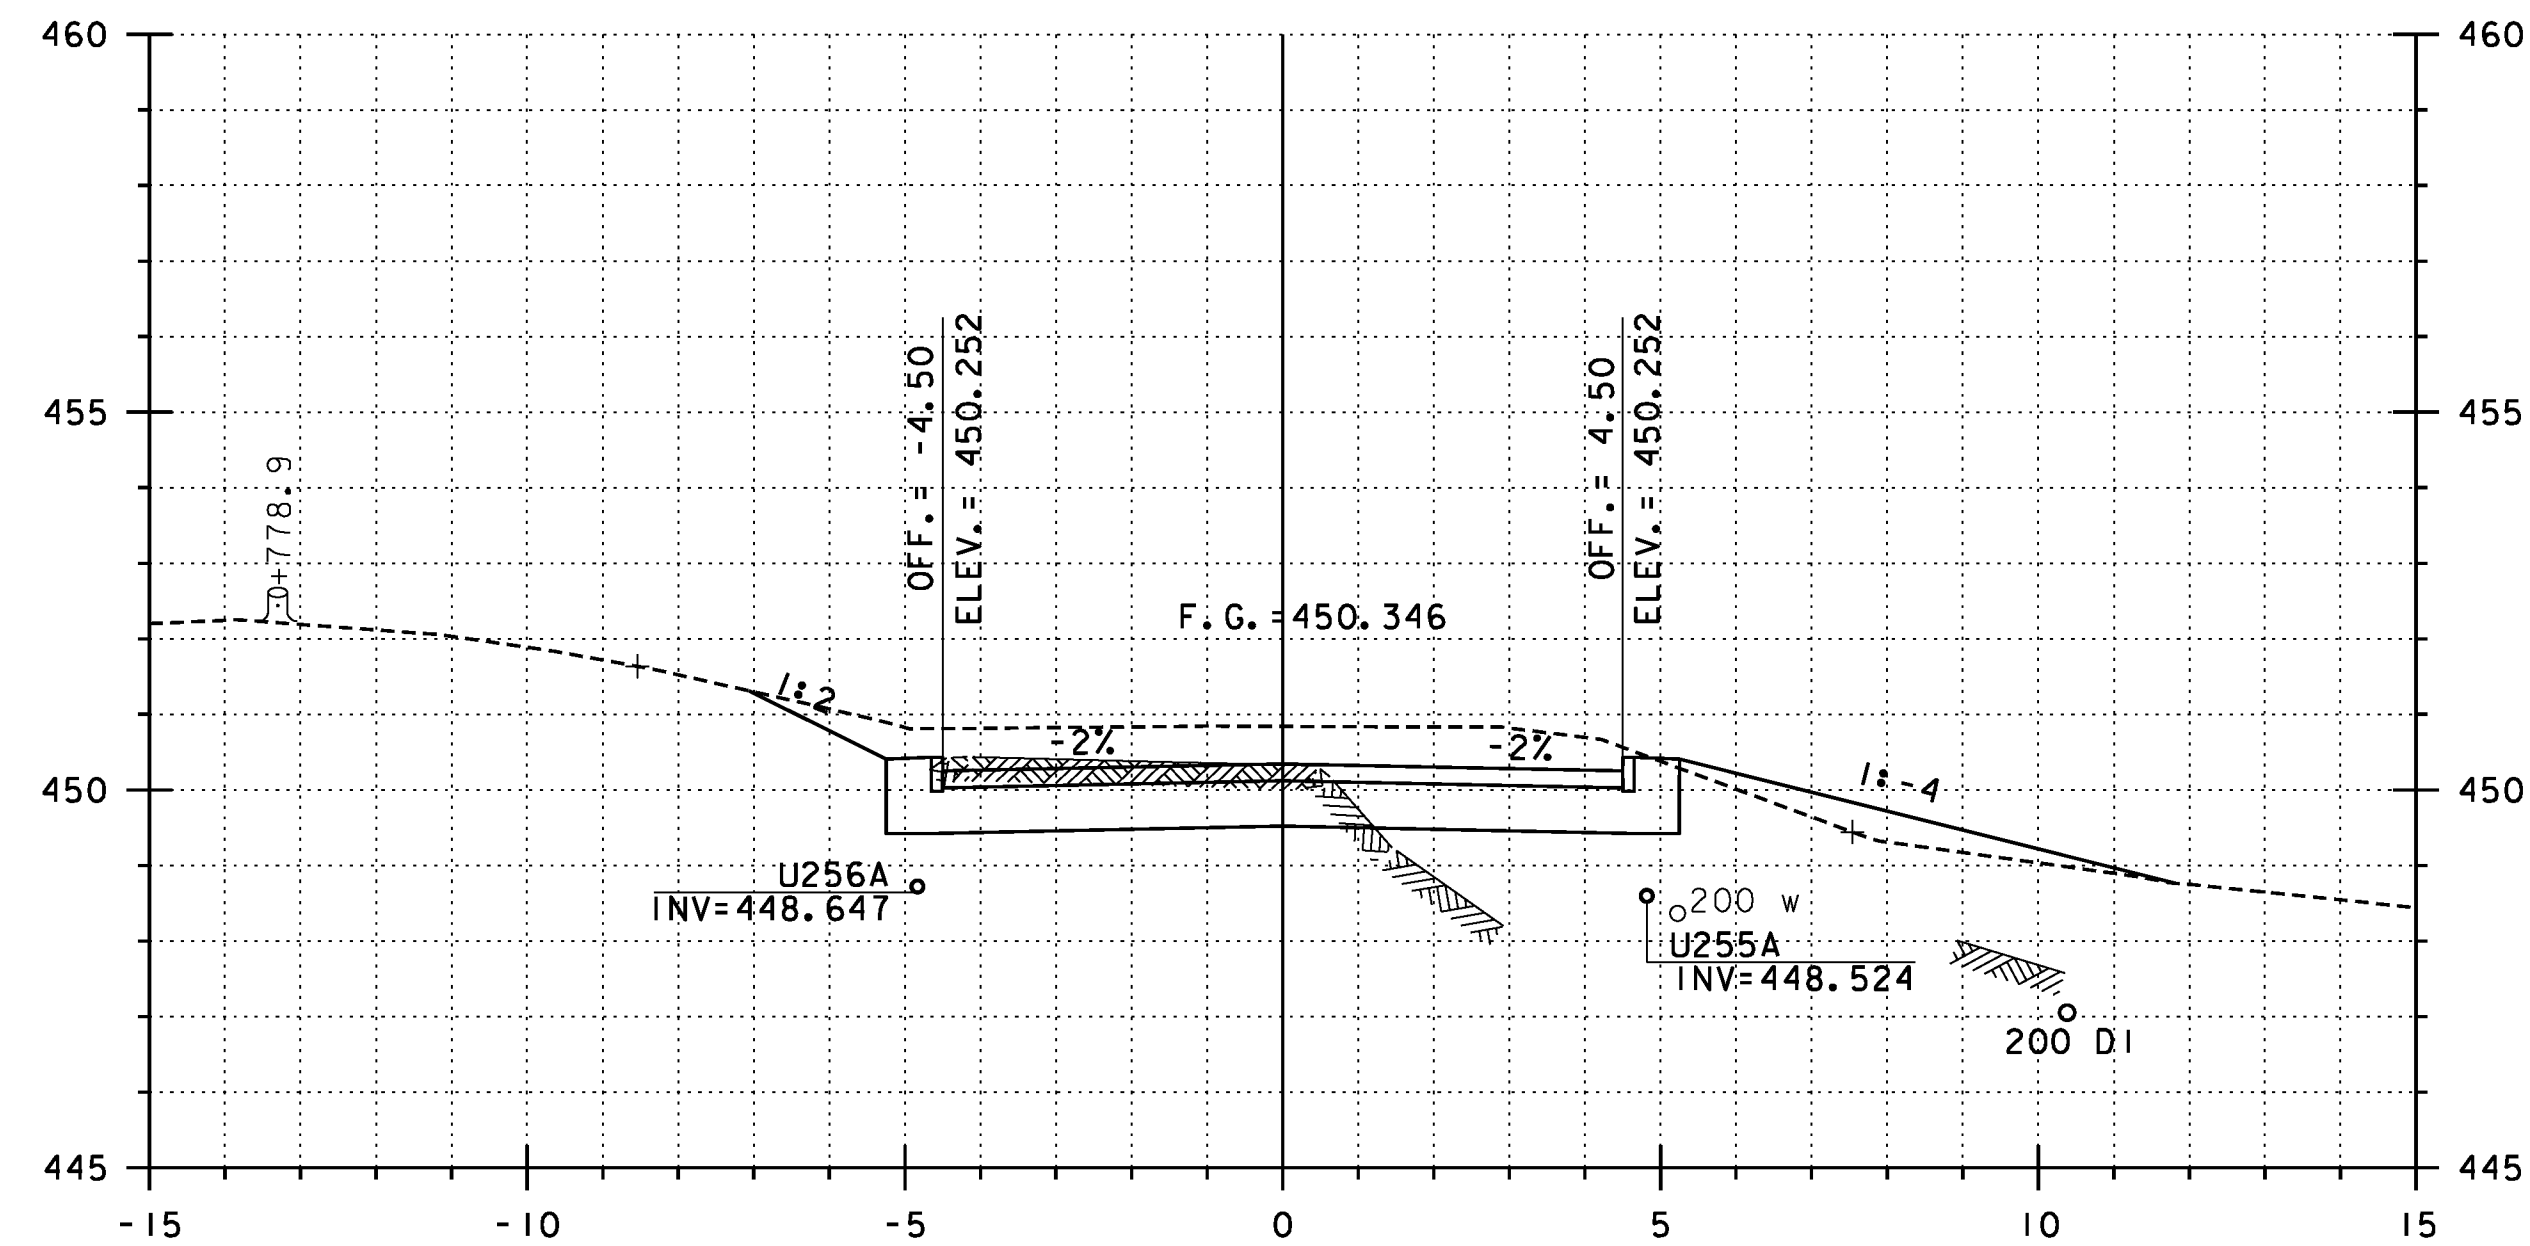

18+780

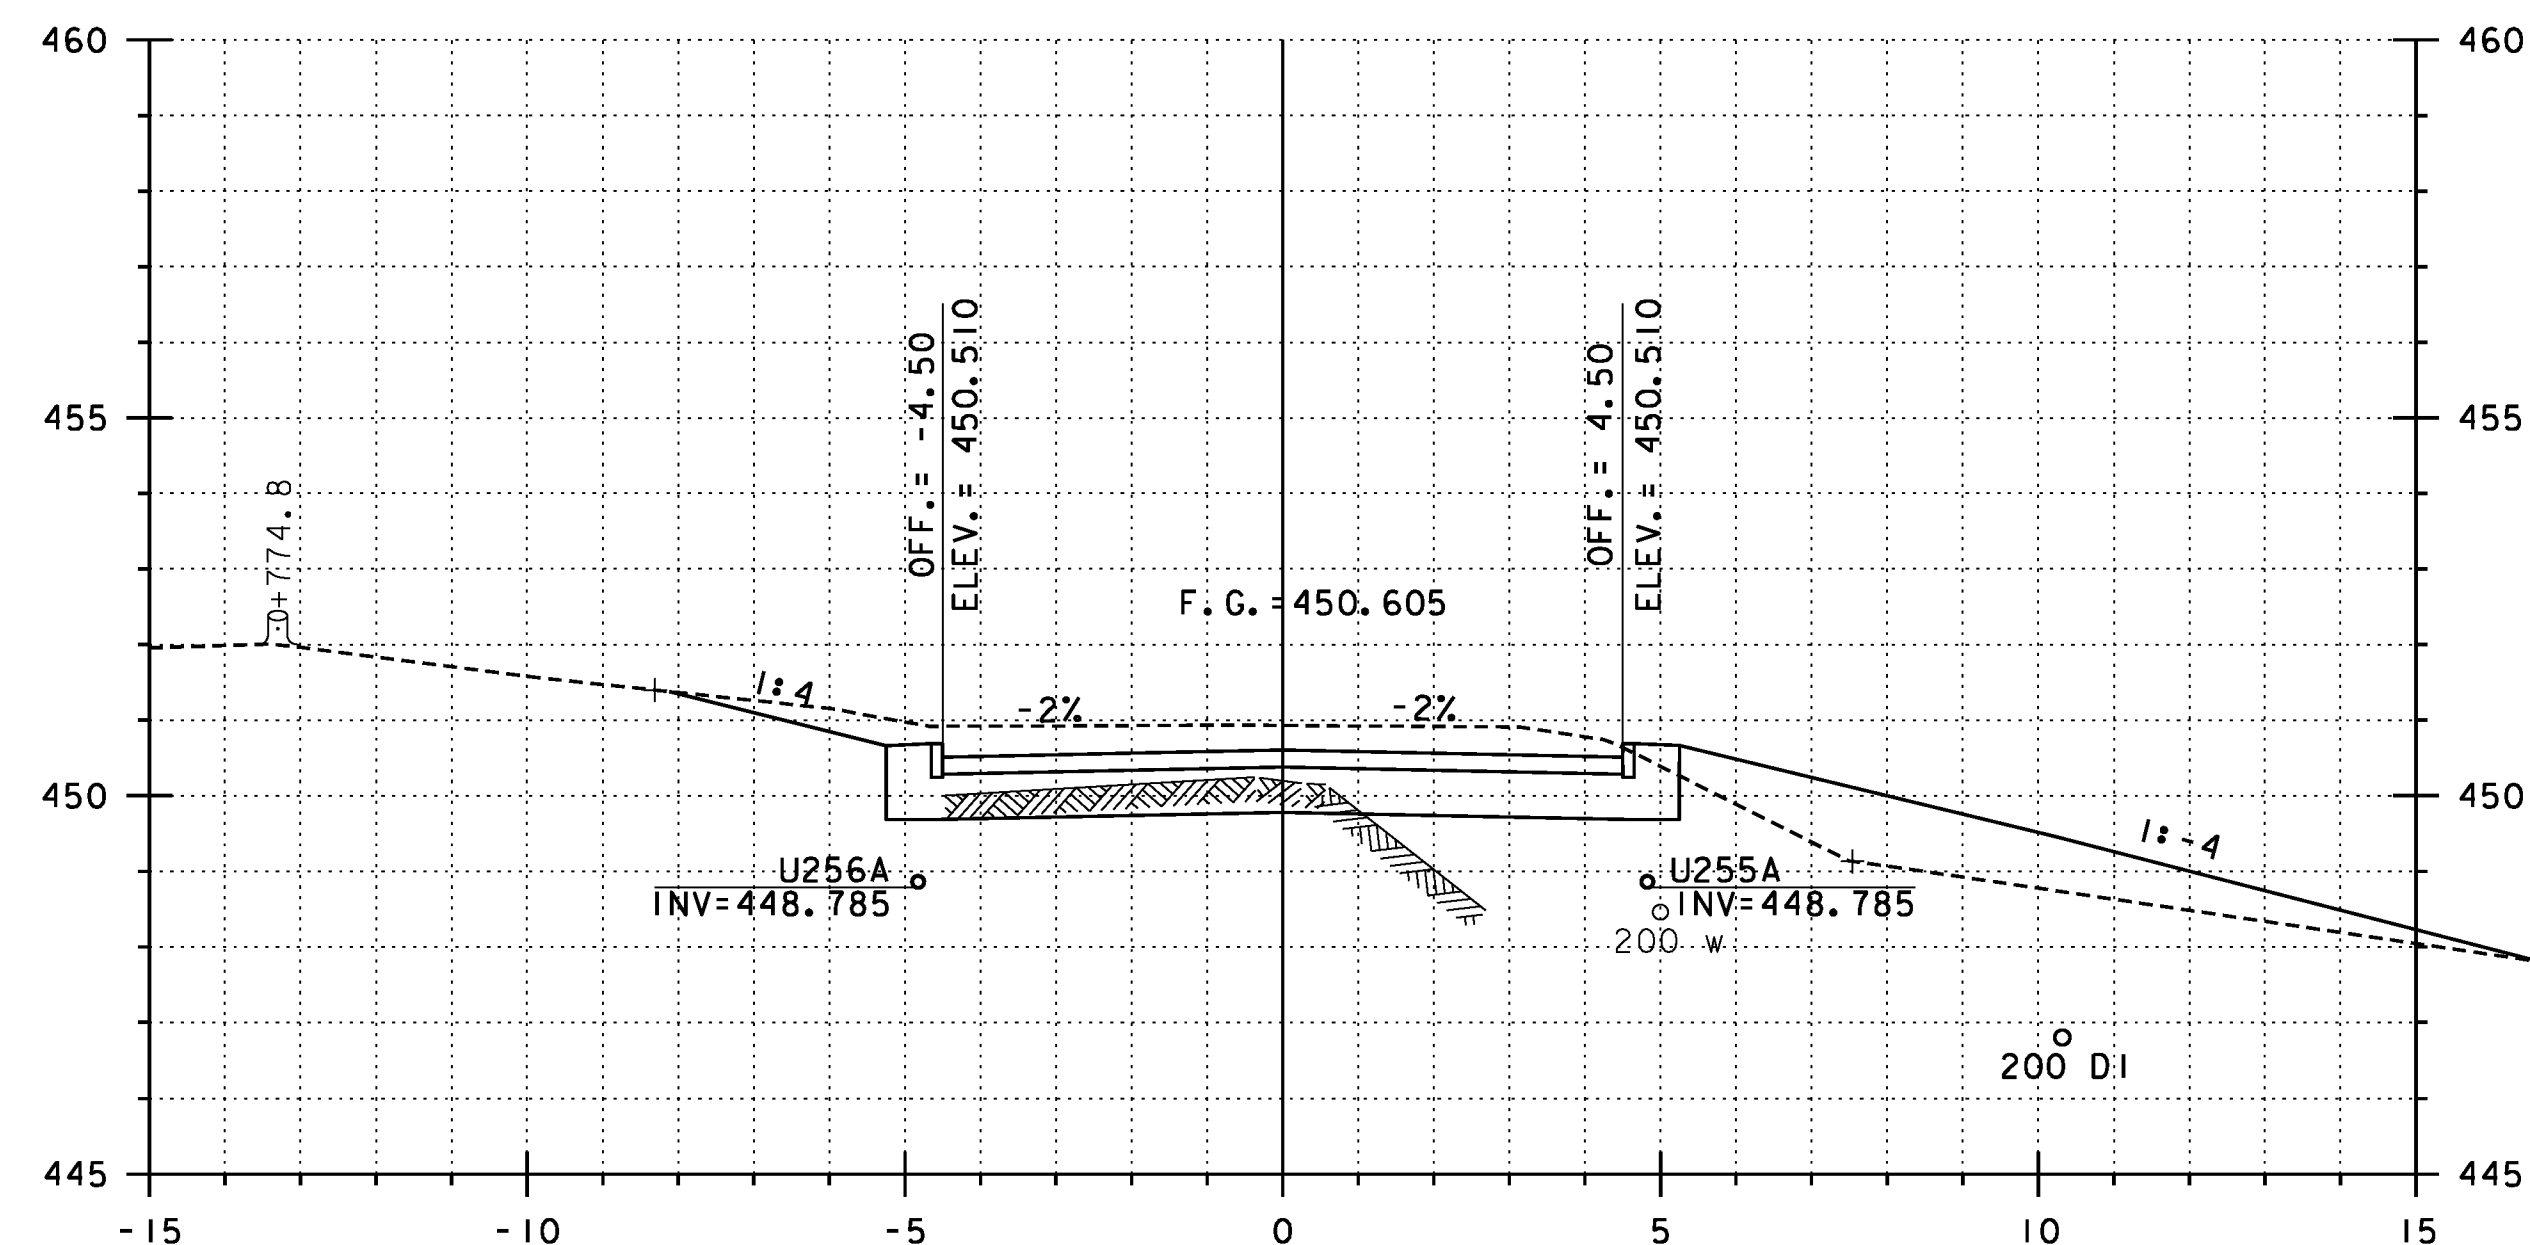

18+770

**REPLACEMENT SHEETS
ISSUED 02/24/12**

STA 18+750 TO 18+780

PROJECT NAME: DANVILLE
PROJECT NUMBER: F EGC 028-3(32)

FILE NAME: ...PlotFiles\133 XS-US2.10m.ptf PLOT DATE: 2/24/2012
DESIGN SUPERVISOR: GARY SANTY DRAWN BY: STANTEC
DESIGNED BY: STANTEC CHECKED BY: STANTEC
US ROUTE 2 CROSS SECTIONS - MLX-7 SHEET 231 OF 306

