


**REPLACEMENT SHEETS
ISSUED 02/24/12**

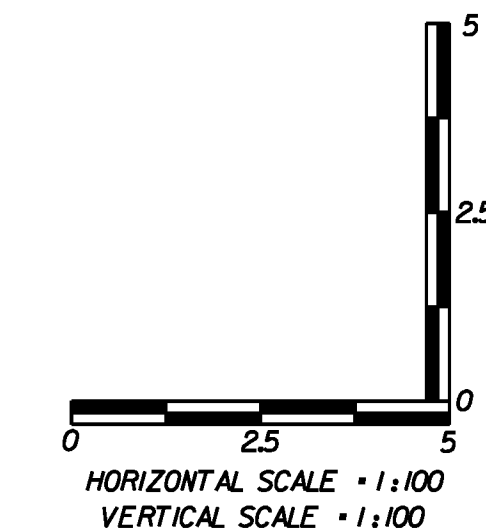

STA 19+650 TO 19+690	
PROJECT NAME:	DANVILLE
PROJECT NUMBER:	F EGC 028-3(32)
FILE NAME:	...PlotFiles\133 XS-US2.10m.ptf
DESIGN SUPERVISOR:	GARY SANTY
DESIGNED BY:	STANTEC
US ROUTE 2 CROSS SECTIONS - MLX-32	
PLLOT DATE:	2/24/2012
DRAWN BY:	STANTEC
CHECKED BY:	STANTEC
SHEET	256 OF 306

2/24/2012 2:34:02 PM V:\1953\active\19530033_1092\Highway\PlotFiles\133 XS-US2.10m.ptf