




19+769.1
BIT., LT

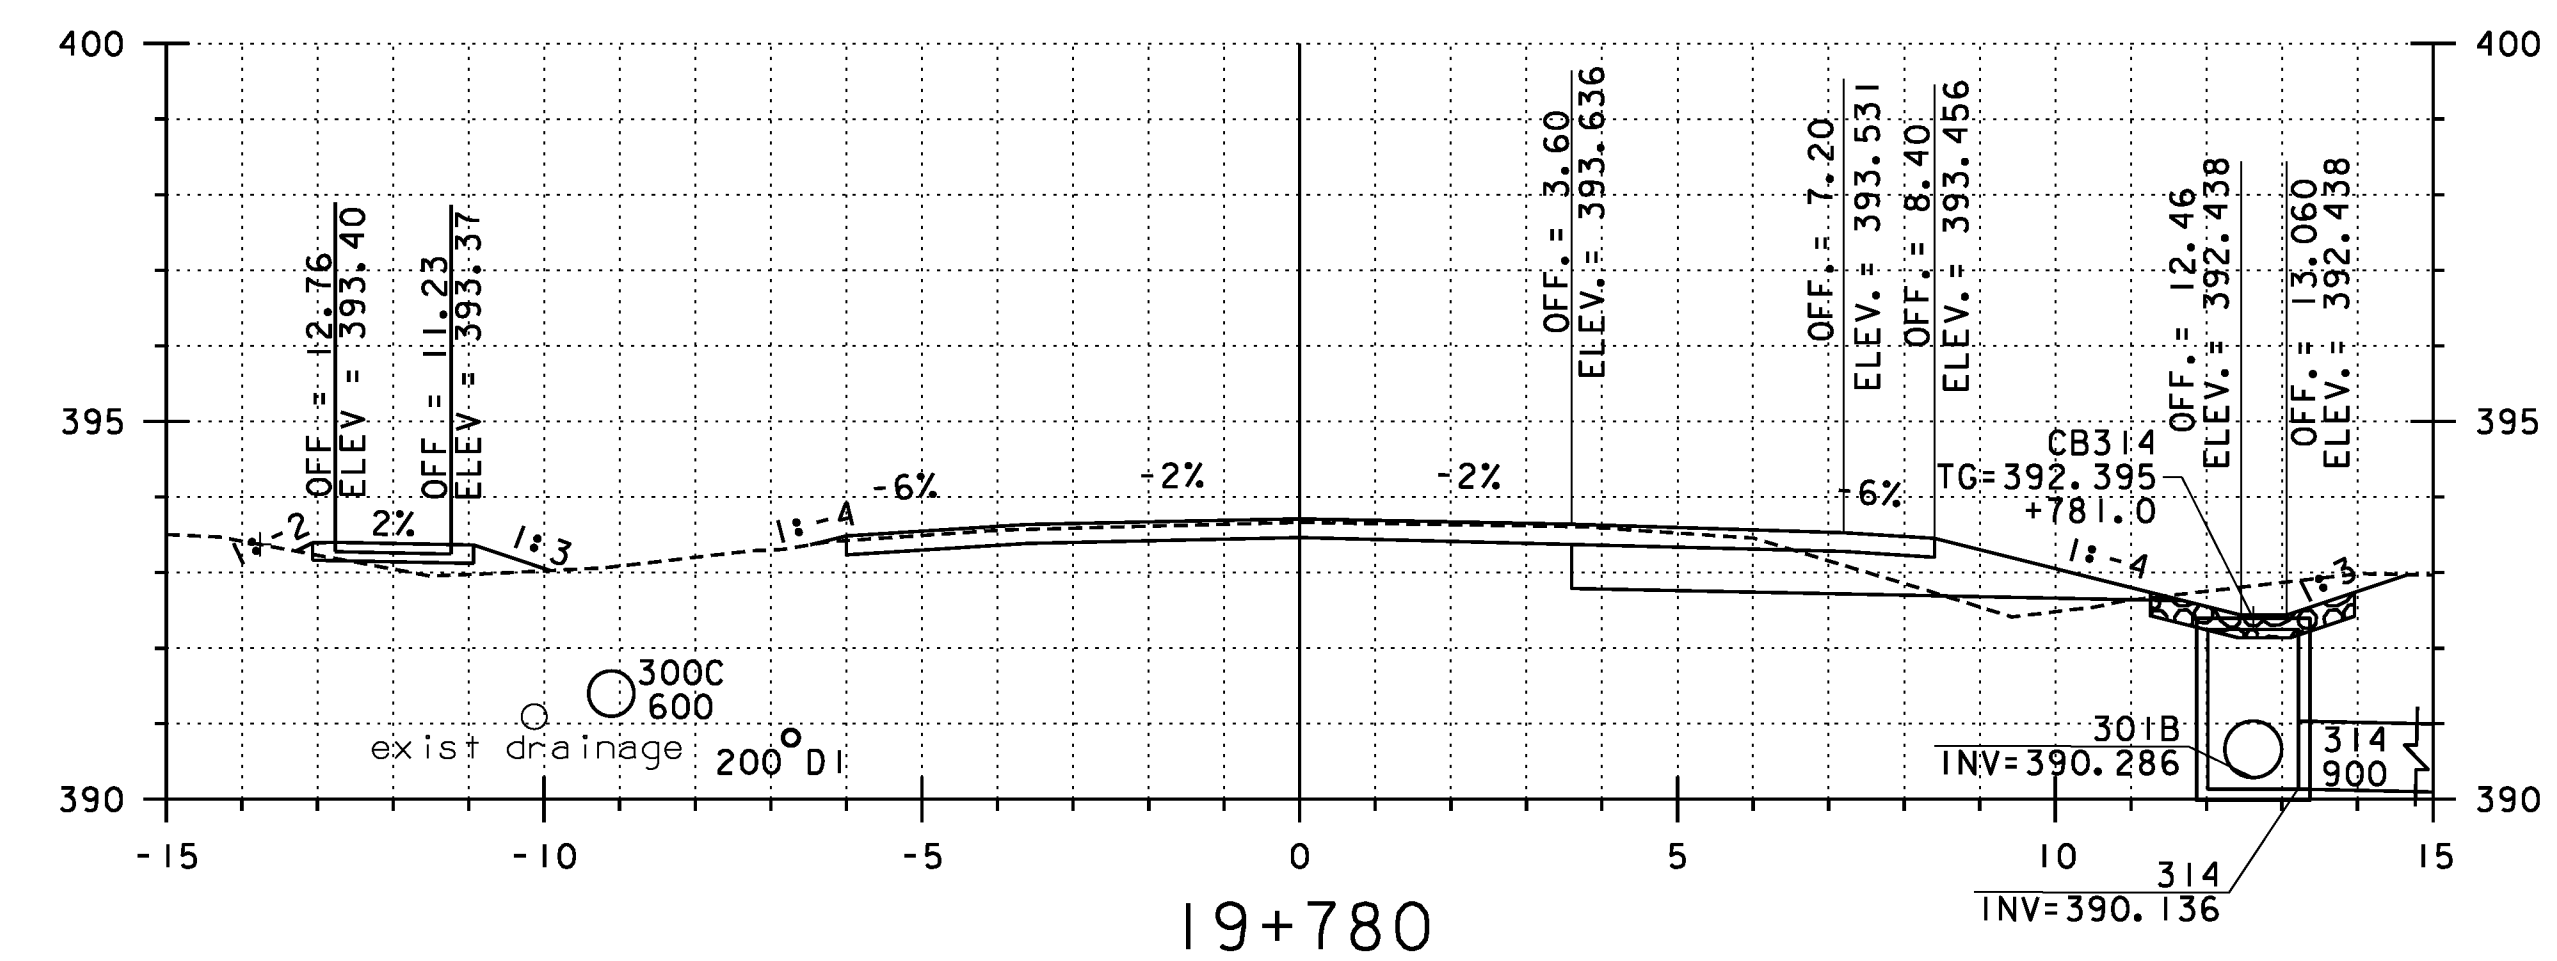


19+780

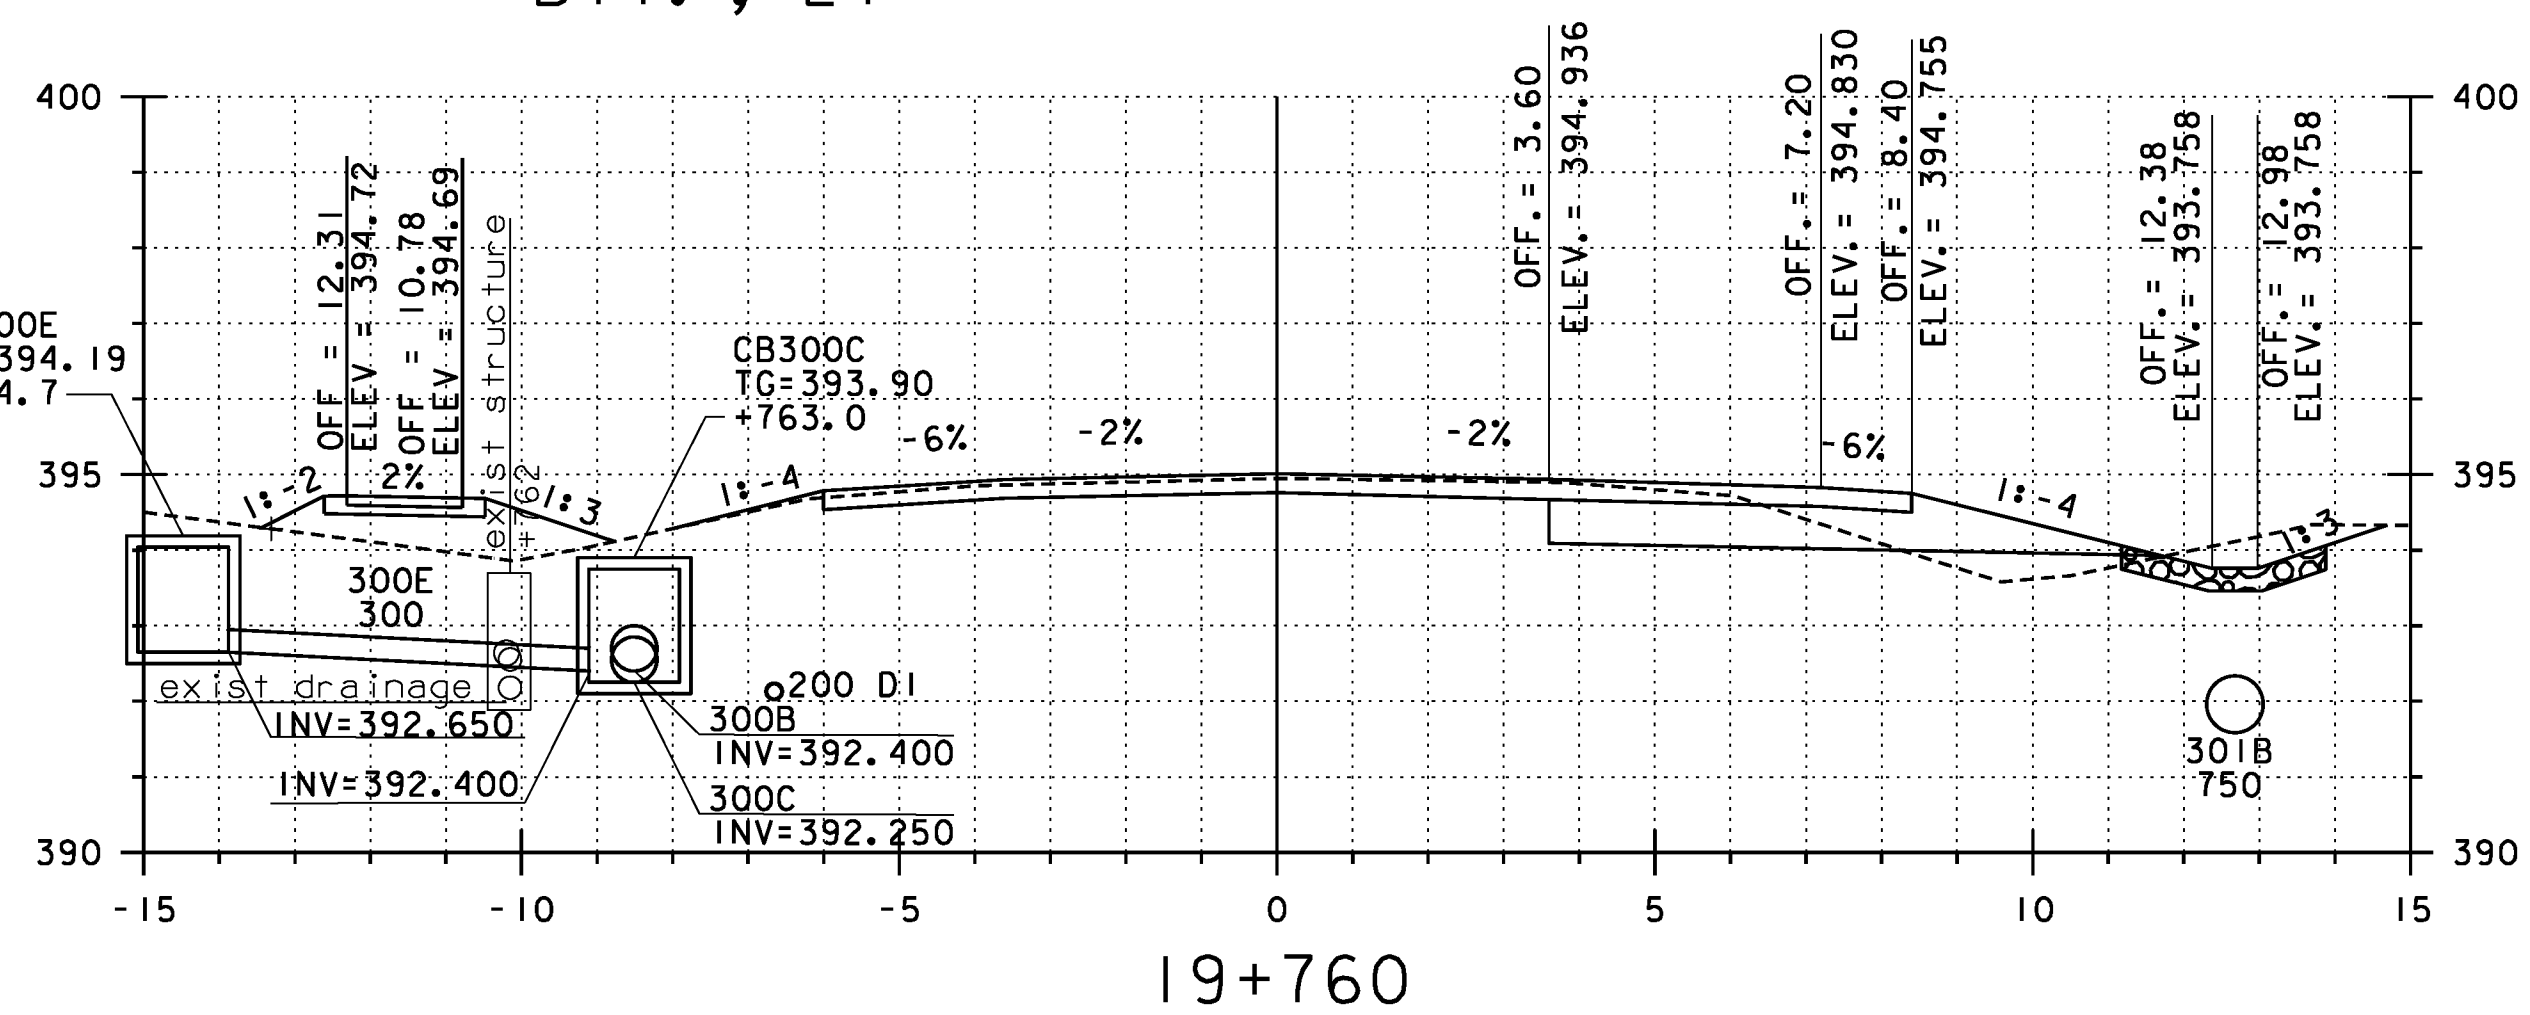

19+760

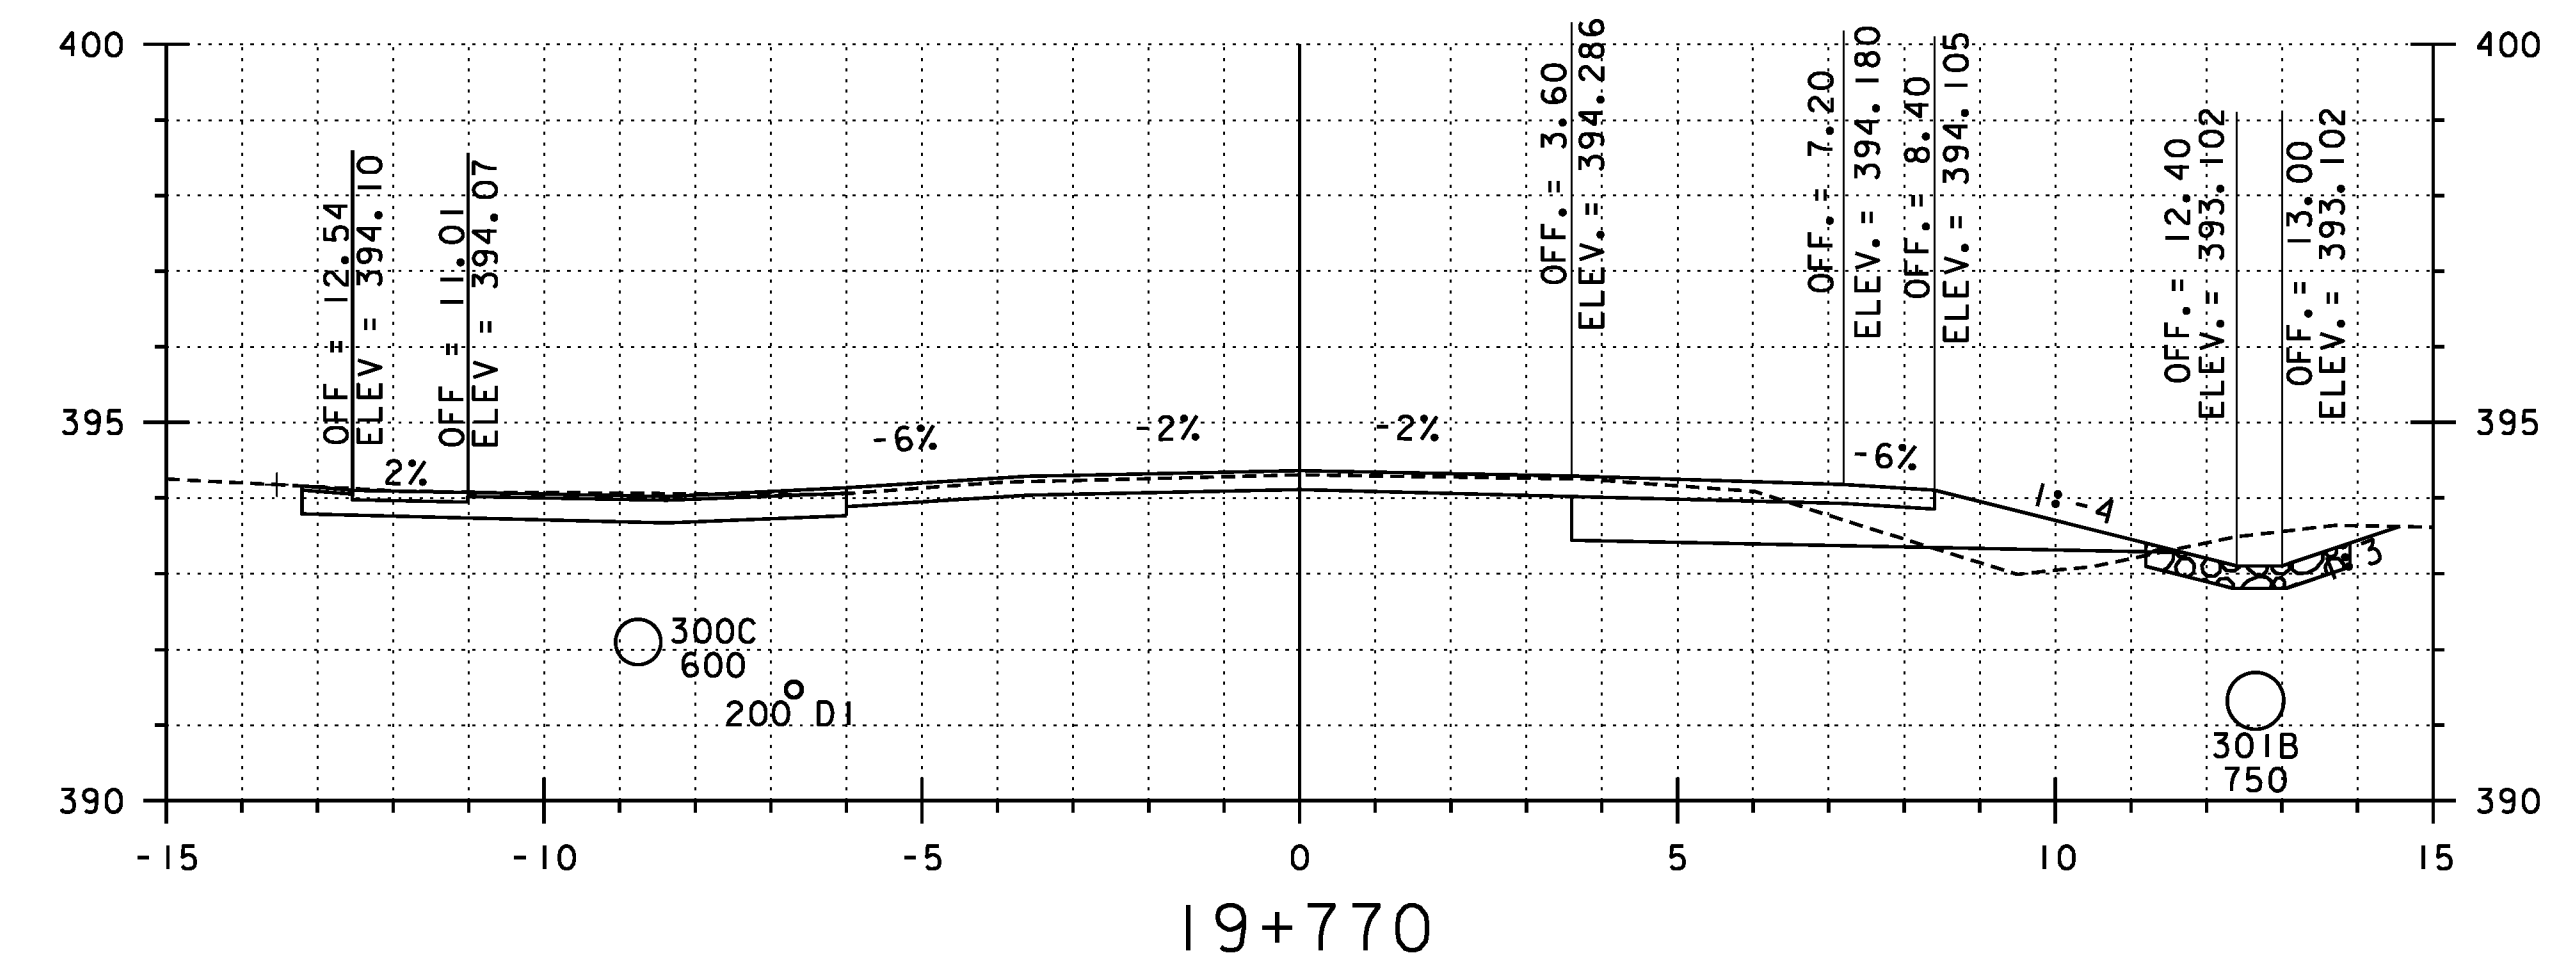

19+770

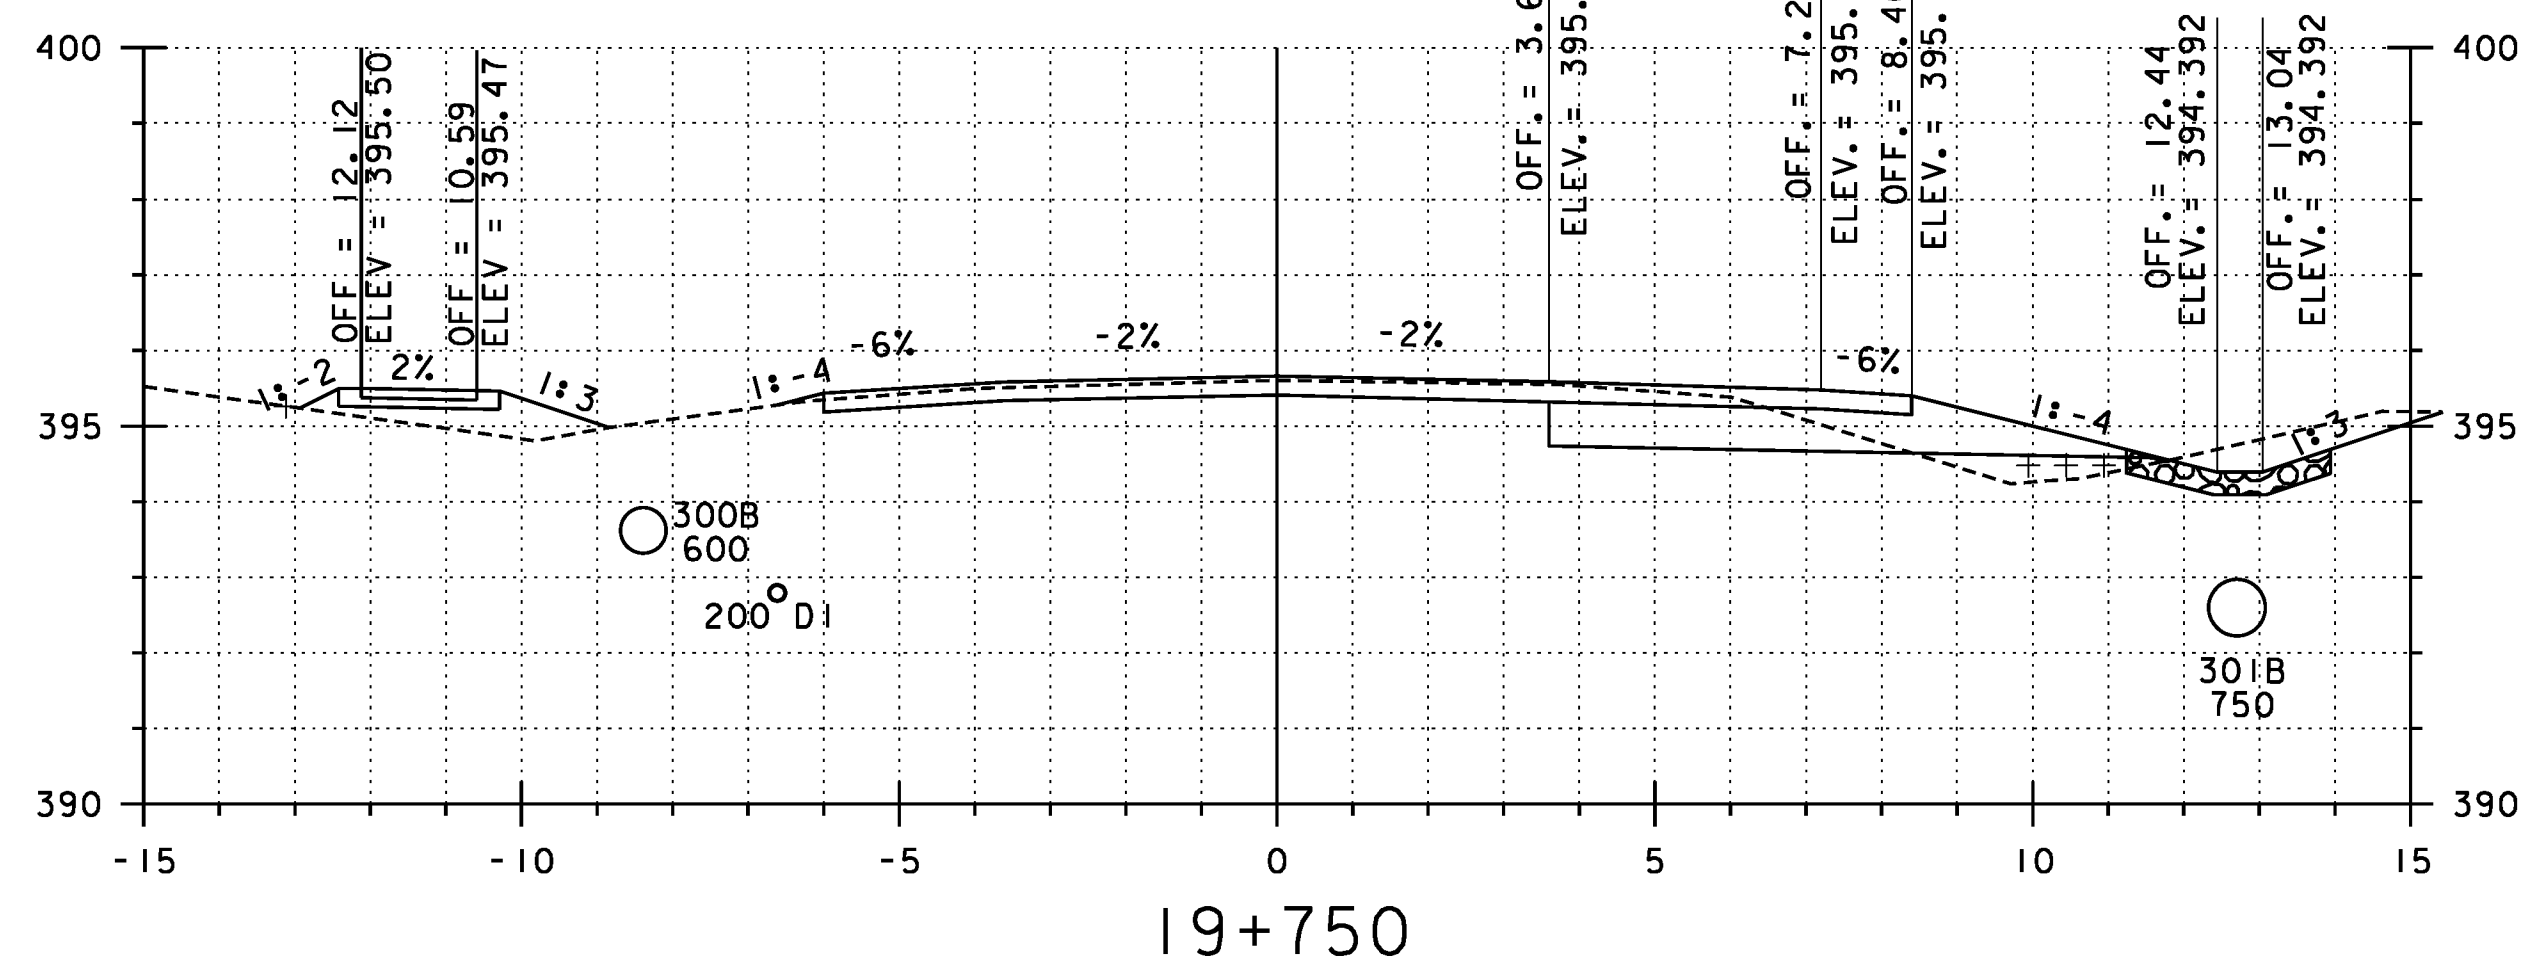

19+750

**REPLACEMENT SHEETS
ISSUED 02/24/12**

STA 19+750 TO 19+780

PROJECT NAME:	DANVILLE	PLOT DATE:	2/24/2012
PROJECT NUMBER:	F EGC 028-3(32)	DESIGN SUPERVISOR:	GARY SANTY
DESIGNED BY:	STANTEC	CHECKED BY:	STANTEC
FILE NAME:	...\\PlotFiles\133 XS-US2.10m.ptf	DRAWN BY:	STANTEC
US ROUTE 2 CROSS SECTIONS - MLX-34		SHEET 258 OF 306	

