
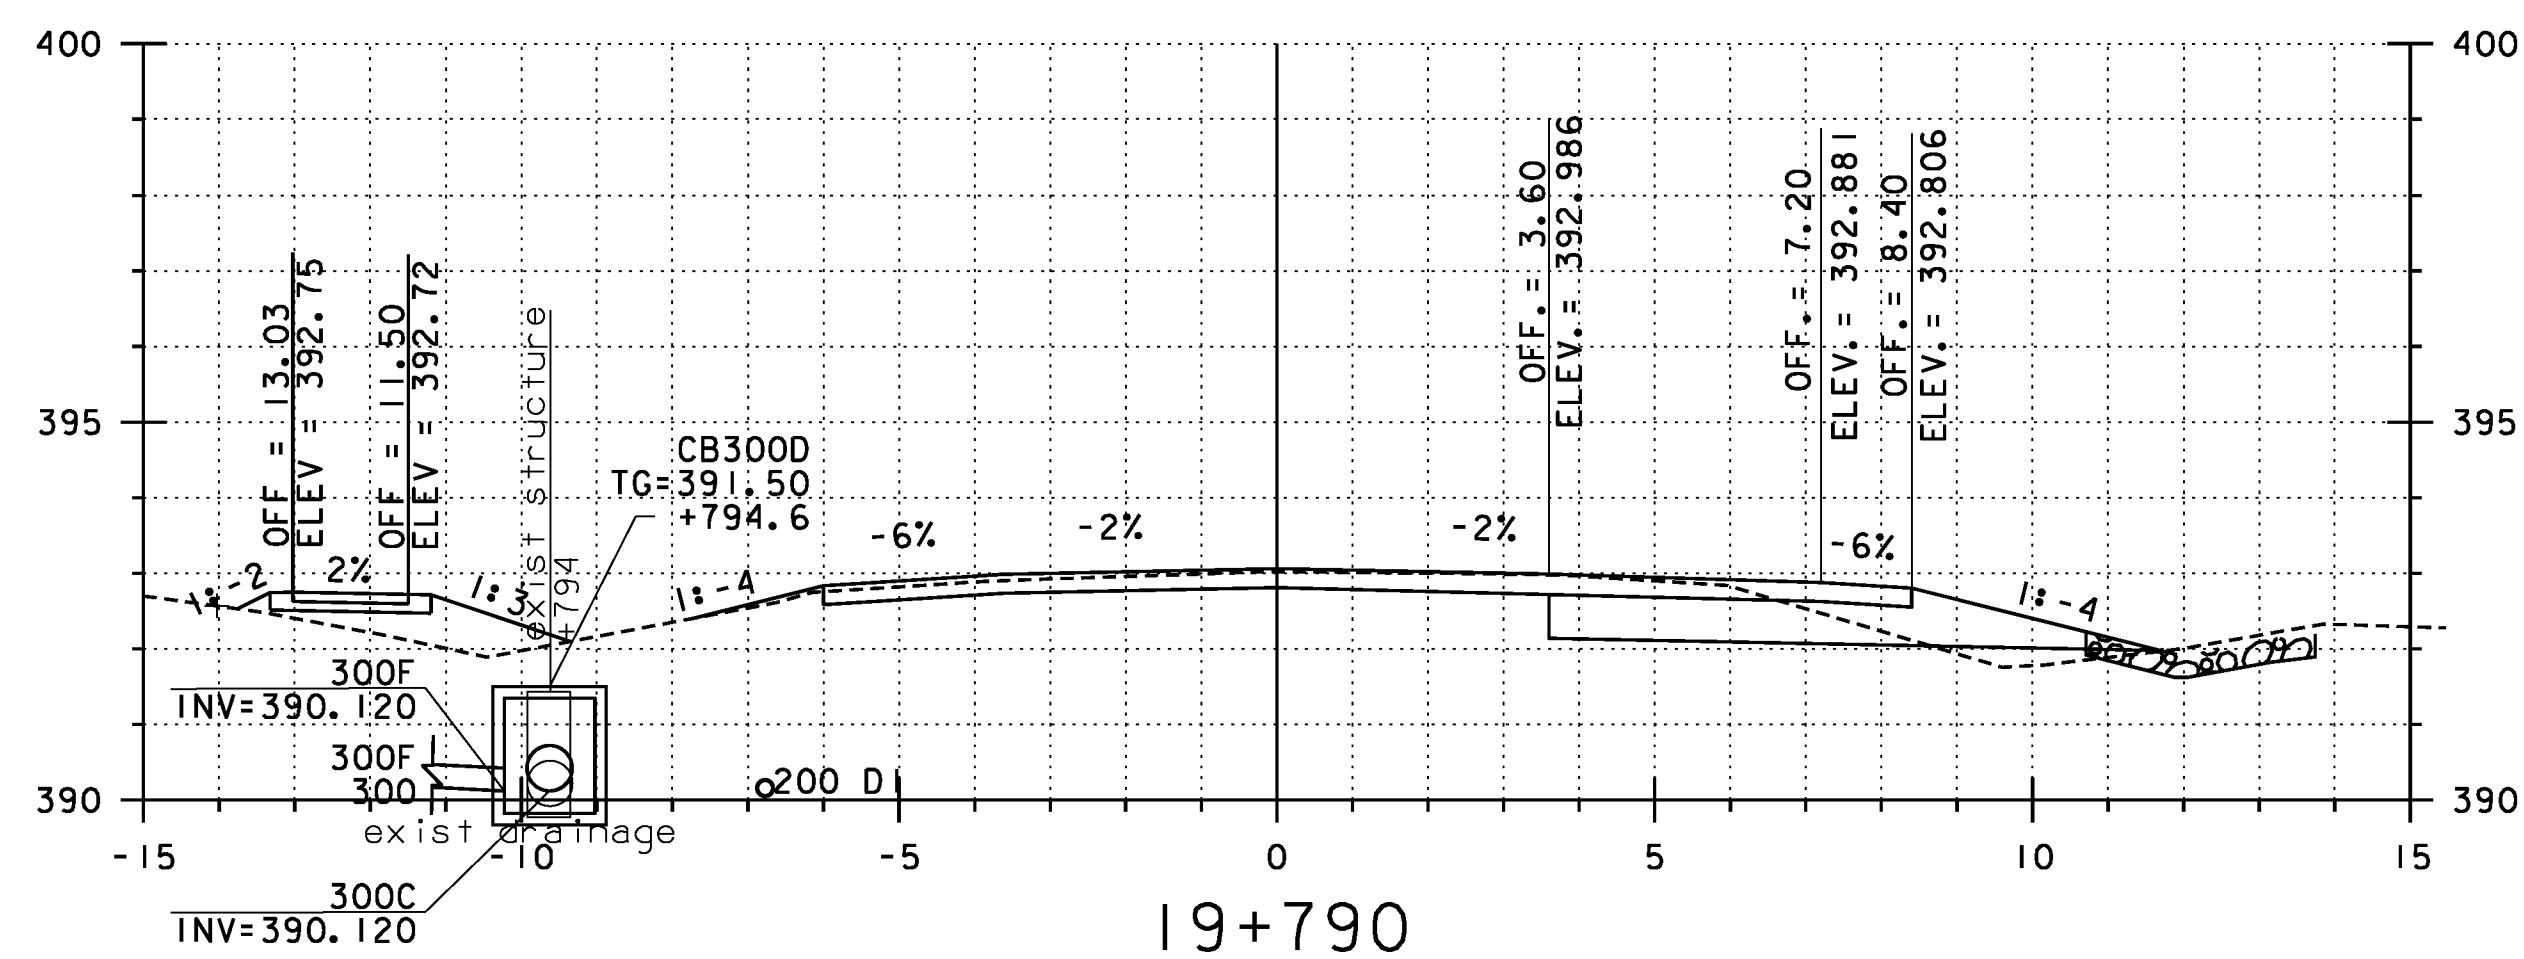
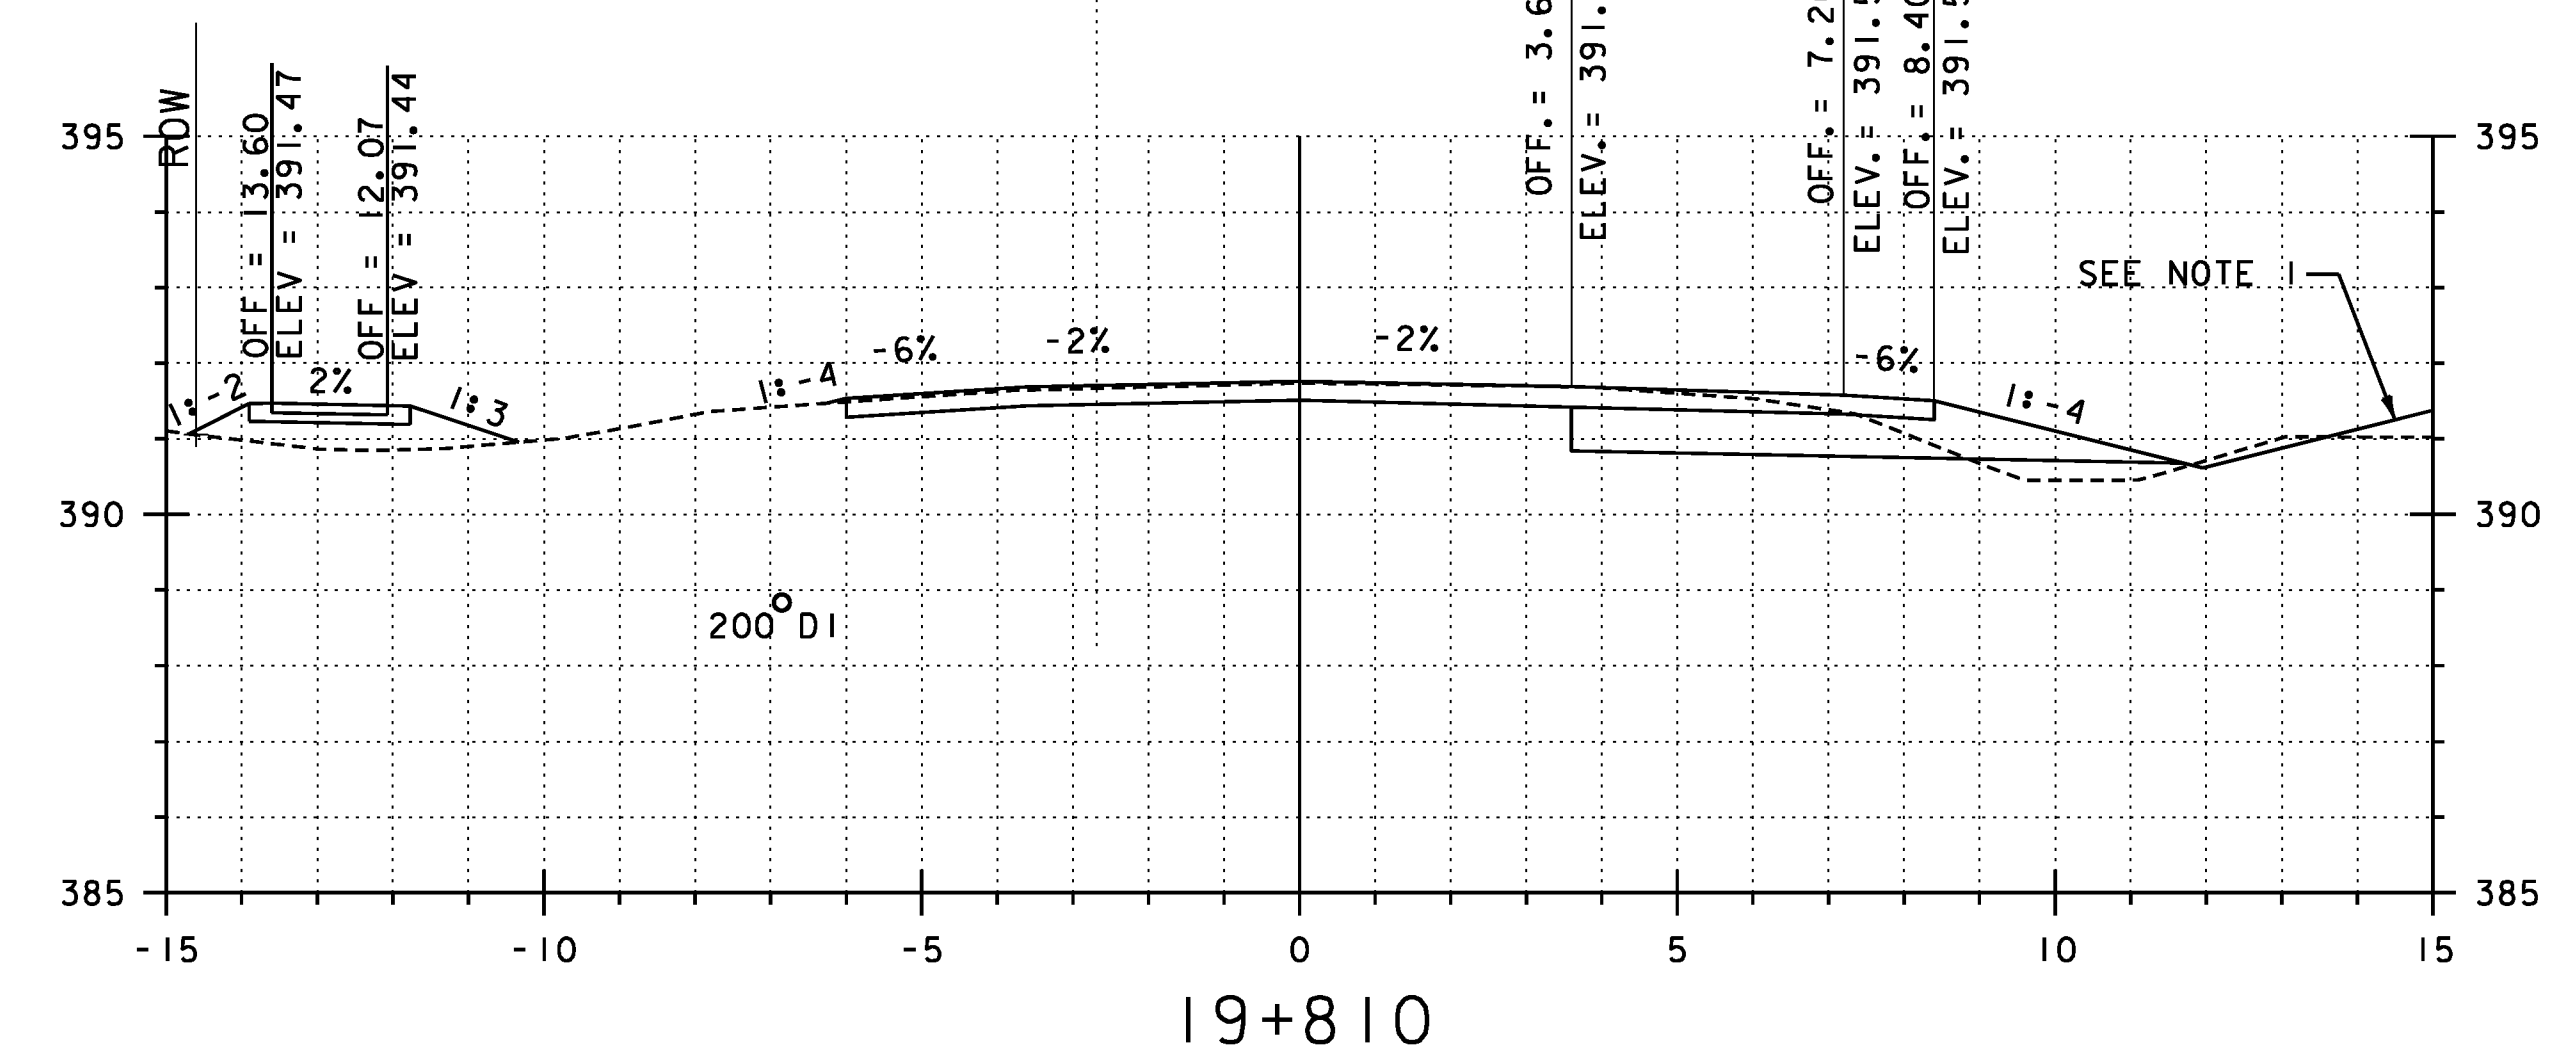
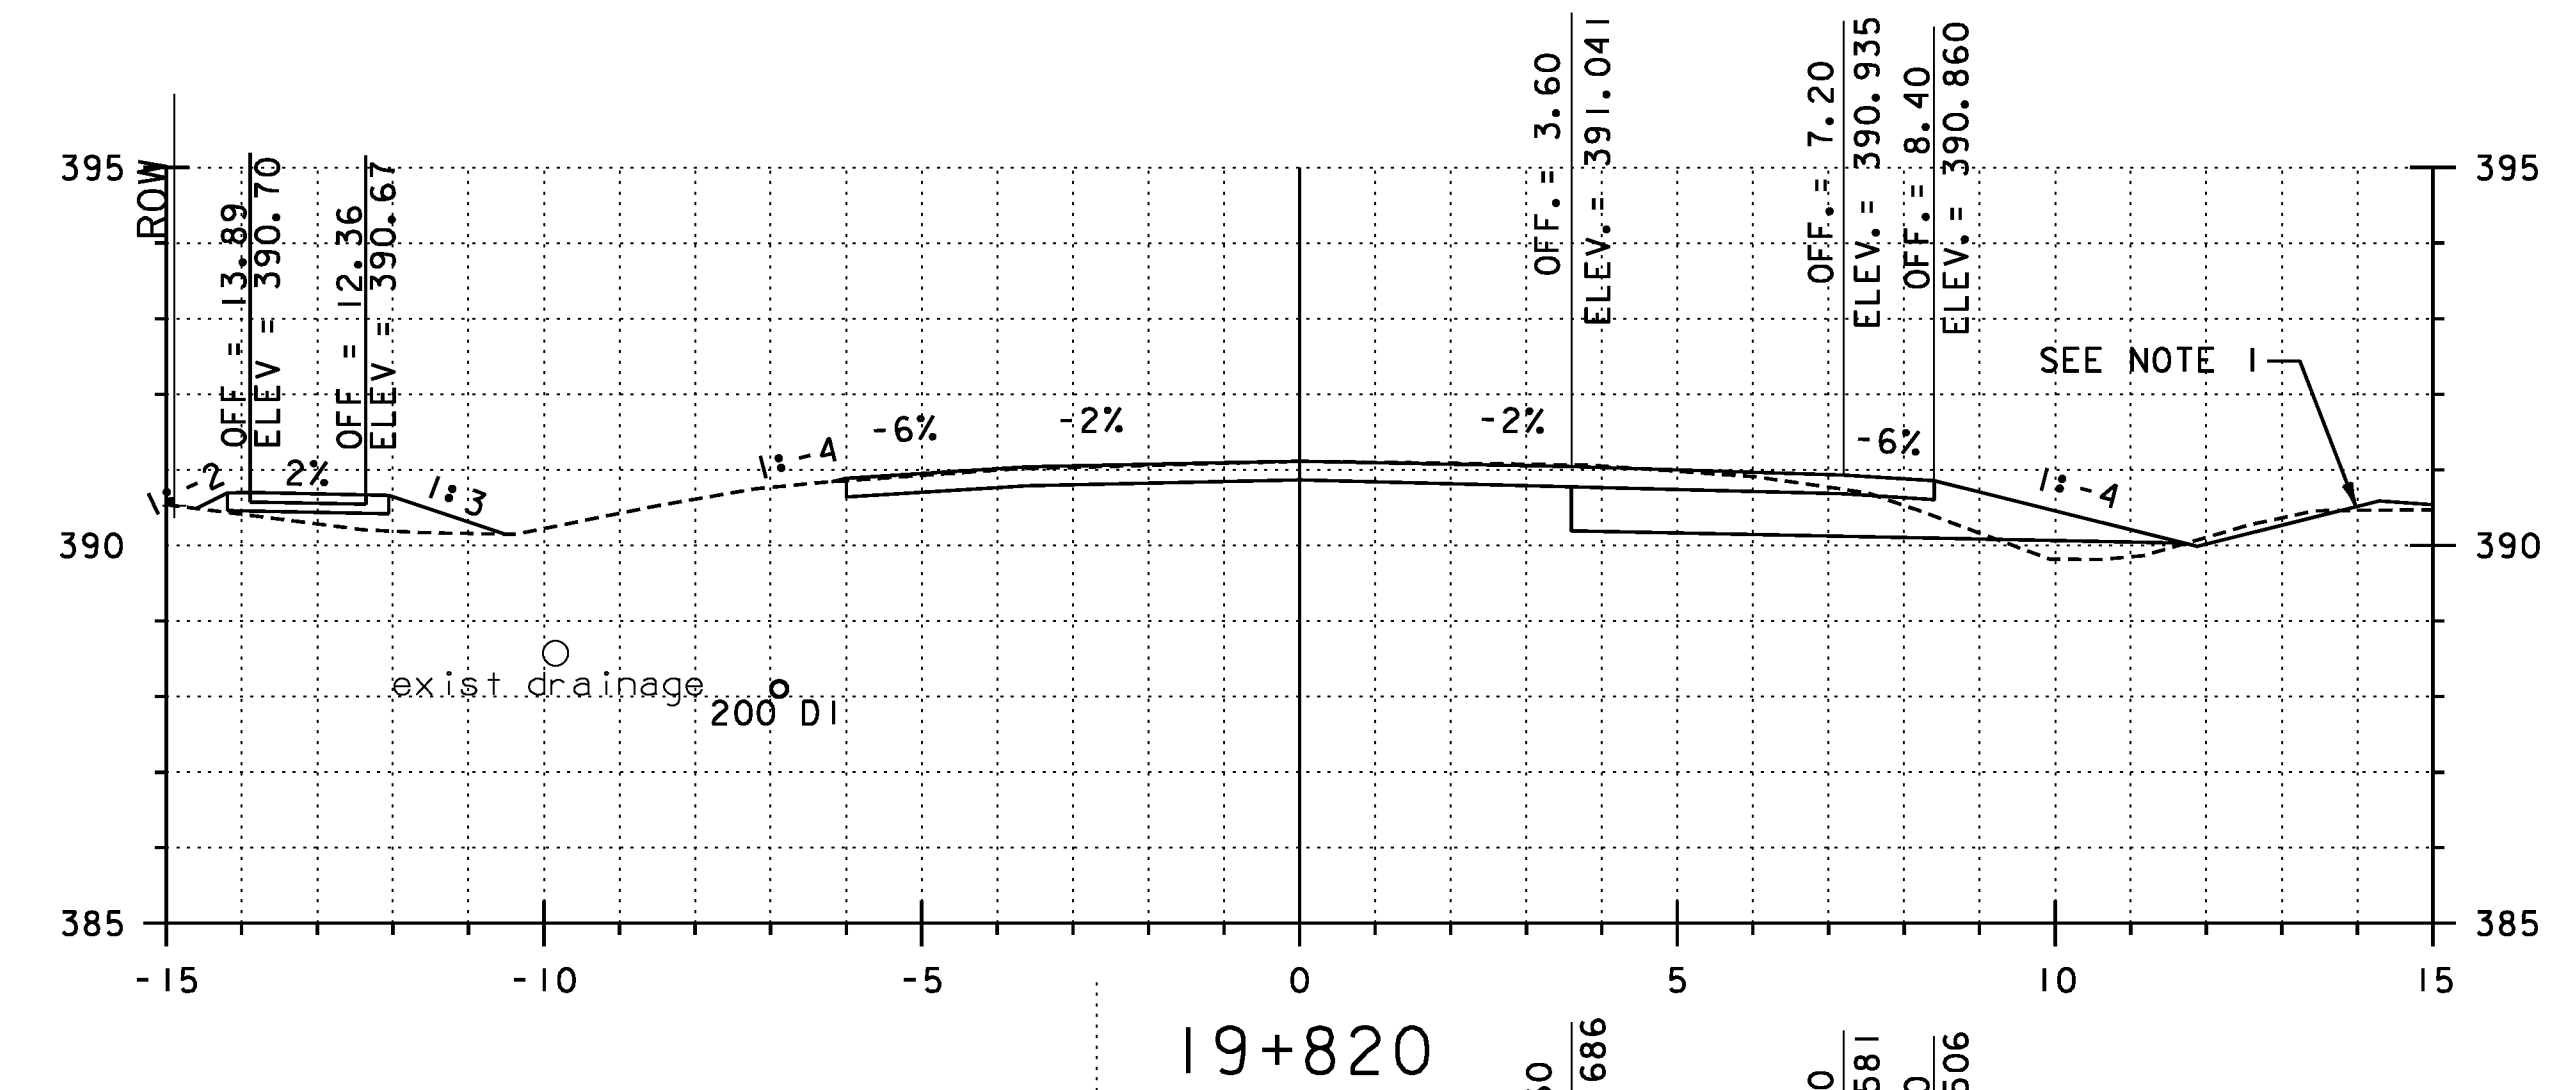
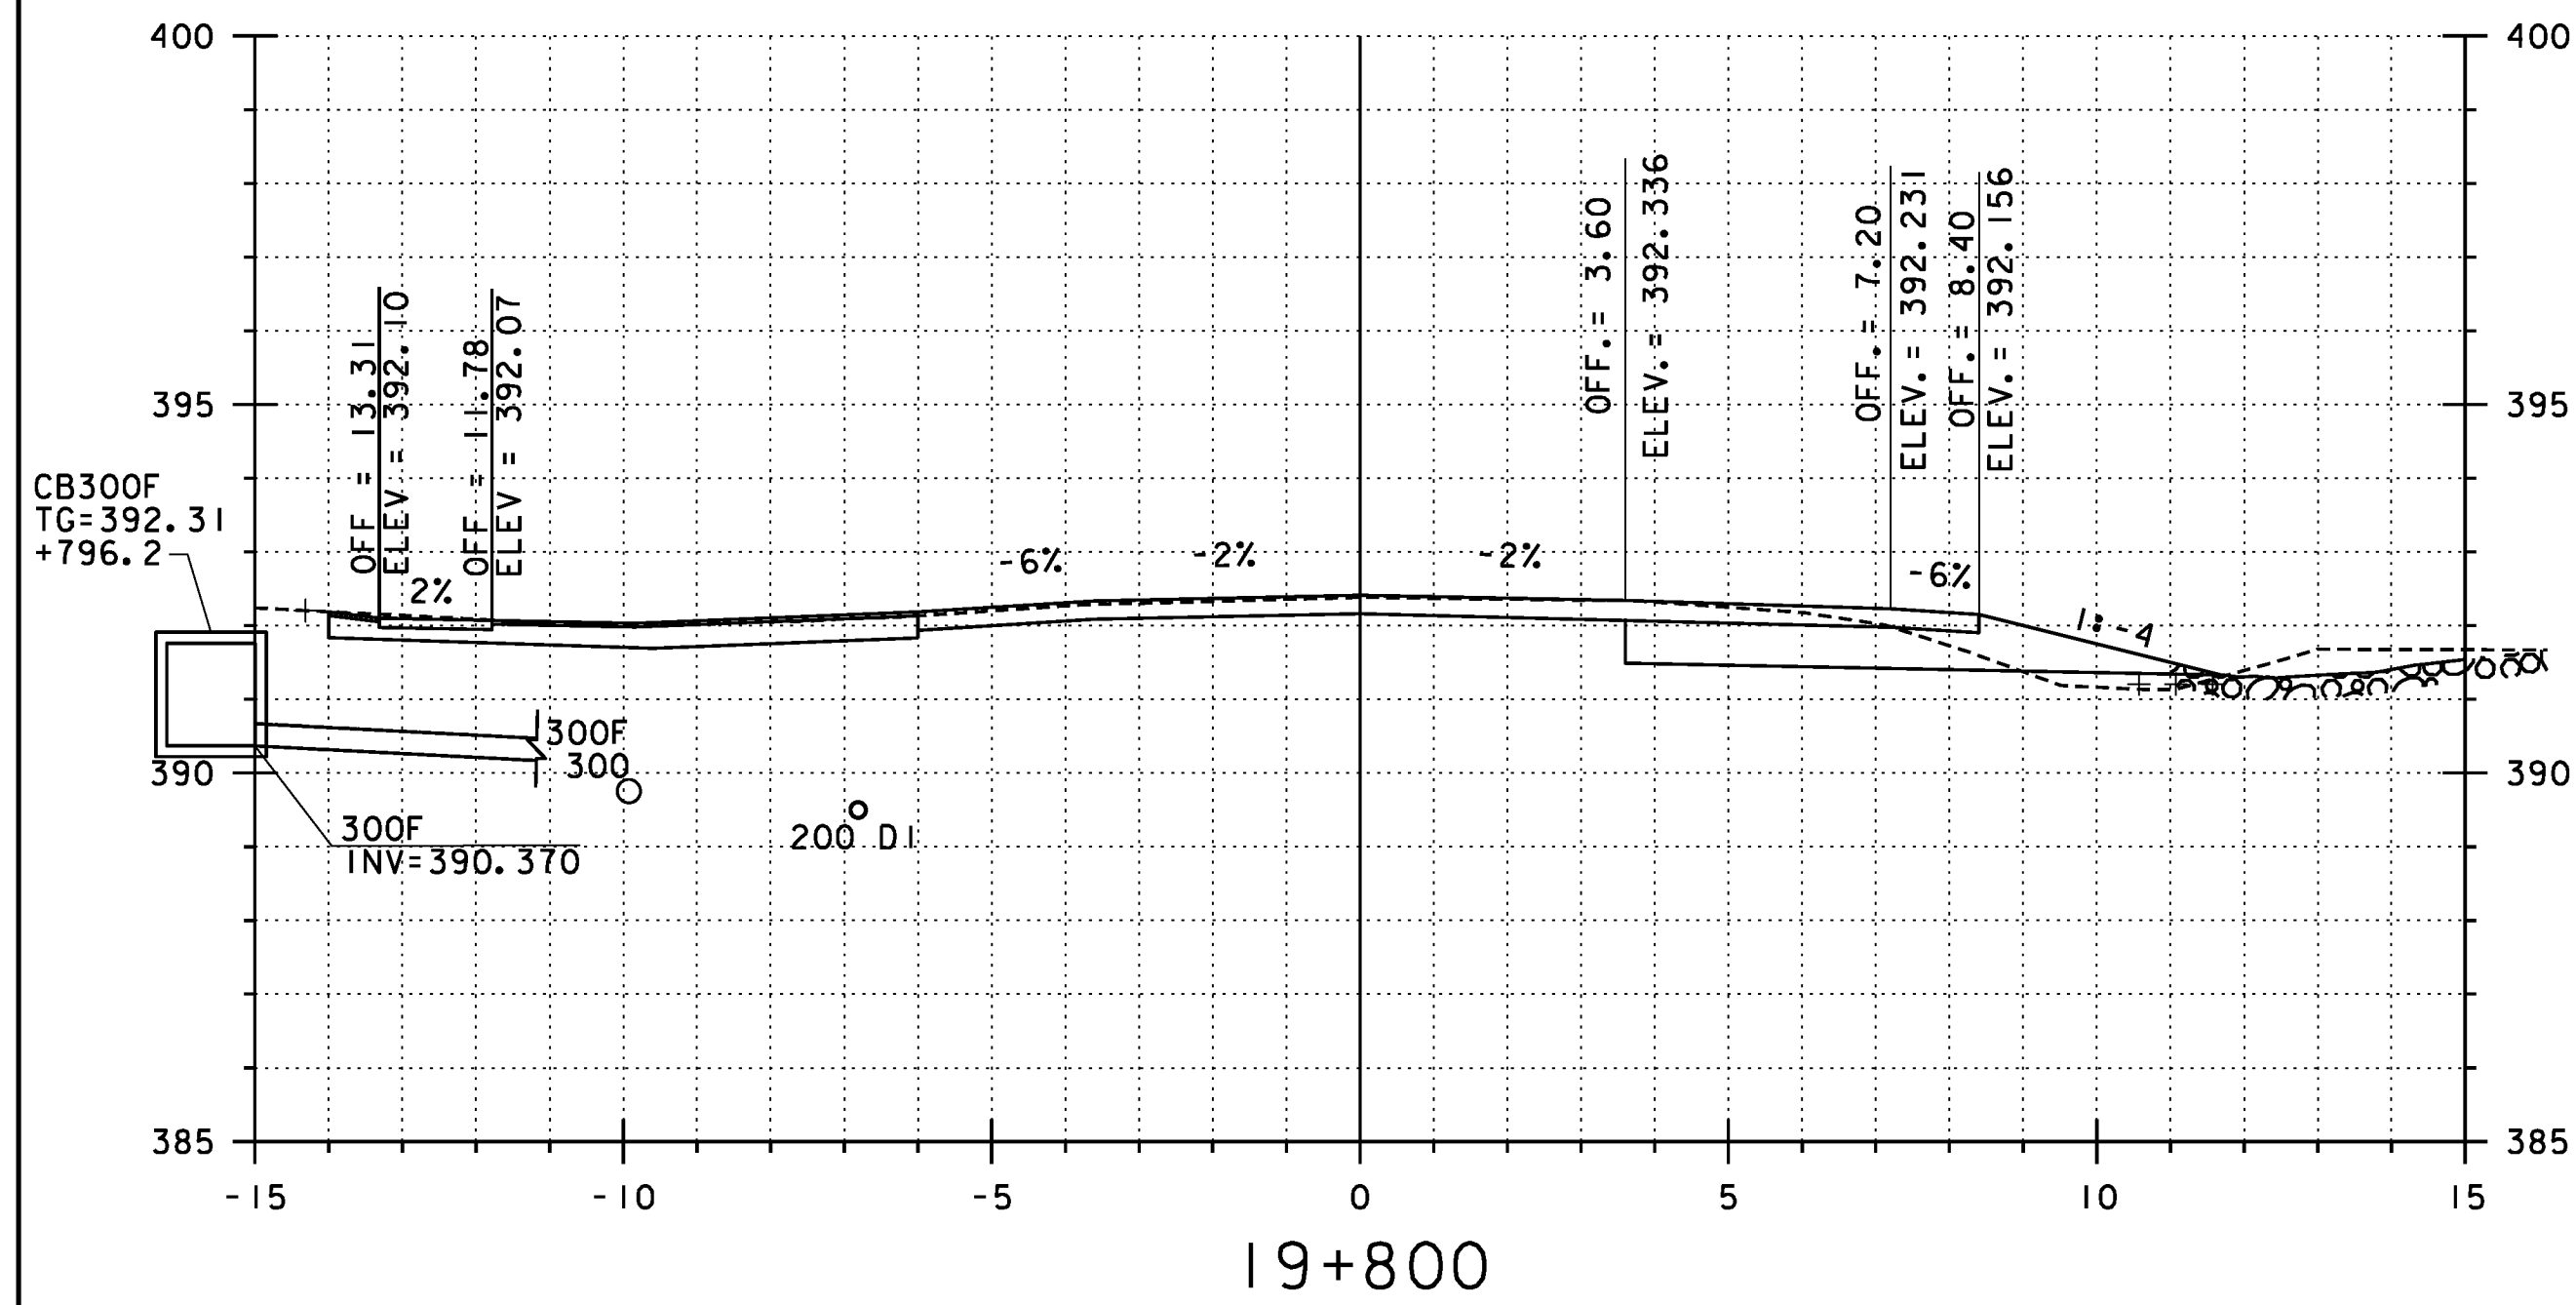
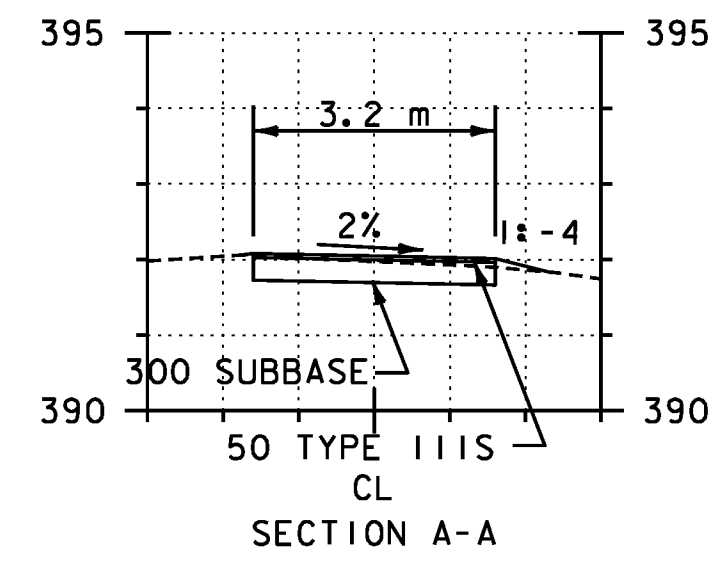


NOTES:
 1. SEE STORMWATER MANAGEMENT DETAILS SWM-1 FOR WET EXTENDED DETENTION POND GRADING INFORMATION.

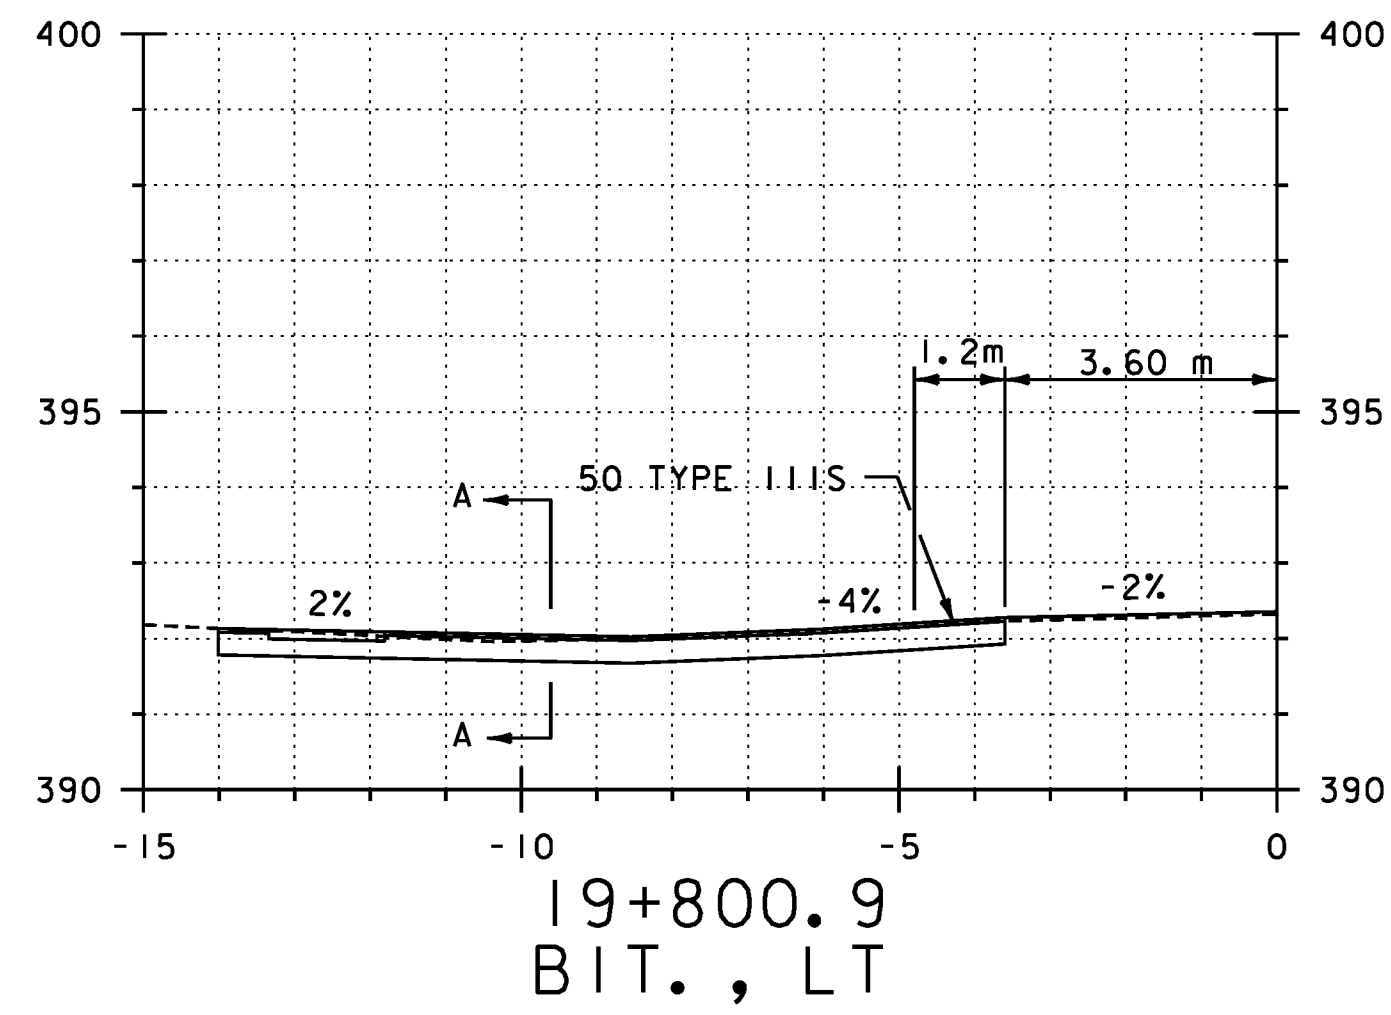

**REPLACEMENT SHEETS
 ISSUED 02/24/12**

STA 19+790 TO 19+820

PROJECT NAME: DANVILLE
 PROJECT NUMBER: F EGC 028-3(32)

FILE NAME: ...\\PlotFiles\133 XS-US2.10m.ptf PLOT DATE: 2/24/2012
 DESIGN SUPERVISOR: GARY SANTY DRAWN BY: STANTEC
 DESIGNED BY: STANTEC CHECKED BY: STANTEC
 US ROUTE 2 CROSS SECTIONS - MLX-35 SHEET 259 OF 306

