
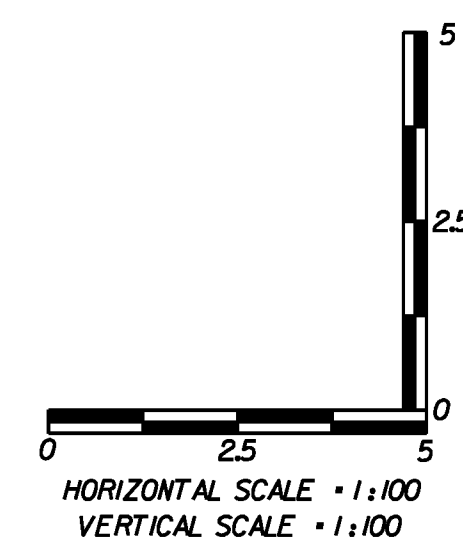


STA. 19+910.000  
 END APPROACH CONSTRUCTION  
 END COLD PLANE/OVERLAY  
 END BOX CUT AND WIDENING  
 MATCH EXISTING

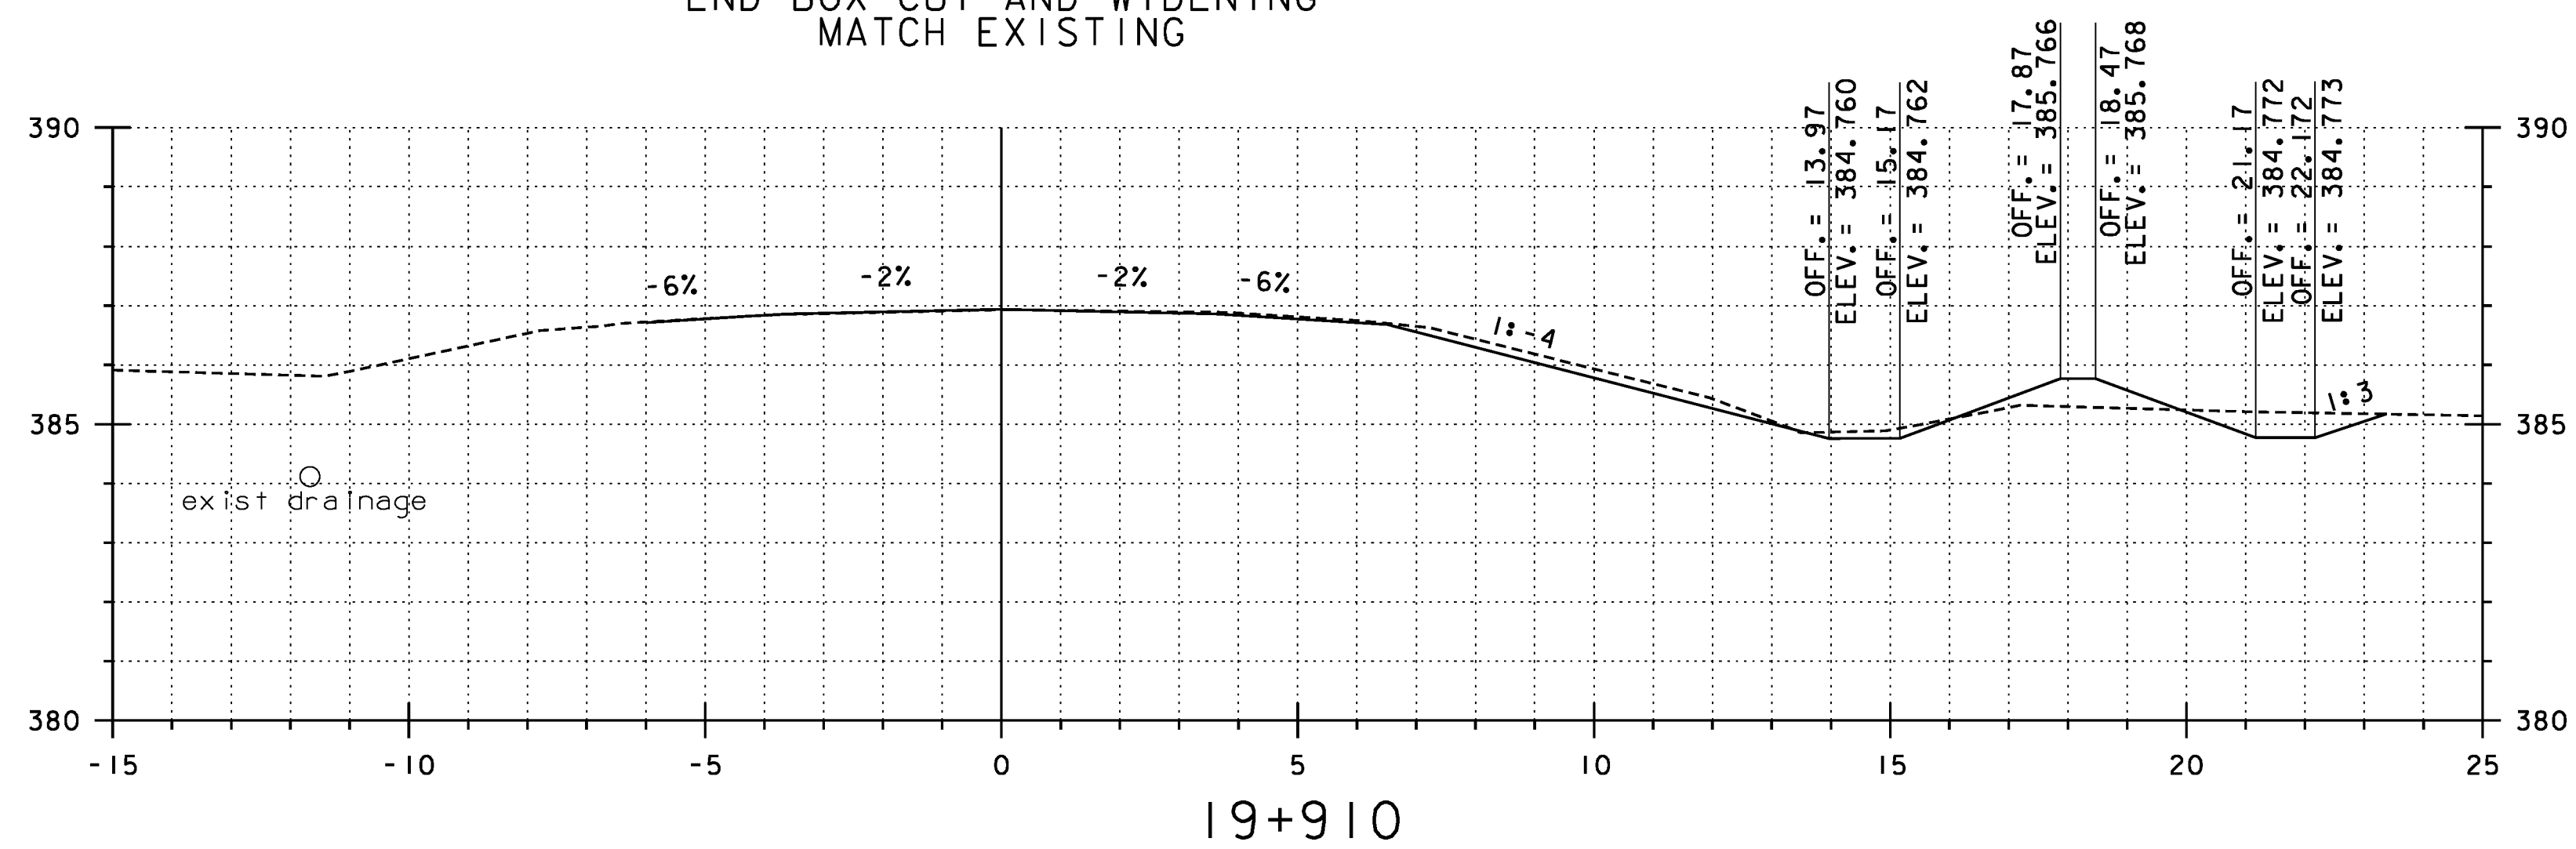

**REPLACEMENT SHEETS  
 ISSUED 02/24/12**

STA 19+910	
PROJECT NAME:	DANVILLE
PROJECT NUMBER:	F EGC 028-3(32)
FILE NAME:	...\\PlotFiles\133 XS-US2.iom.ptf
DESIGN SUPERVISOR:	GARY SANTY
DESIGNED BY:	STANTEC
US ROUTE 2 CROSS SECTIONS - MLX-39	
PLOT DATE:	2/24/2012
DRAWN BY:	STANTEC
CHECKED BY:	STANTEC
SHEET	263 OF 306