



1+040

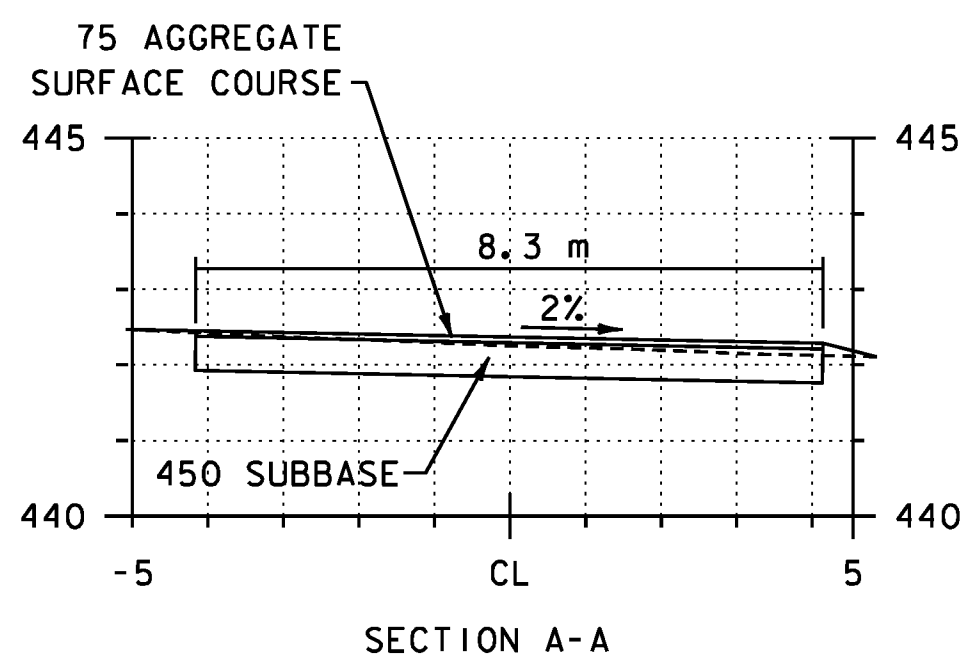


SECTION A-A

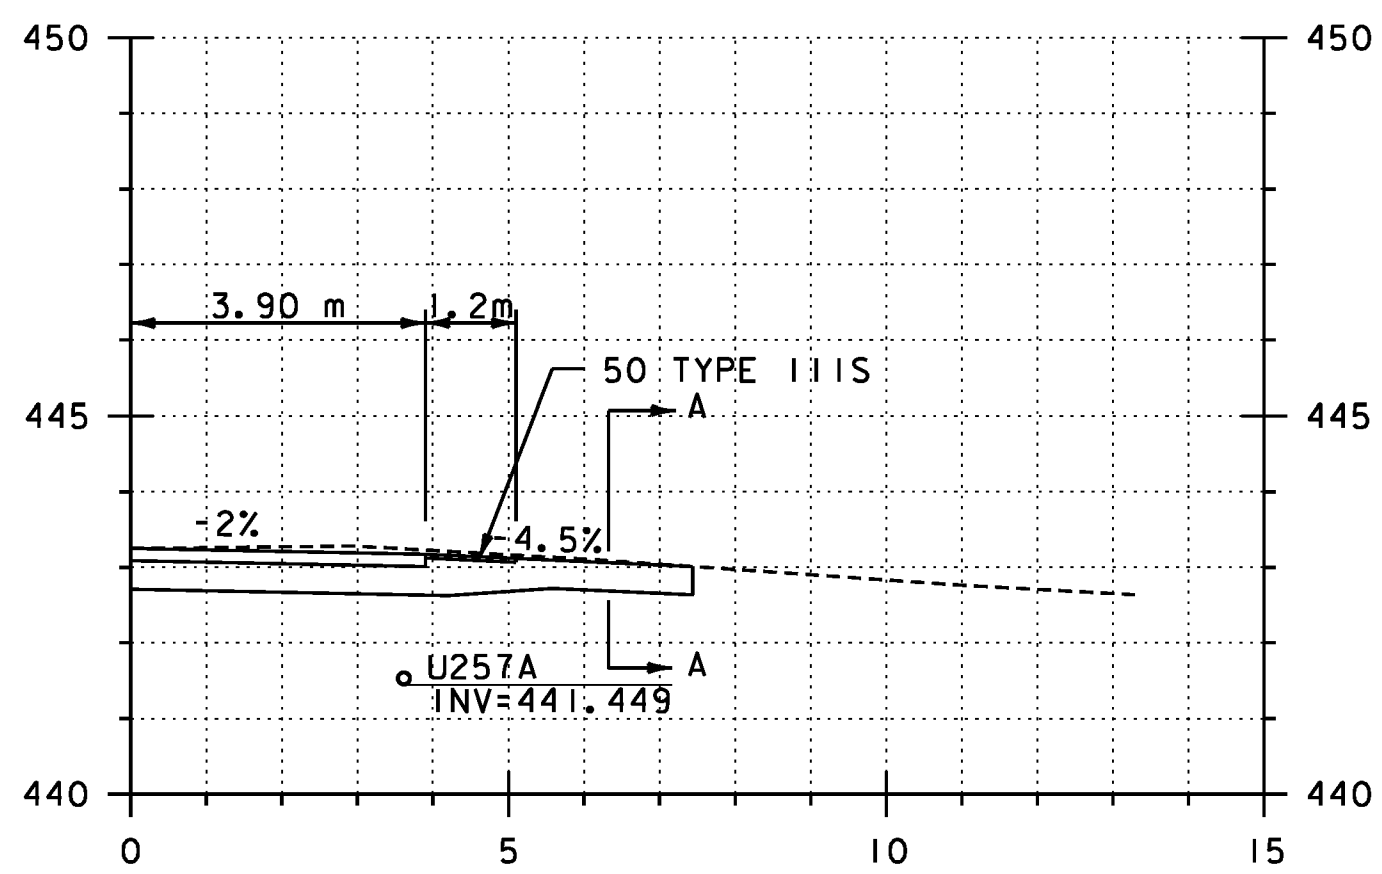


1+036.6
GRAVEL, RT

WALDEN HILL ROAD STA. 1+067.500
BEGIN APPROACH CONSTRUCTION

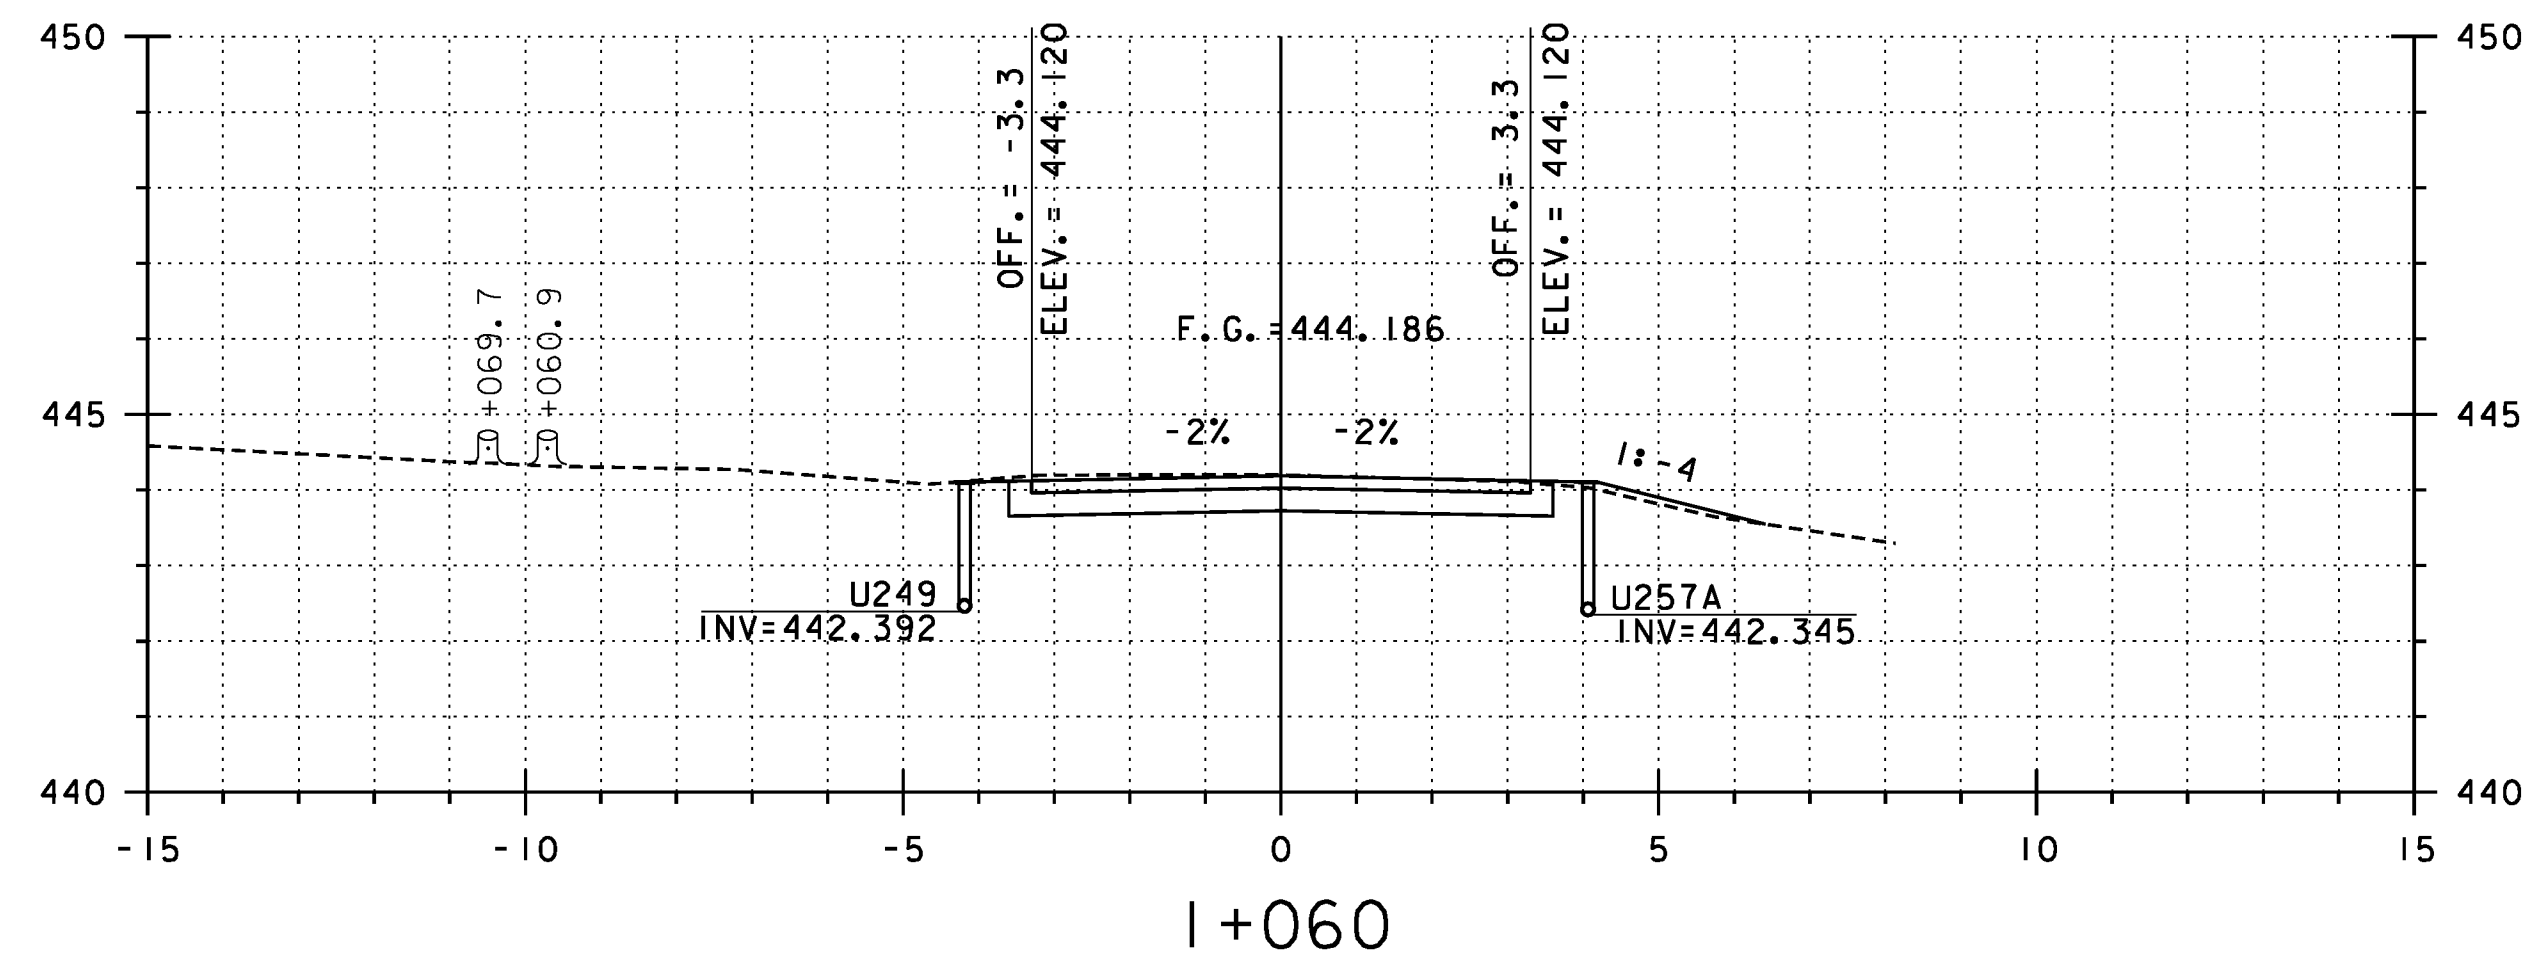

1+060

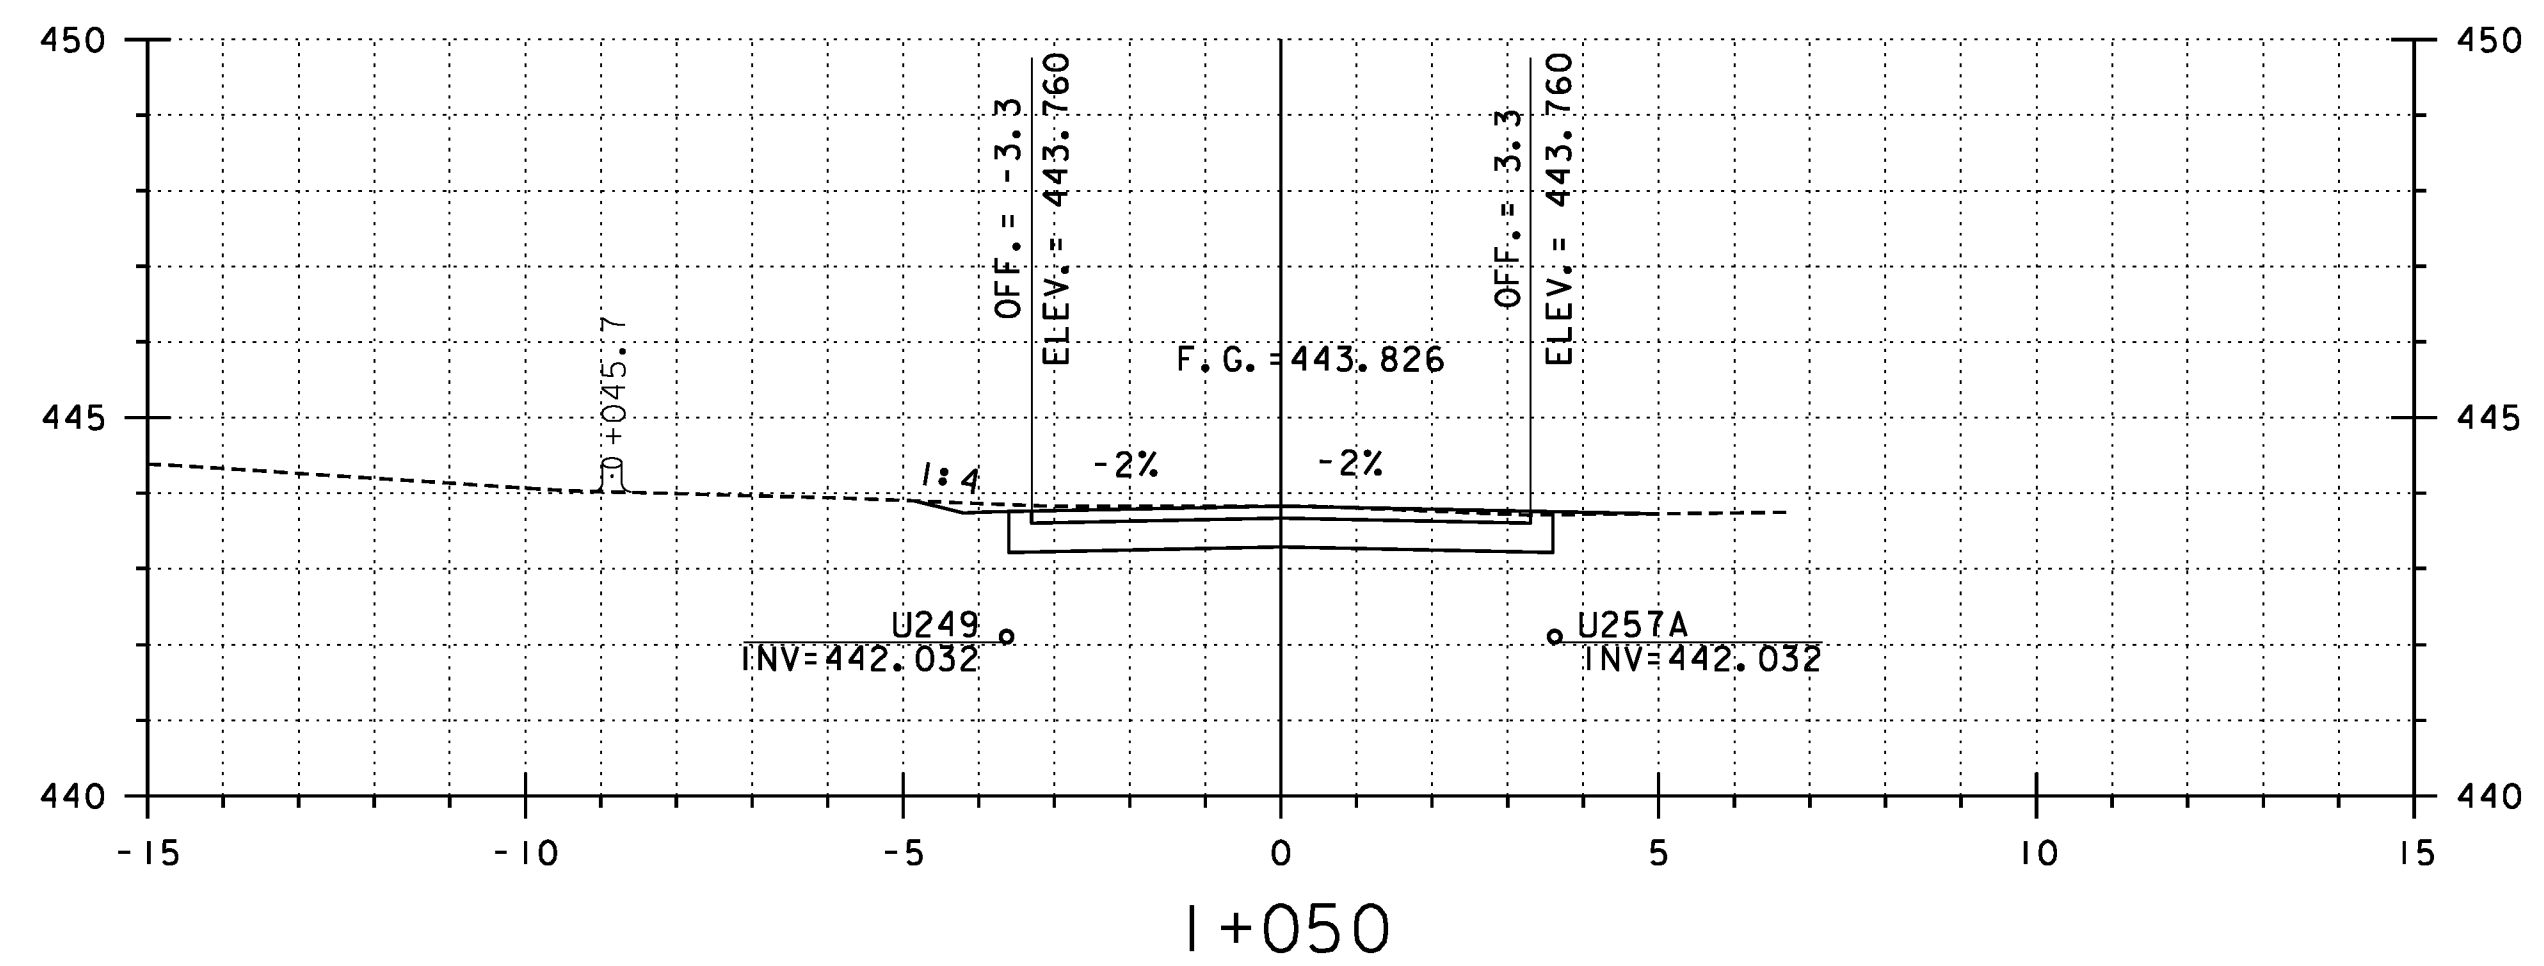

1+050

**REPLACEMENT SHEETS
ISSUED 02/24/12**

STA 1+036.6 TO 1+067.500

PROJECT NAME: DANVILLE
PROJECT NUMBER: F EGC 028-3(32)

FILE NAME: ...\\134 XS-Walden_I0m.pxf PLOT DATE: 2/24/2012
DESIGN SUPERVISOR: GARY SANTY DRAWN BY: STANTEC
DESIGNED BY: STANTEC CHECKED BY: STANTEC
WALDEN HILL CROSS SECTIONS - WHX-2 SHEET 265 OF 306

