
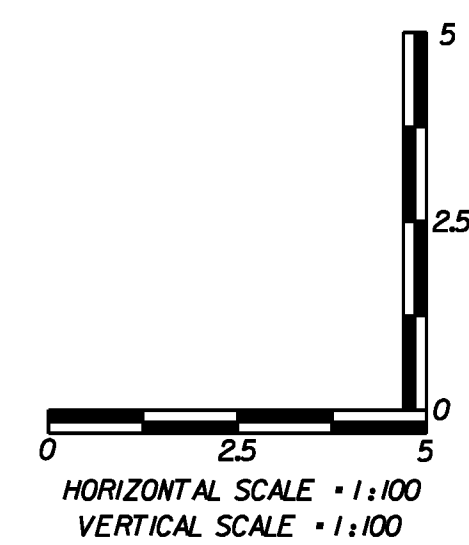


WALDEN HILL ROAD STA. 1+075.500  
END APPROACH CONSTRUCTION  
MATCH EXISTING

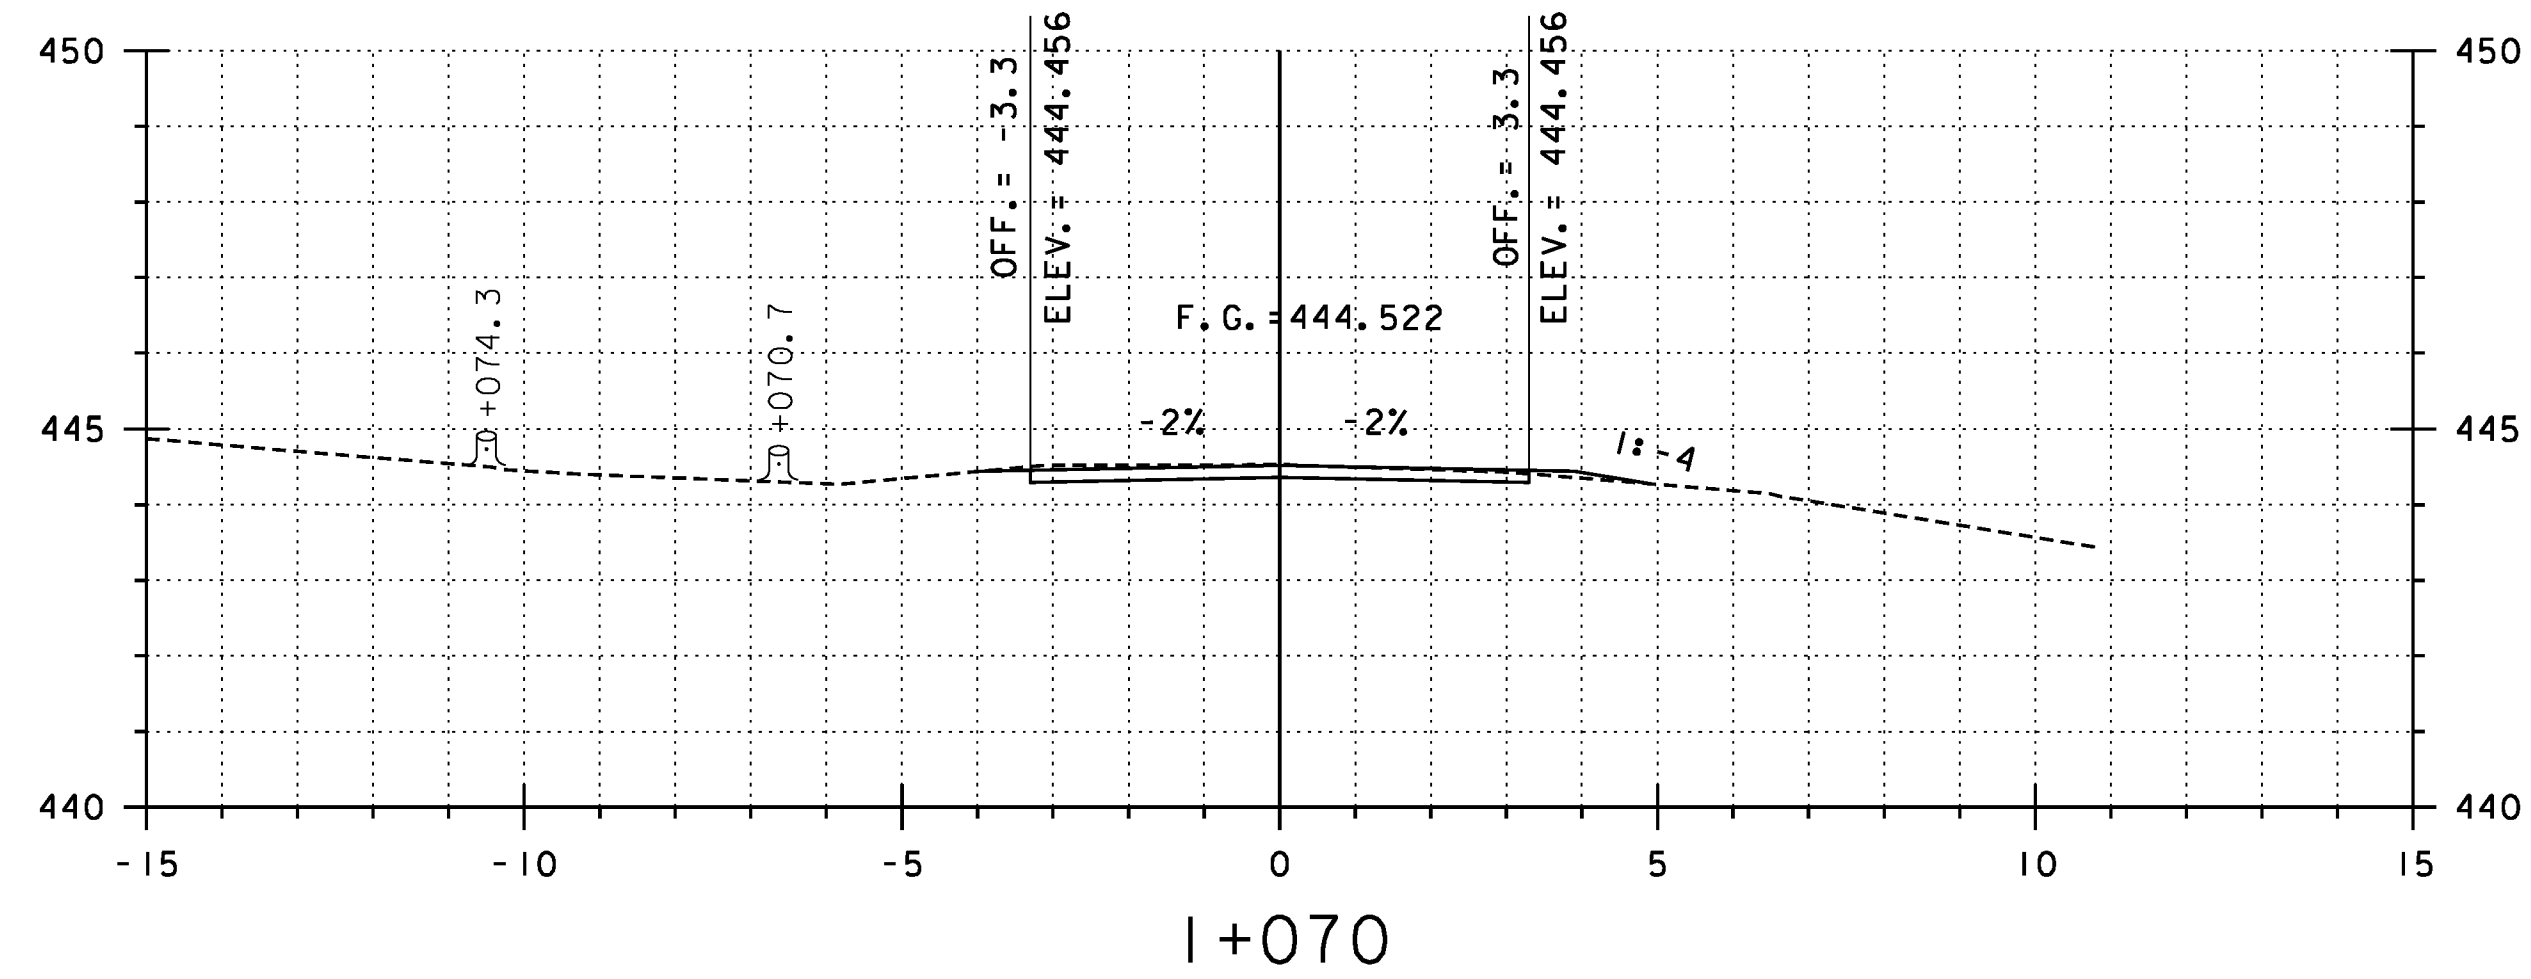

**REPLACEMENT SHEETS  
ISSUED 02/24/12**

STA 1+070 TO 1+076

PROJECT NAME: DANVILLE  
PROJECT NUMBER: F EGC 028-3(32)

FILE NAME: ...\\134 XS-Walden\_I0m.pxf PLOT DATE: 2/24/2012  
DESIGN SUPERVISOR: GARY SANTY DRAWN BY: STANTEC  
DESIGNED BY: STANTEC CHECKED BY: STANTEC  
WALDEN HILL CROSS SECTIONS - WHX-3 SHEET 266 OF 306

