


PARK STREET STA. 2+145.691=
PEACHAM ROAD STA. 4+106.333

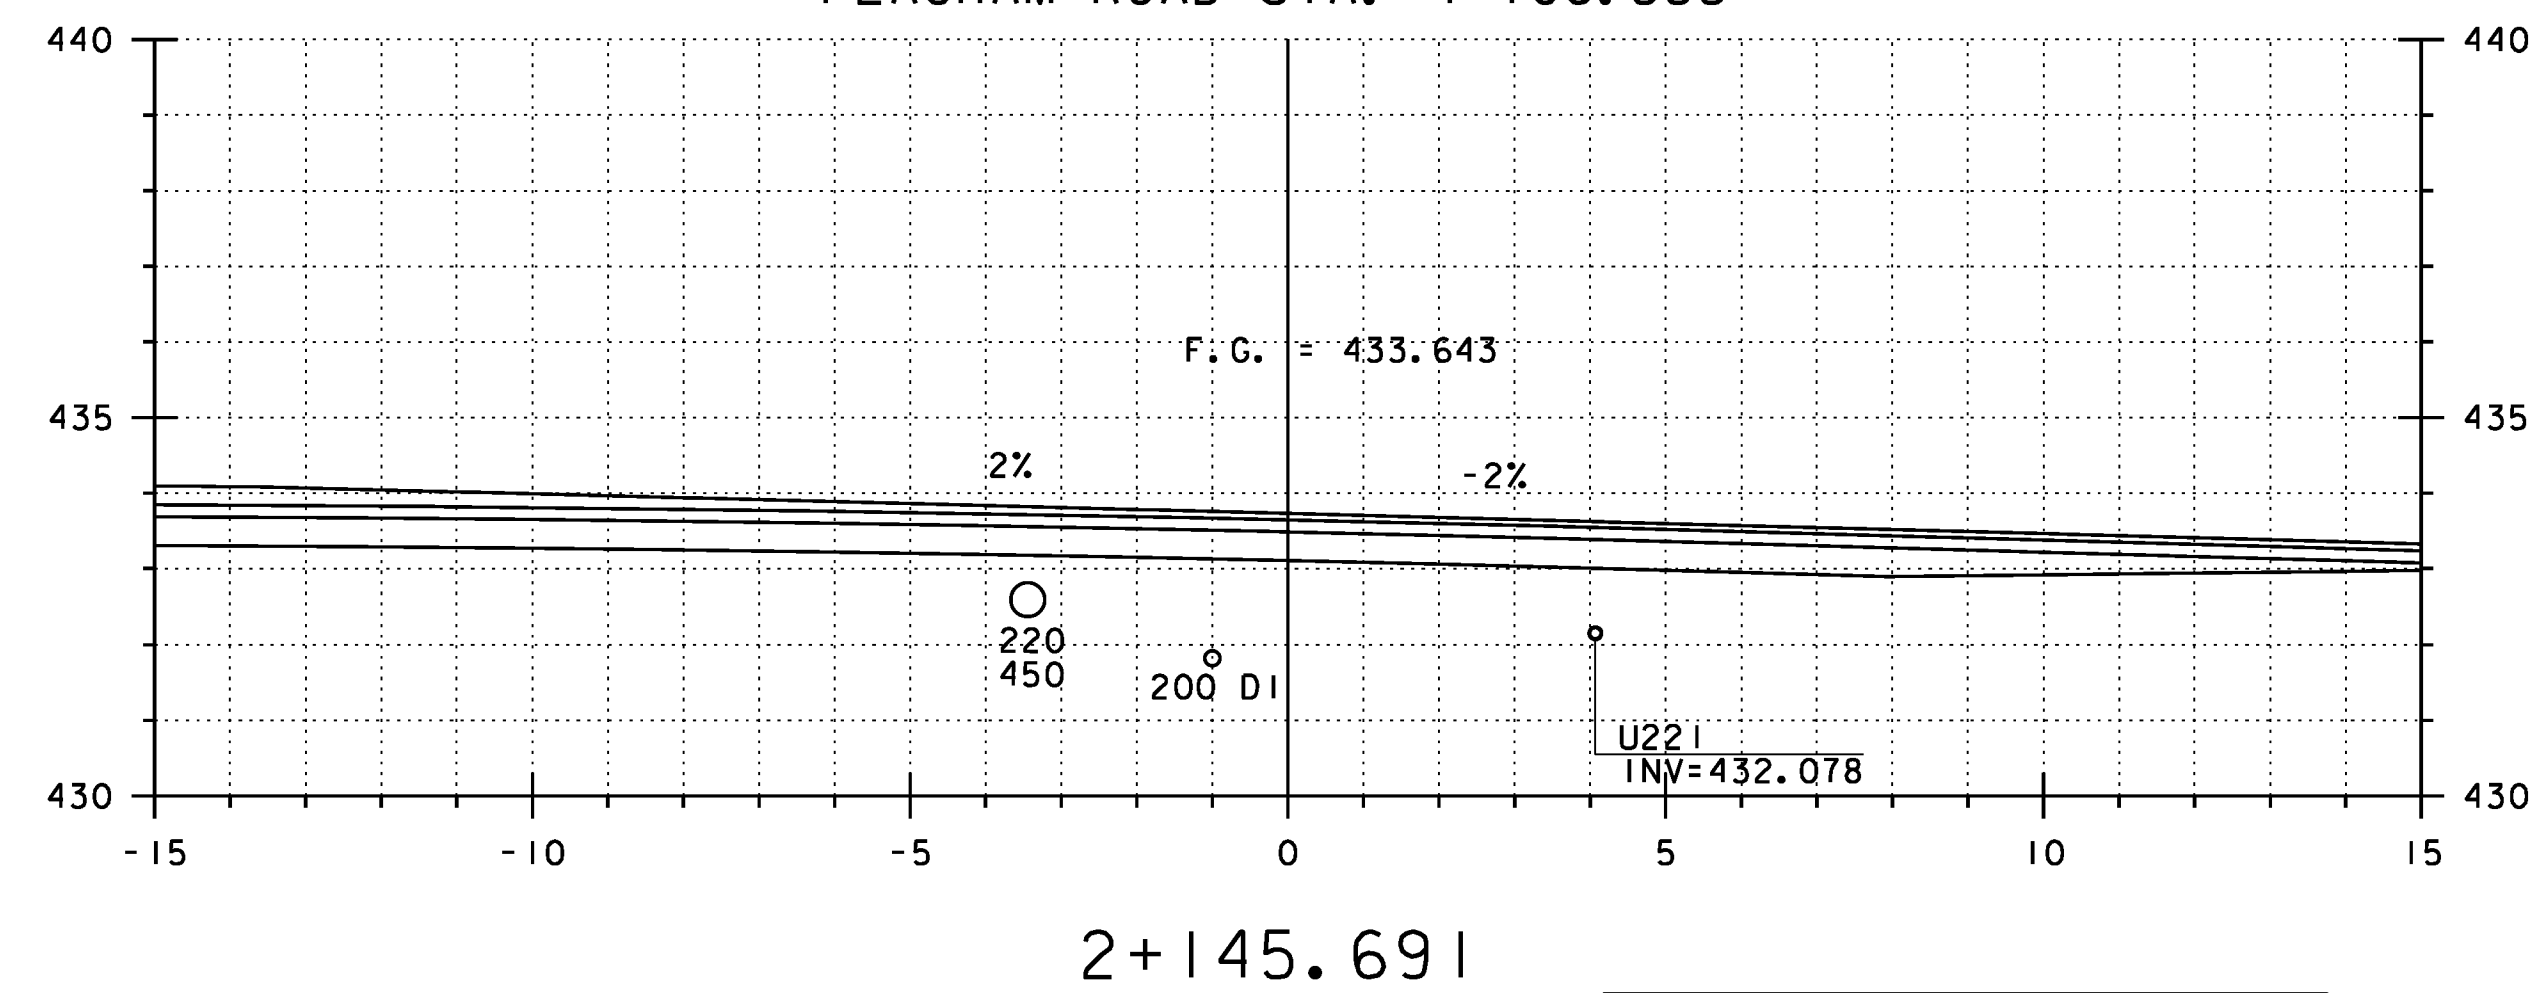

**REPLACEMENT SHEETS
ISSUED 02/24/12**

STA 2+120 TO 2+150

PROJECT NAME: DANVILLE
PROJECT NUMBER: F EGC 028-3(32)

FILE NAME: ...PlotFiles\135 XS-Park_10m.ptf PLOT DATE: 2/24/2012
DESIGN SUPERVISOR: GARY SANTY DRAWN BY: STANTEC
DESIGNED BY: STANTEC CHECKED BY: STANTEC
PARK STREET CROSS SECTIONS - PSX-4 SHEET 270 OF 306

