
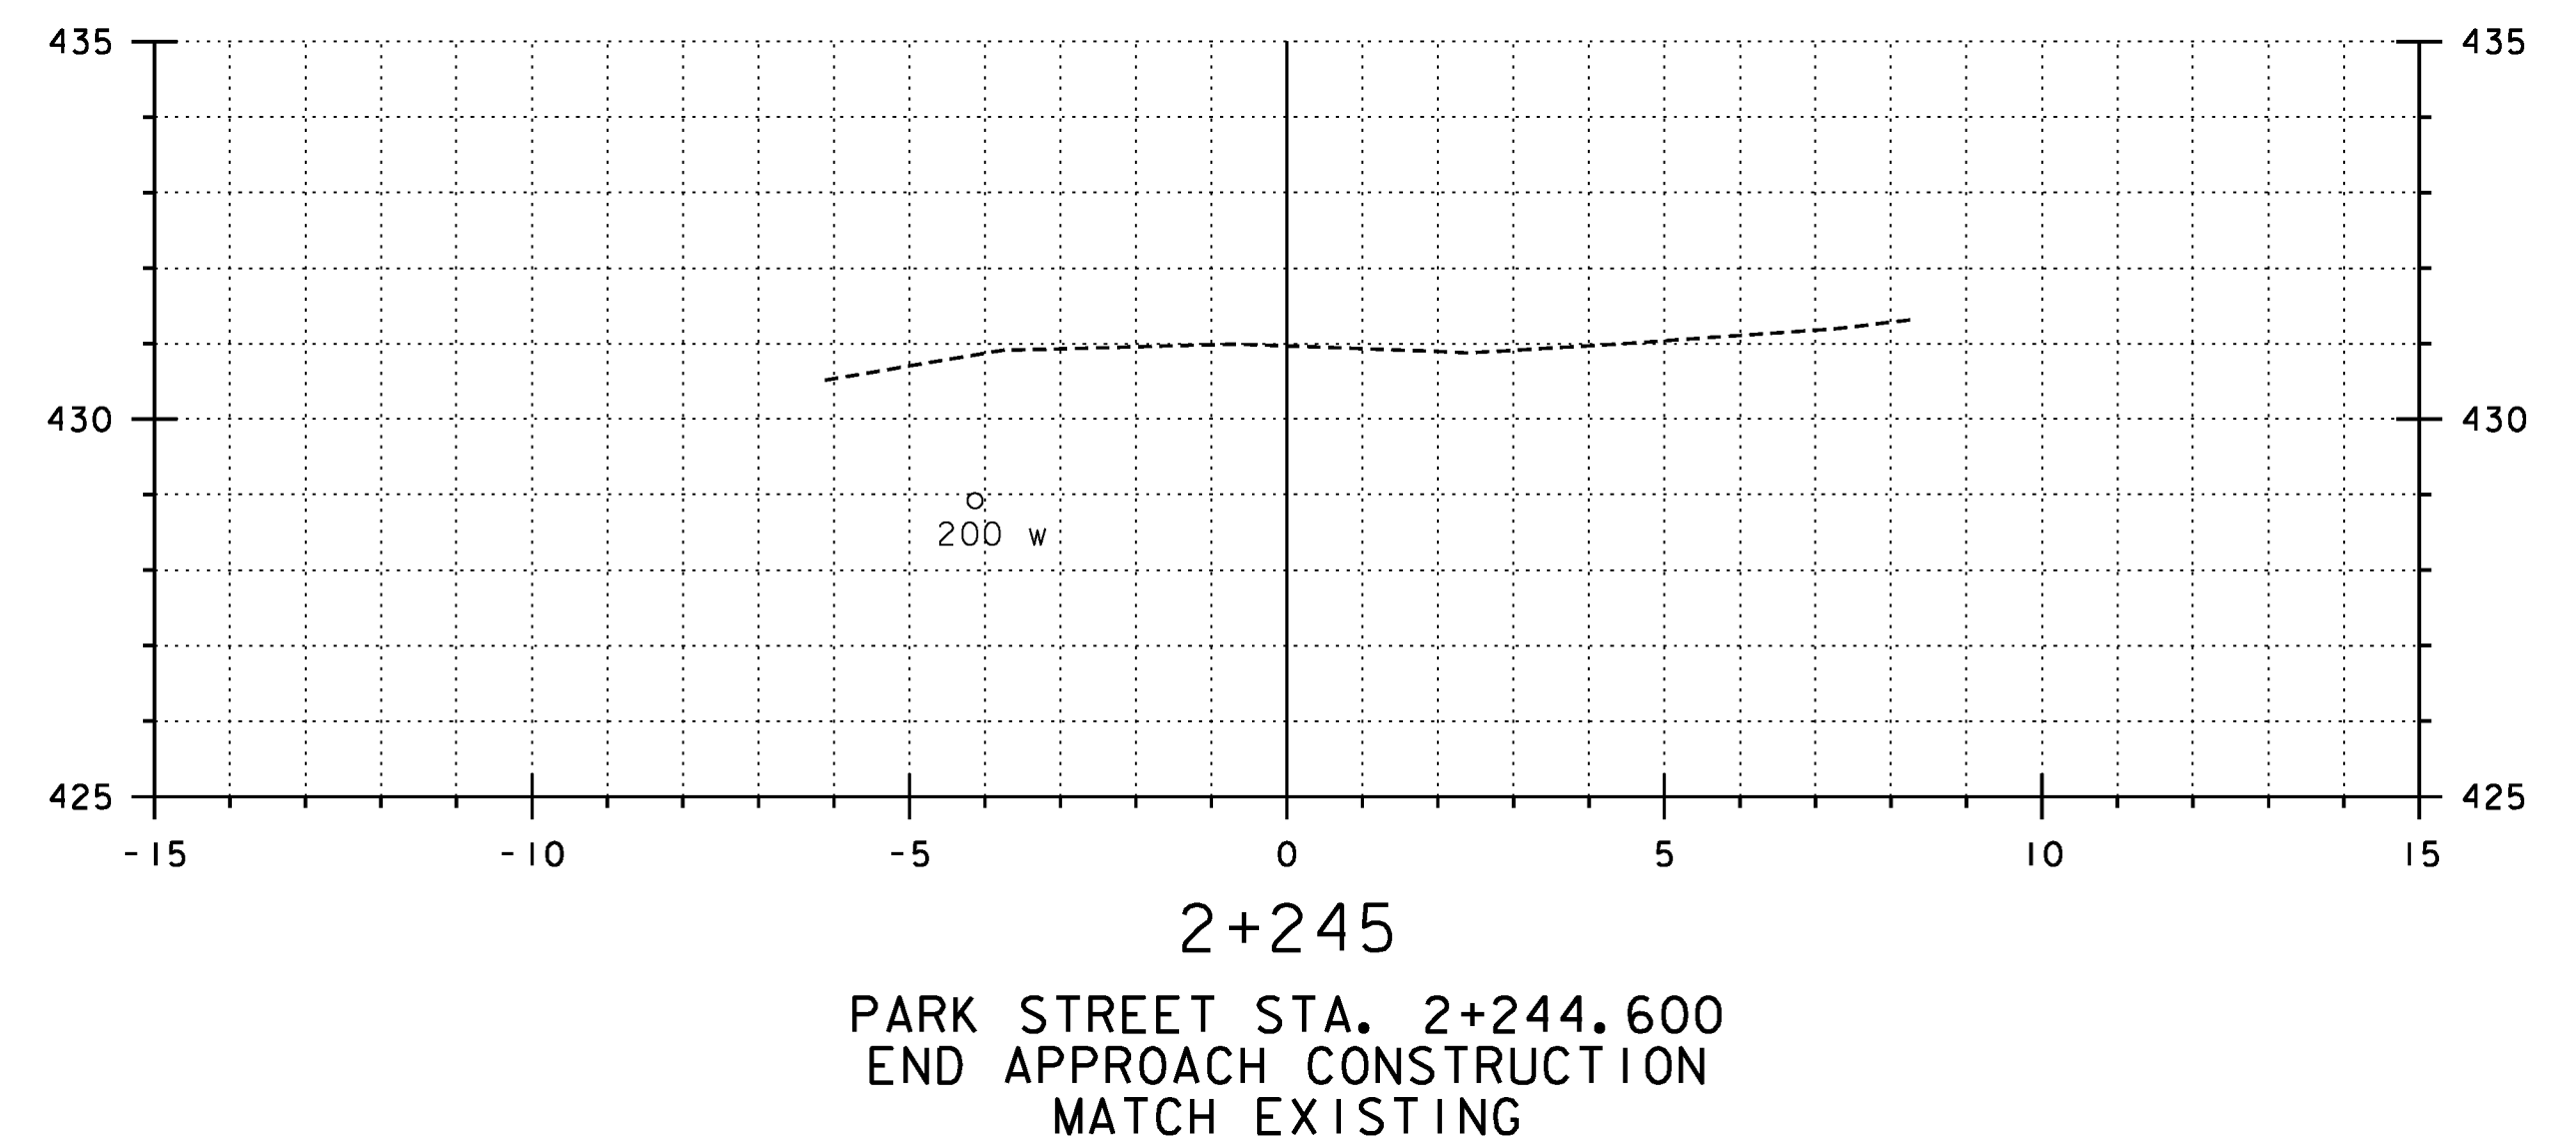


PARK STREET STA. 2+236.600
BEGIN APPROACH CONSTRUCTION

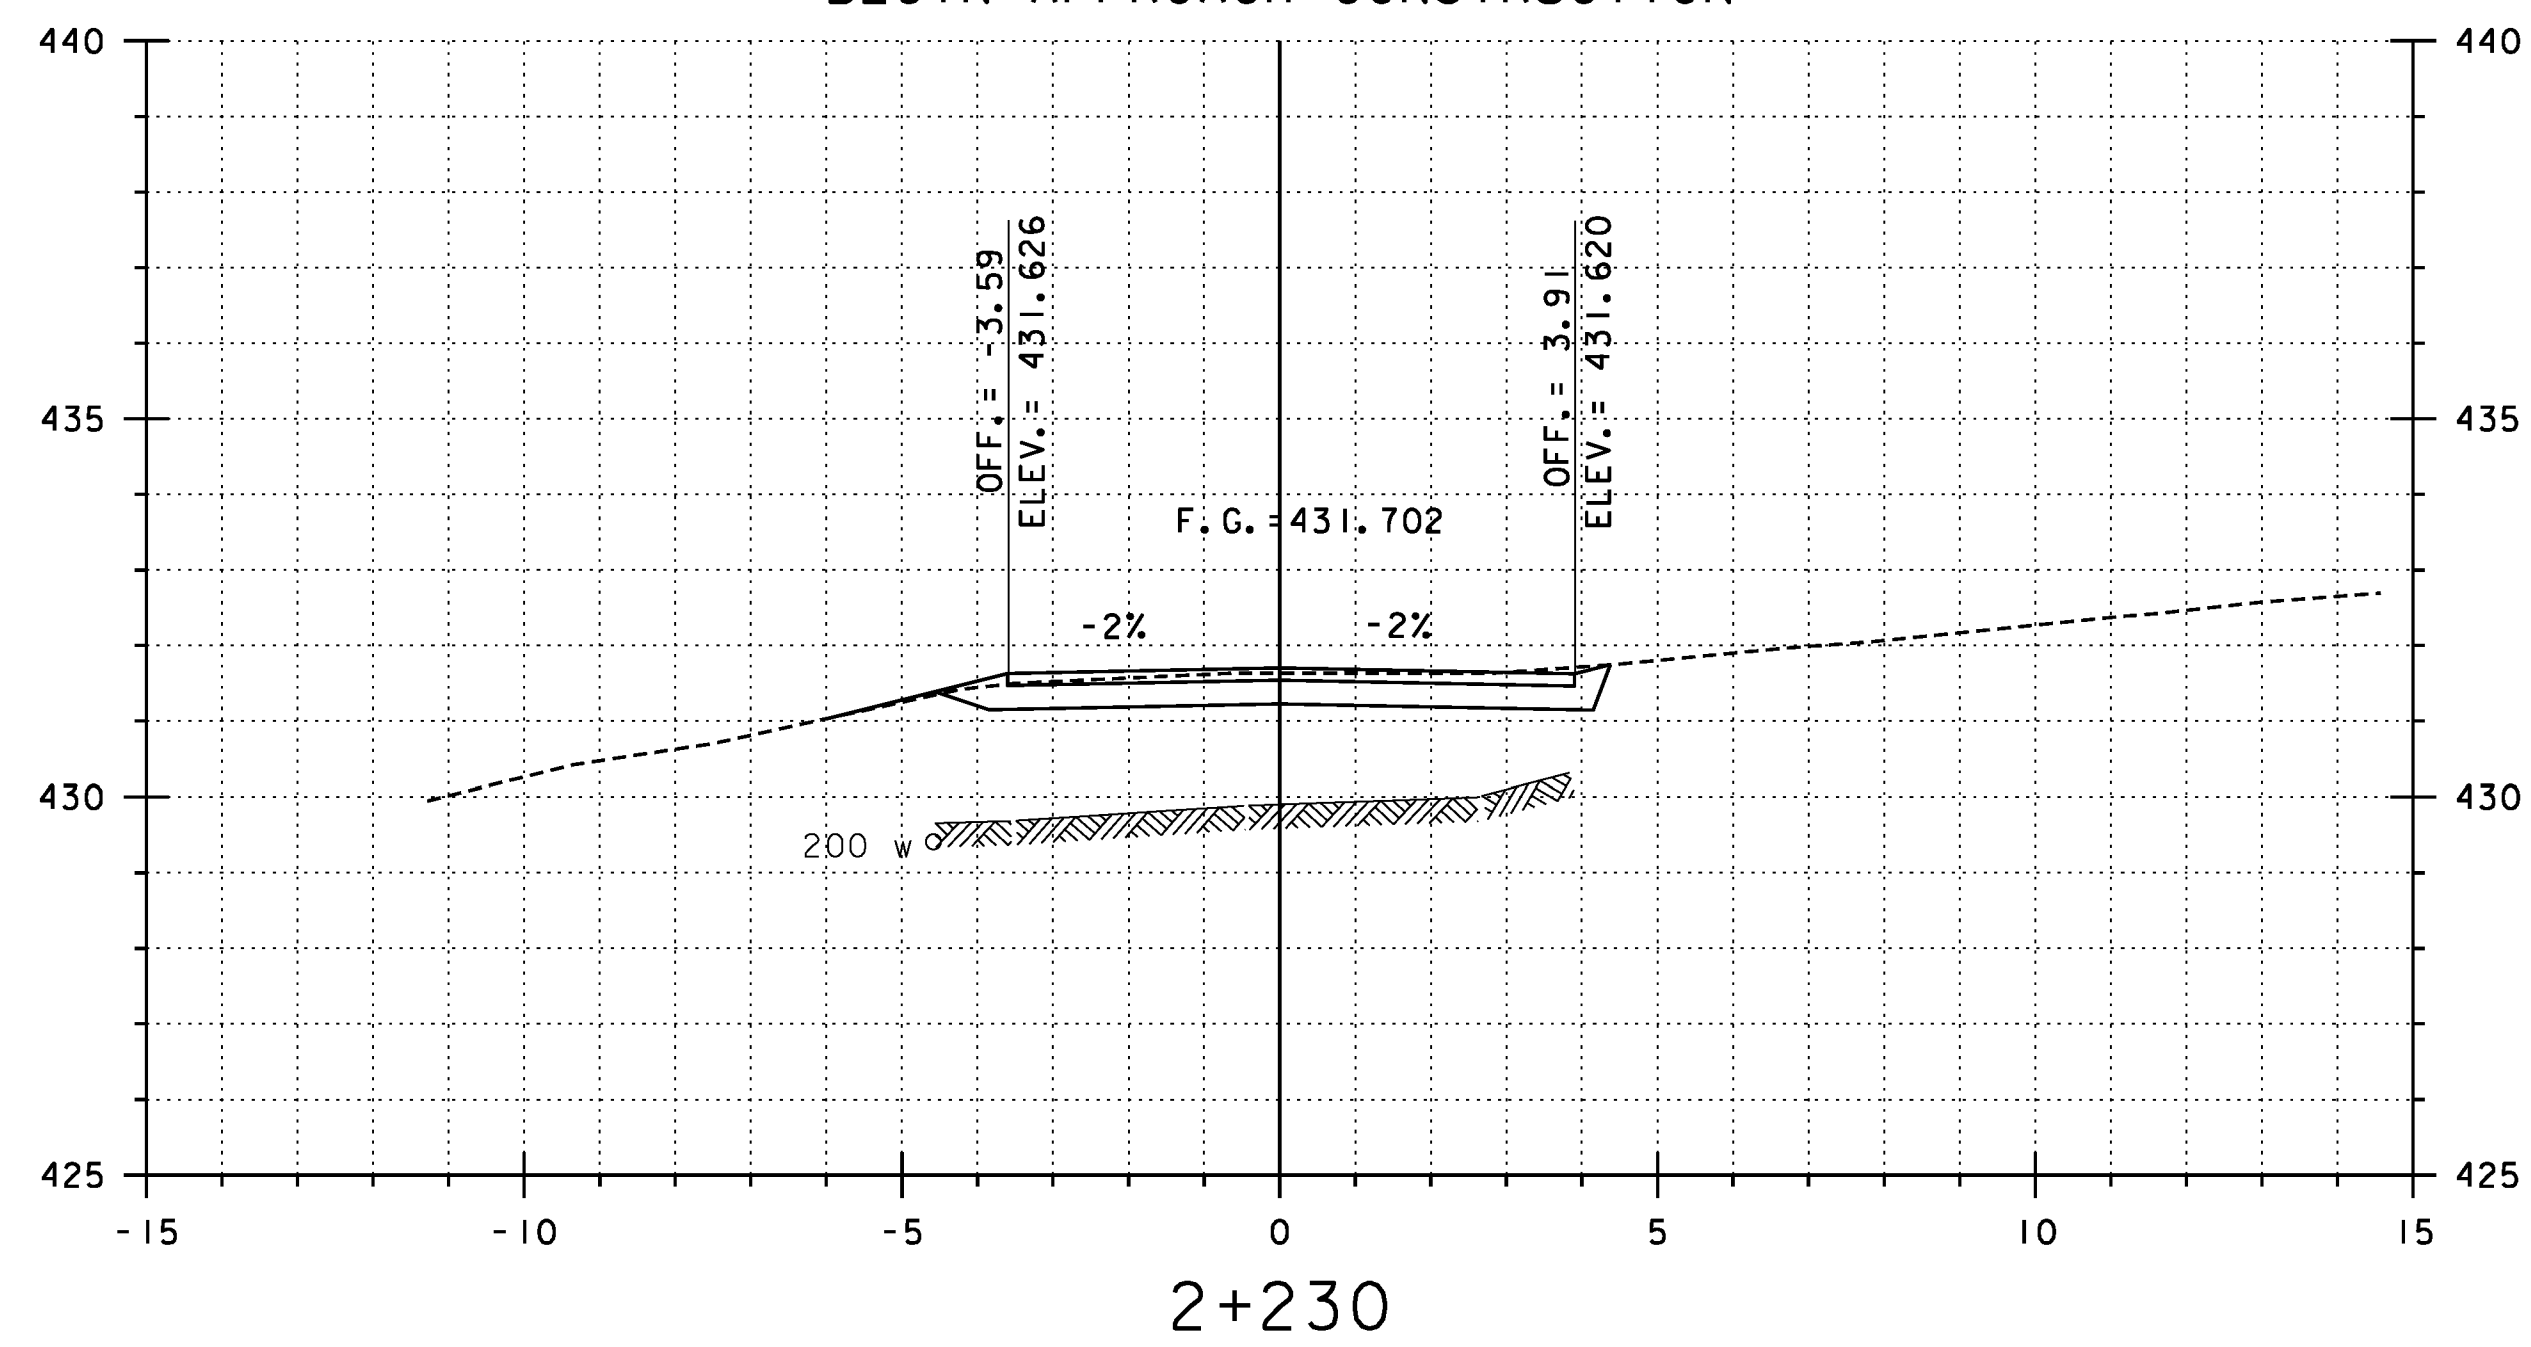

2+245
PARK STREET STA. 2+244.600
END APPROACH CONSTRUCTION
MATCH EXISTING

**REPLACEMENT SHEETS
ISSUED 02/24/12**

STA 2+230 TO 2+245

PROJECT NAME: DANVILLE
PROJECT NUMBER: F EGC 028-3(32)

FILE NAME: ...\\PlotFiles\135 XS-Park_10m.ptf PLOT DATE: 2/24/2012
DESIGN SUPERVISOR: GARY SANTY DRAWN BY: STANTEC
DESIGNED BY: STANTEC CHECKED BY: STANTEC
PARK STREET CROSS SECTIONS - PSX-7 SHEET 273 OF 306

