
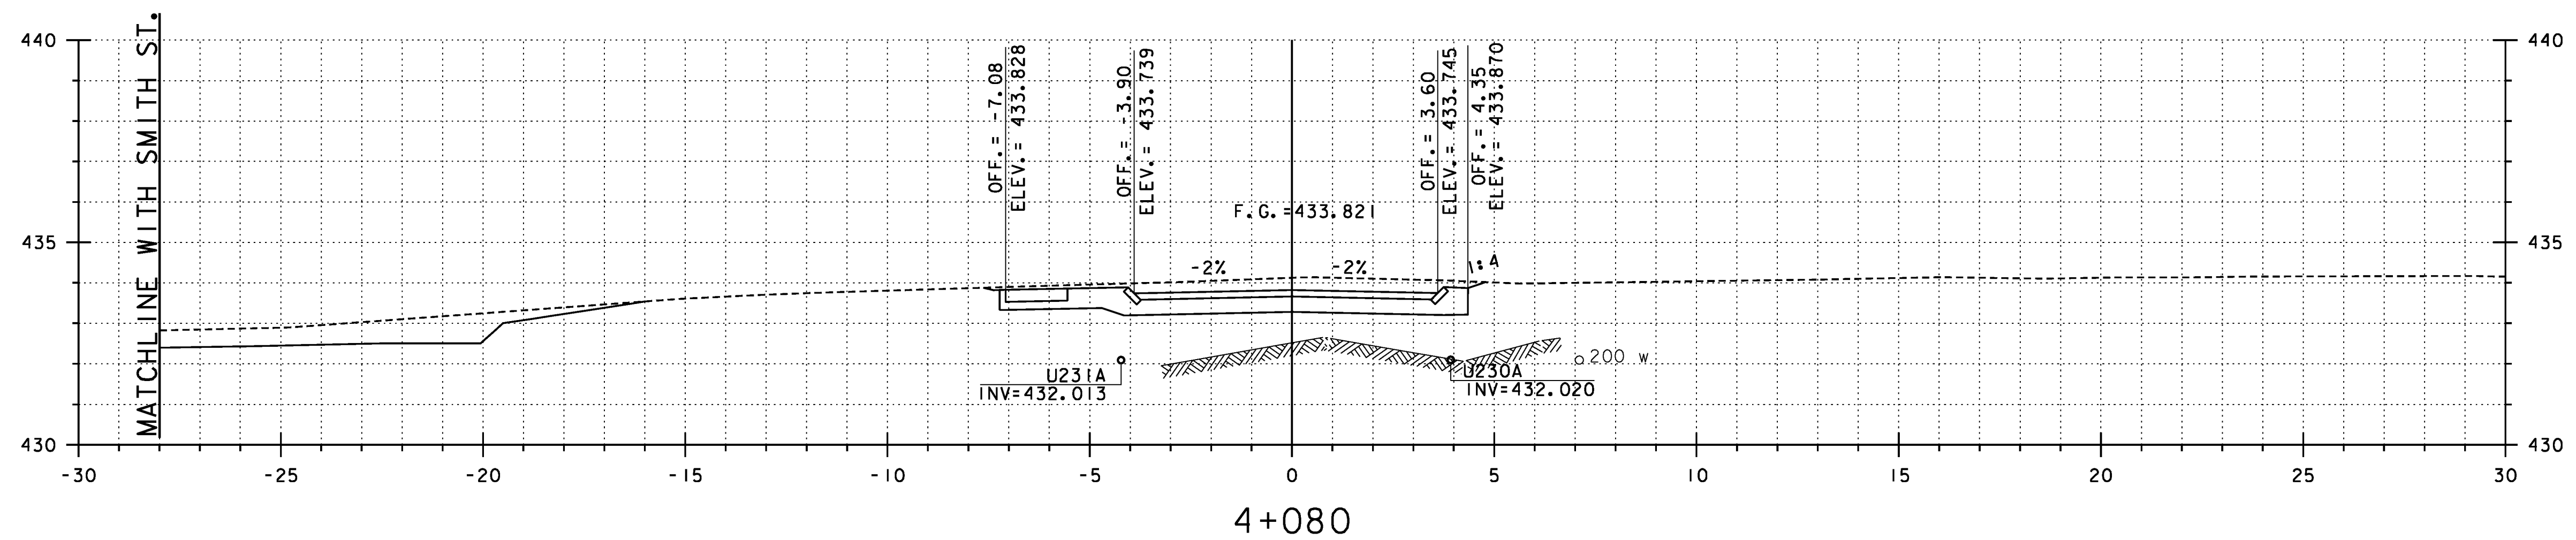
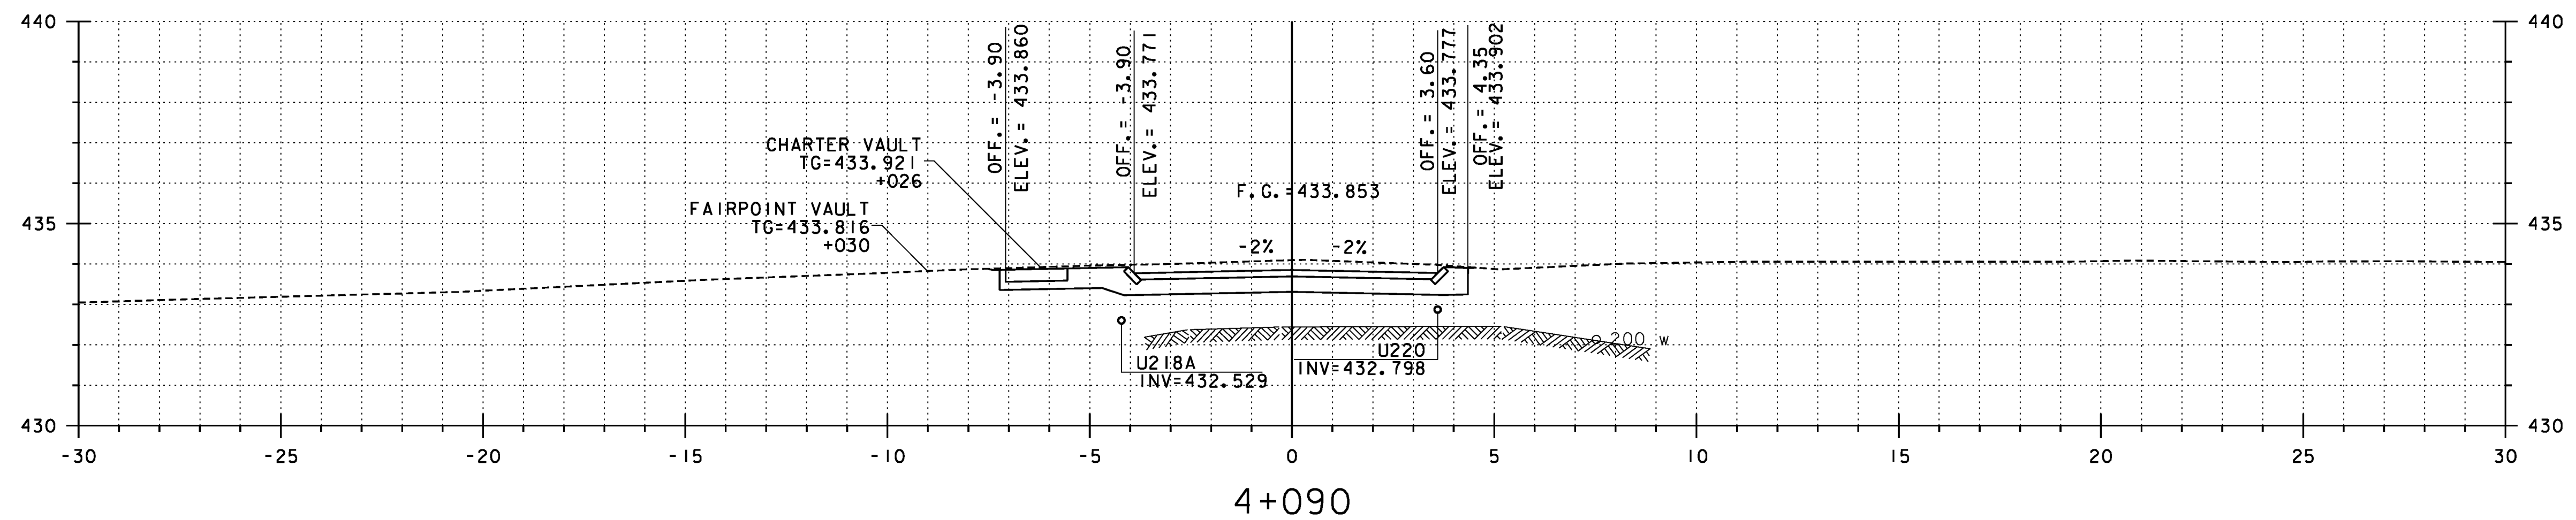


PEACHAM ROAD STA. 4+106.333=
PARK STREET STA. 2+145.691

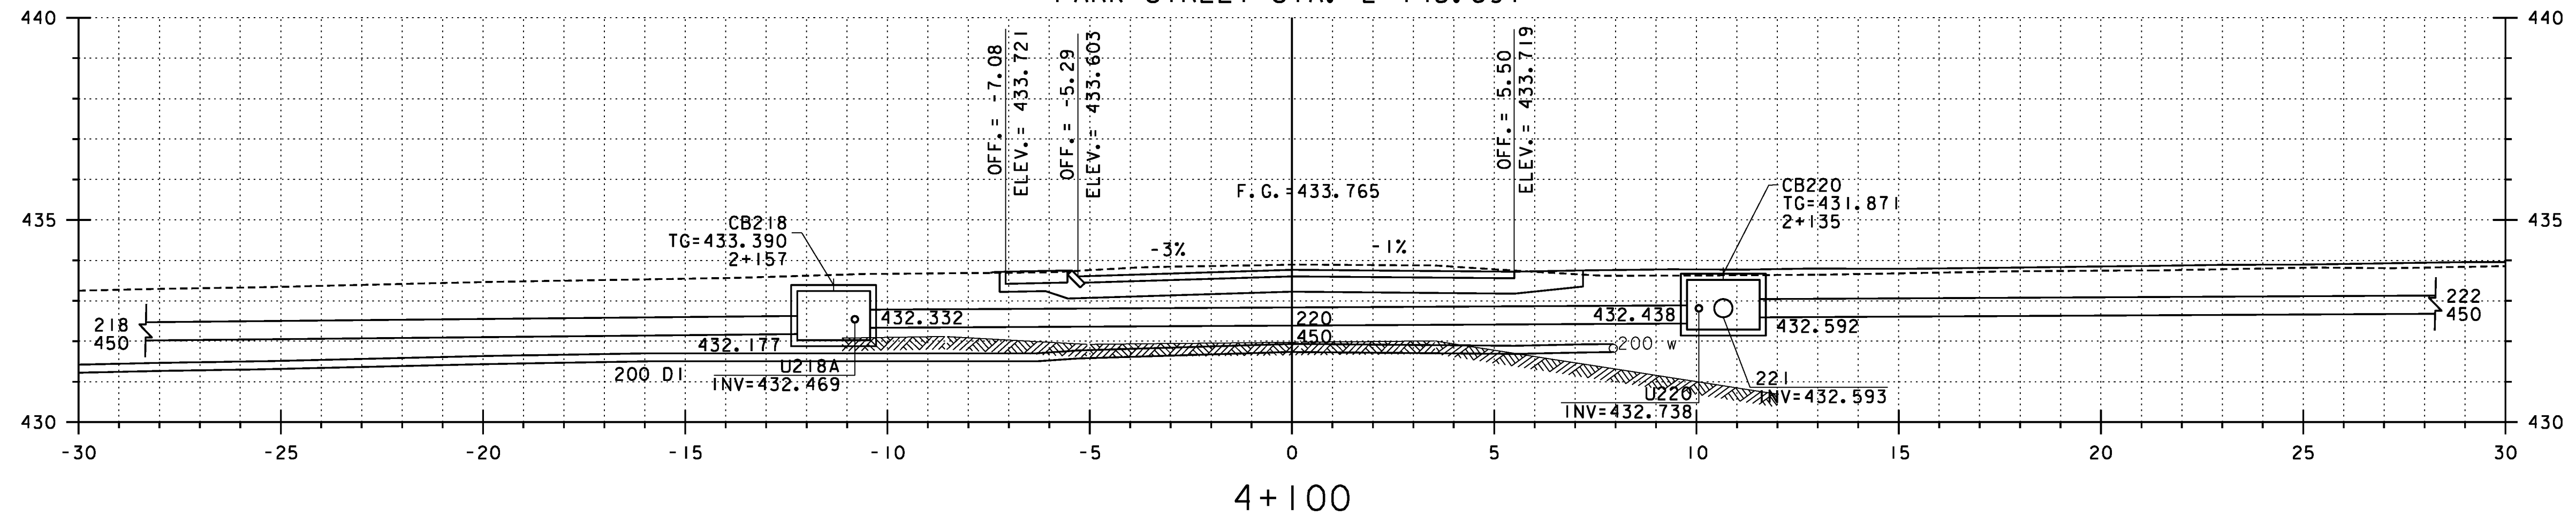

**REPLACEMENT SHEETS
ISSUED 02/24/12**

STA 4+080 TO 4+106.333

PROJECT NAME: DANVILLE
PROJECT NUMBER: F EGC 028-3(32)

FILE NAME: ...\\137 XS-Peacham_10m.ptf PLOT DATE: 2/24/2012
DESIGN SUPERVISOR: GARY SANTY DRAWN BY: STANTEC
DESIGNED BY: STANTEC CHECKED BY: STANTEC
PEACHAM ROAD CROSS SECTIONS - PRX-4 SHEET 278 OF 306

