



4+130
PEACHAM ROAD STA. 4+123.840
BEGIN APPROACH CONSTRUCTION

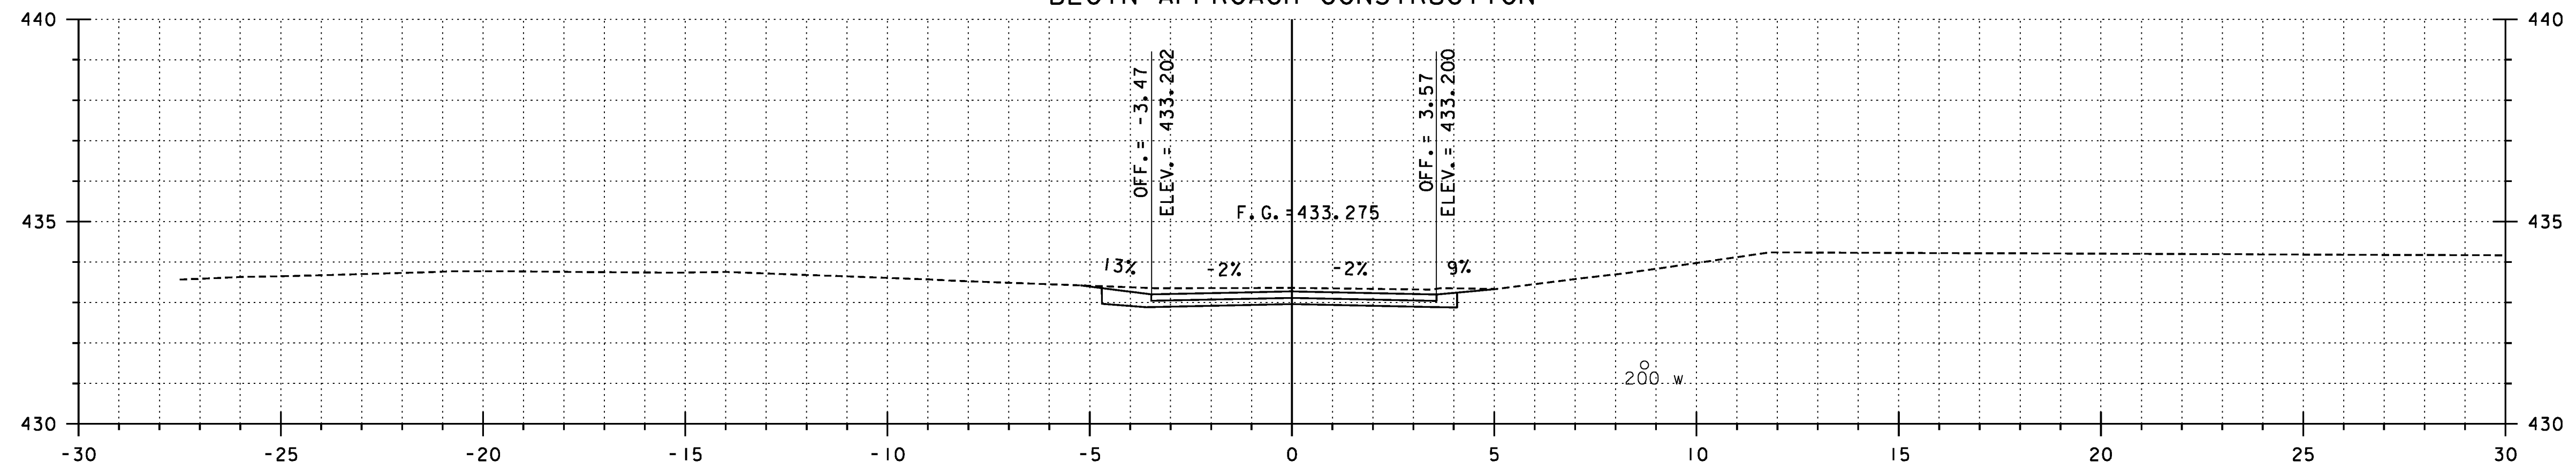

4+120

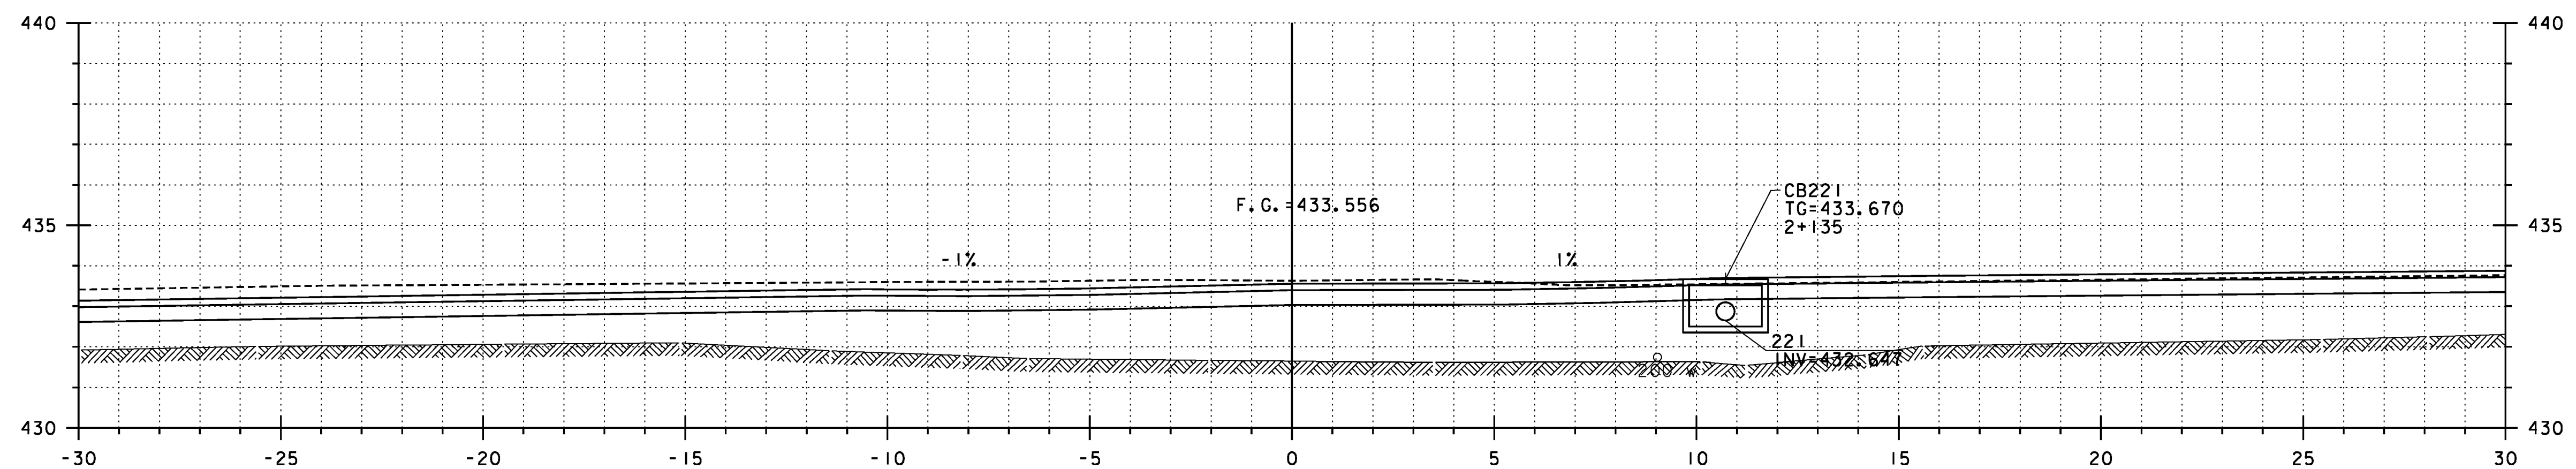

4+110

**REPLACEMENT SHEETS
ISSUED 02/24/12**

STA 4+110 TO 4+130

PROJECT NAME: DANVILLE
PROJECT NUMBER: F EGC 028-3(32)

FILE NAME: ...137 XS-Peacham_10m.ptf PLOT DATE: 2/24/2012
DESIGN SUPERVISOR: GARY SANTY DRAWN BY: STANTEC
DESIGNED BY: STANTEC CHECKED BY: STANTEC
PEACHAM ROAD CROSS SECTIONS - PRX-5 SHEET 279 OF 306

