


4+132
 PEACHAM ROAD STA. 4+131.840
 END APPROACH CONSTRUCTION
 MATCH EXISTING

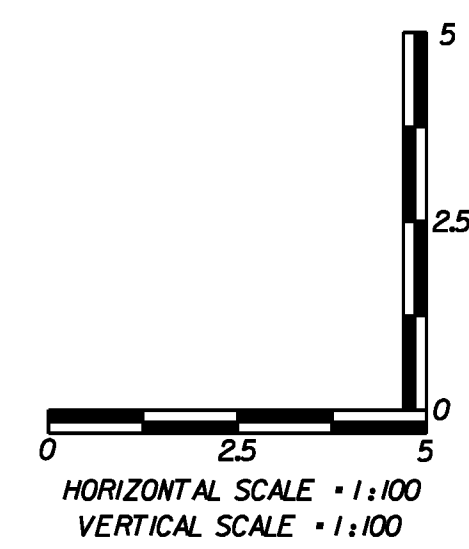

**REPLACEMENT SHEETS
 ISSUED 02/24/12**

STA 4+132

PROJECT NAME: DANVILLE
 PROJECT NUMBER: F EGC 028-3(32)

FILE NAME: ...\\137 XS-Peacham_I0m.ptf PLOT DATE: 2/24/2012
 DESIGN SUPERVISOR: GARY SANTY DRAWN BY: STANTEC
 DESIGNED BY: STANTEC CHECKED BY: STANTEC
PEACHAM ROAD CROSS SECTIONS - PRX-6 SHEET 280 OF 306