


SMITH STREET STA. 5+000.000=  
U. S. ROUTE 2 STA. 19+224.651

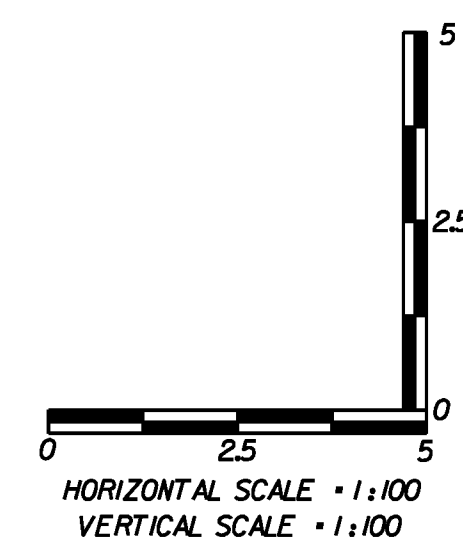

**REPLACEMENT SHEETS  
ISSUED 02/24/12**

PROJECT NAME: DANVILLE	PLOT DATE: 2/24/2012
PROJECT NUMBER: F EGC 028-3(32)	DRAWN BY: STANTEC
FILE NAME: ...\\PlotFiles\138 XS-Smith_10m.ptf	CHECKED BY: STANTEC
DESIGN SUPERVISOR: GARY SANTY	SHEET 281 OF 306
DESIGNED BY: STANTEC	

STA 5+000.000 TO 5+024.1