
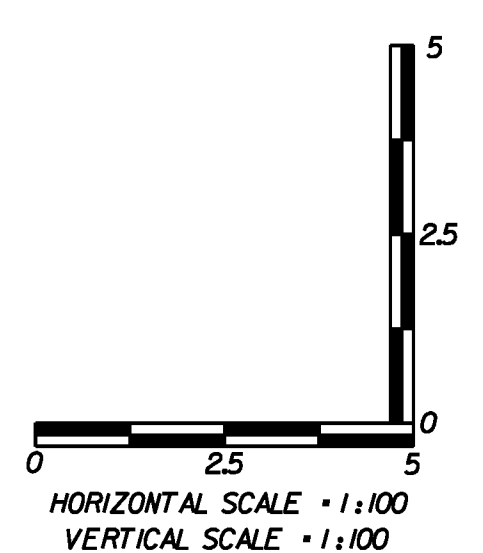


NOTE:
SEE FIRE DISTRICT WATER PLAN
FD-07 FOR WATERLINE/DRAINAGE
CONFLICT RESOLUTION.

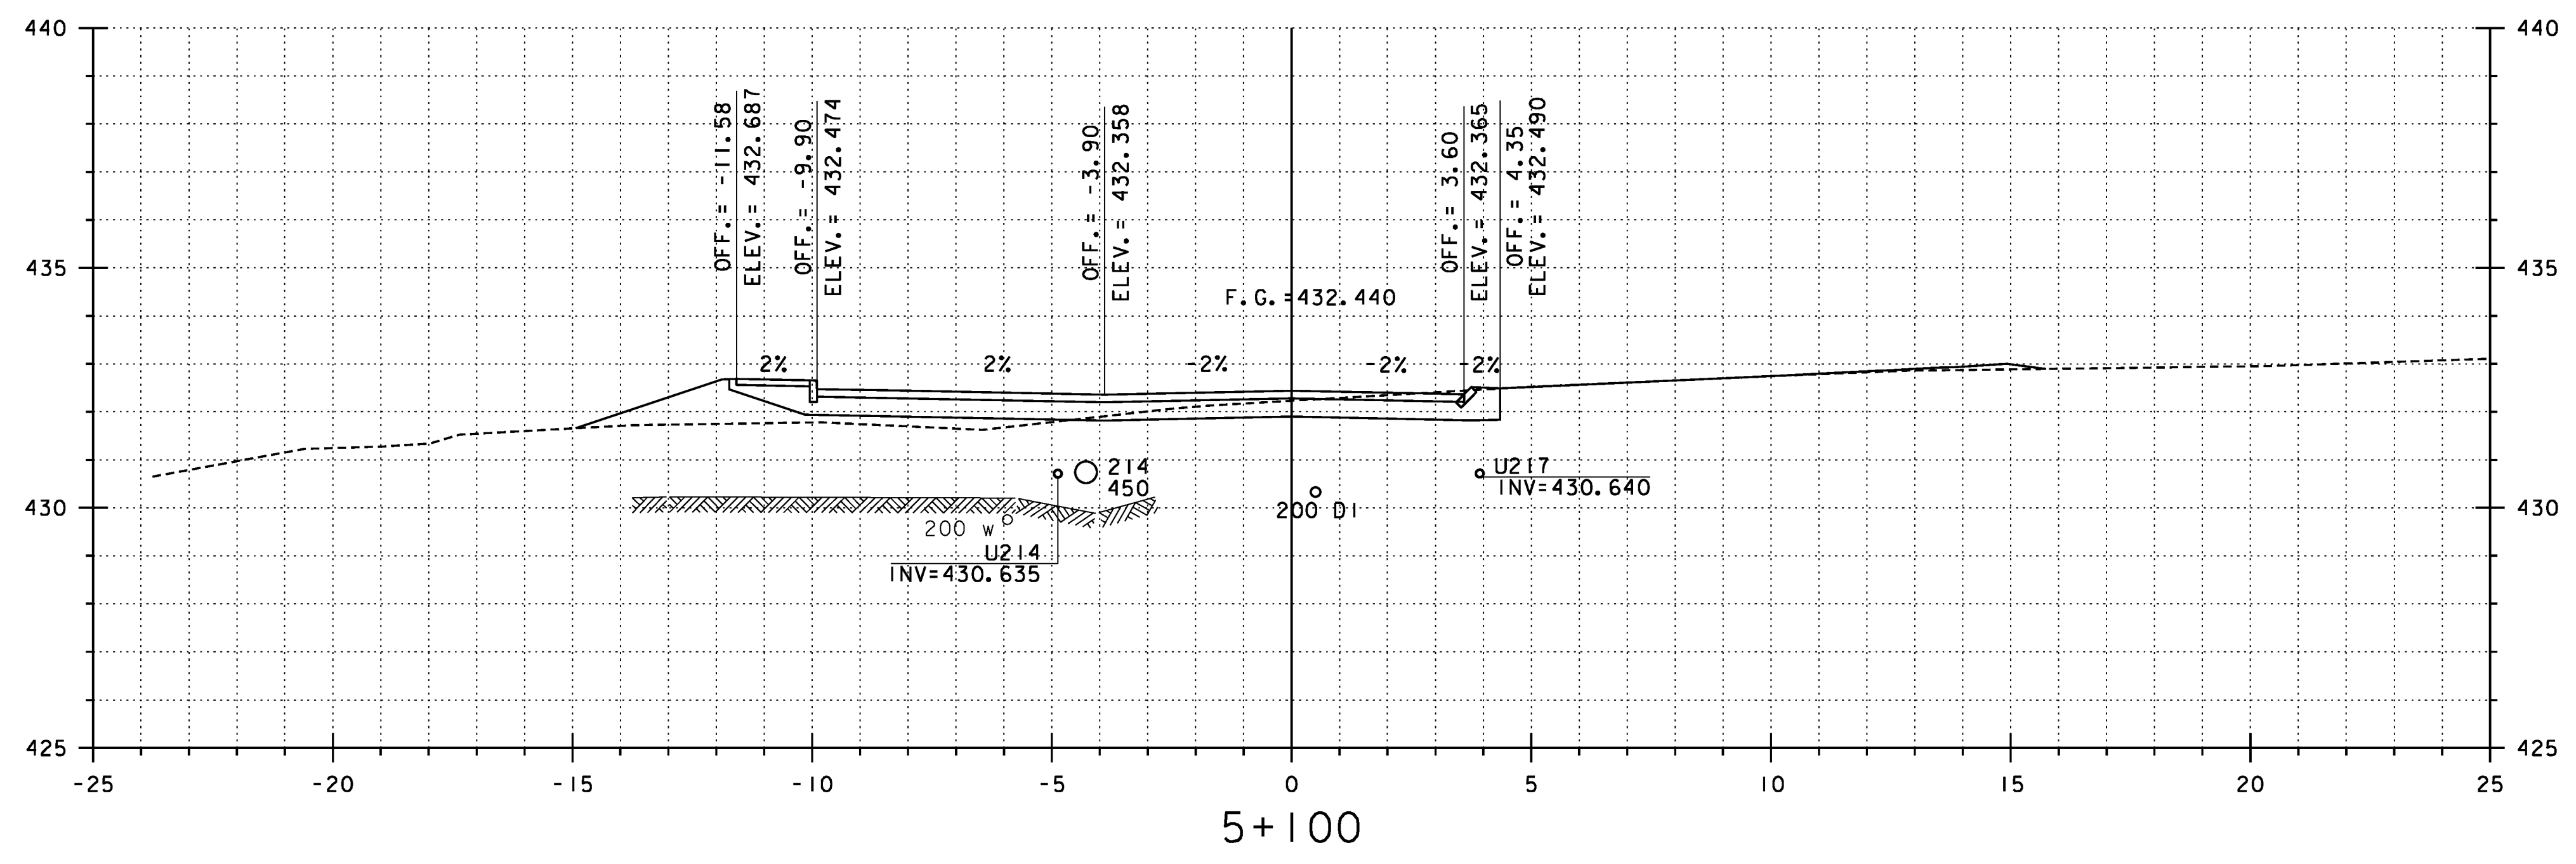

**REPLACEMENT SHEETS
ISSUED 02/24/12**

STA 5+100 TO 5+110

PROJECT NAME: DANVILLE	PLOT DATE: 2/24/2012
PROJECT NUMBER: F EGC 028-3(32)	DRAWN BY: STANTEC
FILE NAME: ...\\PlotFiles\138 XS-Smith_10m.ptf	CHECKED BY: STANTEC
DESIGN SUPERVISOR: GARY SANTY	SHEET 286 OF 306
DESIGNED BY: STANTEC	