

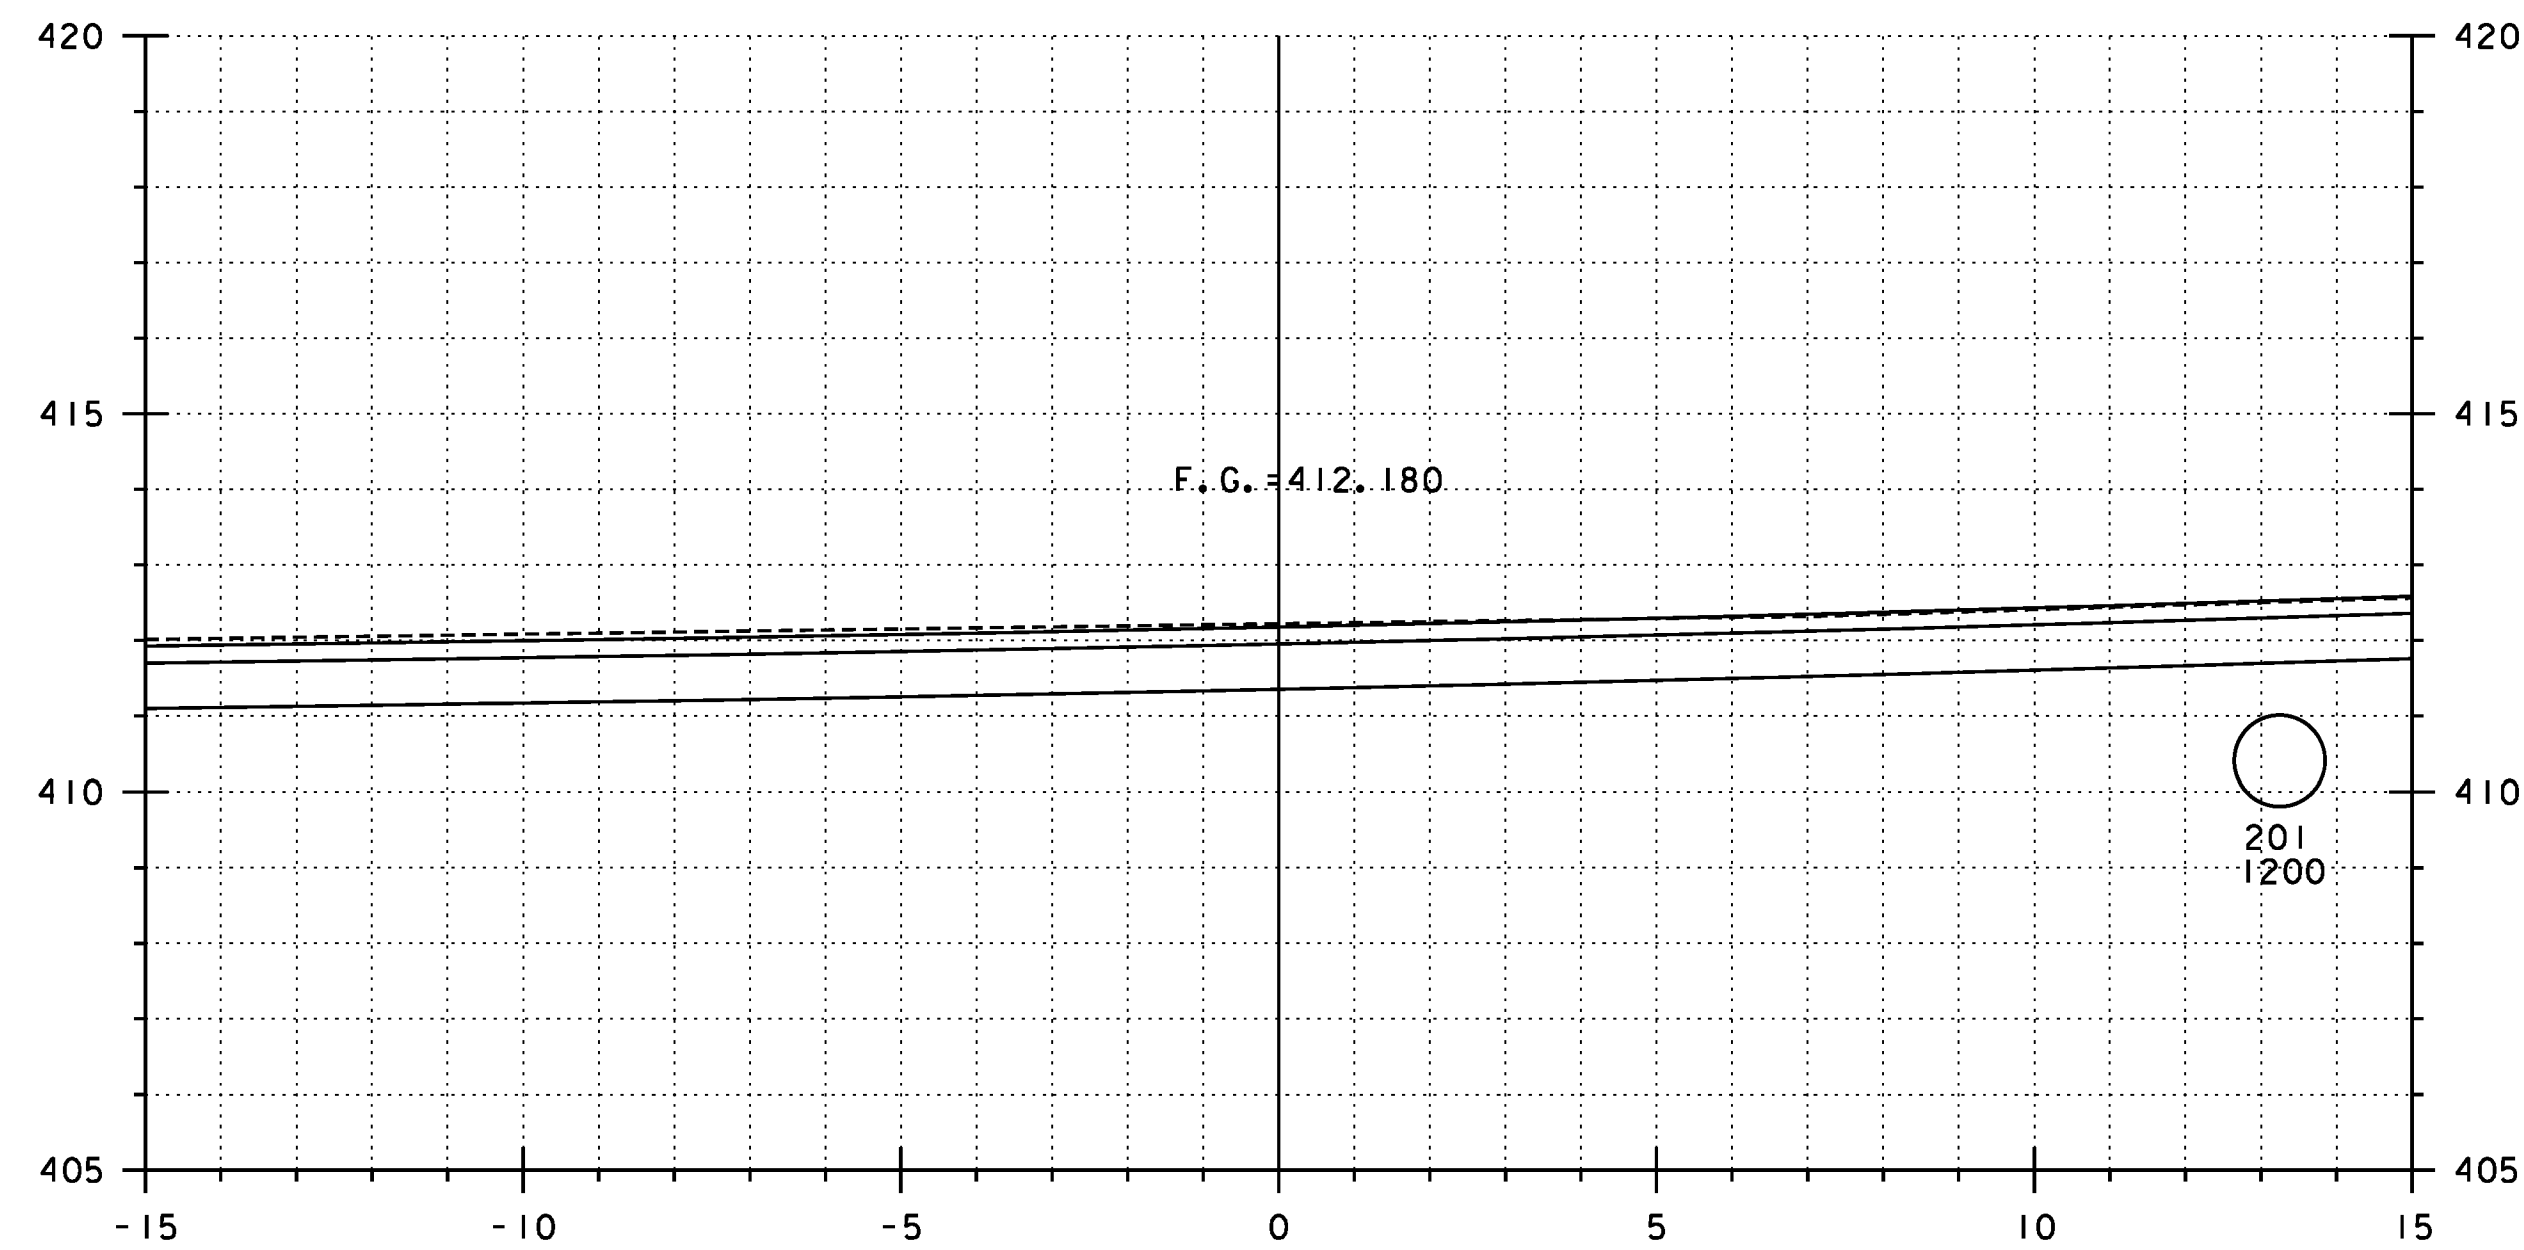



MOUNTAIN VIEW DRIVE STA. 7+019.500  
BEGIN APPROACH CONSTRUCTION

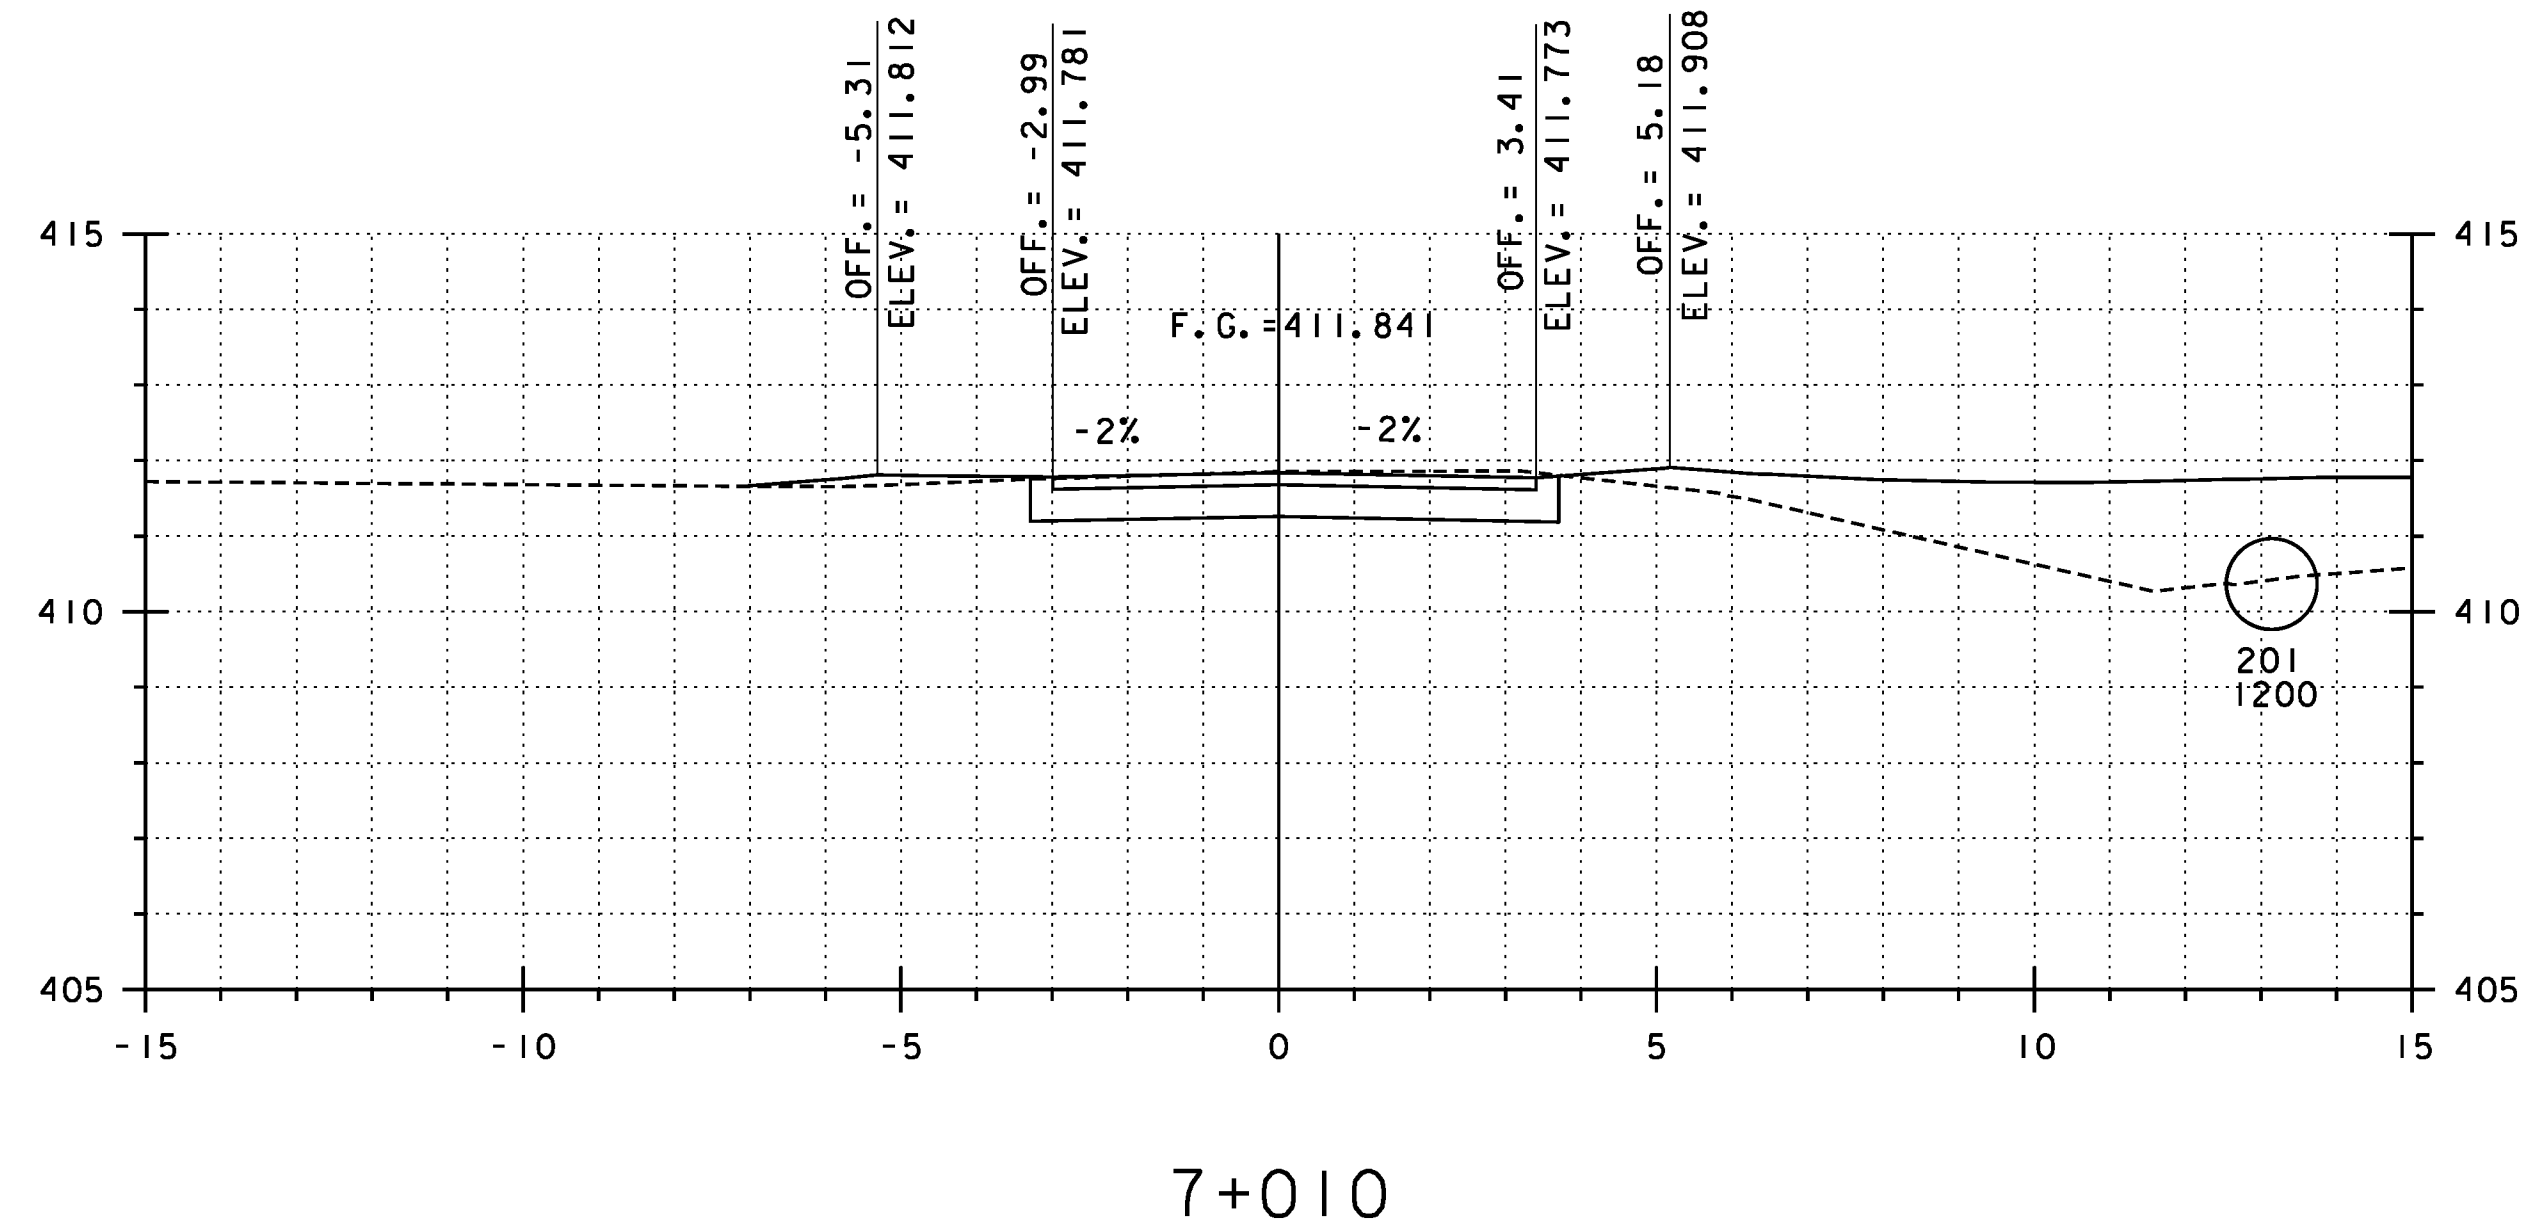

7+000  
MOUNTAIN VIEW DRIVE STA. 6+999.932=  
U. S. ROUTE 2 STA. 19+434.495,  
HIGHLAND AVENUE STA. 6+000.000

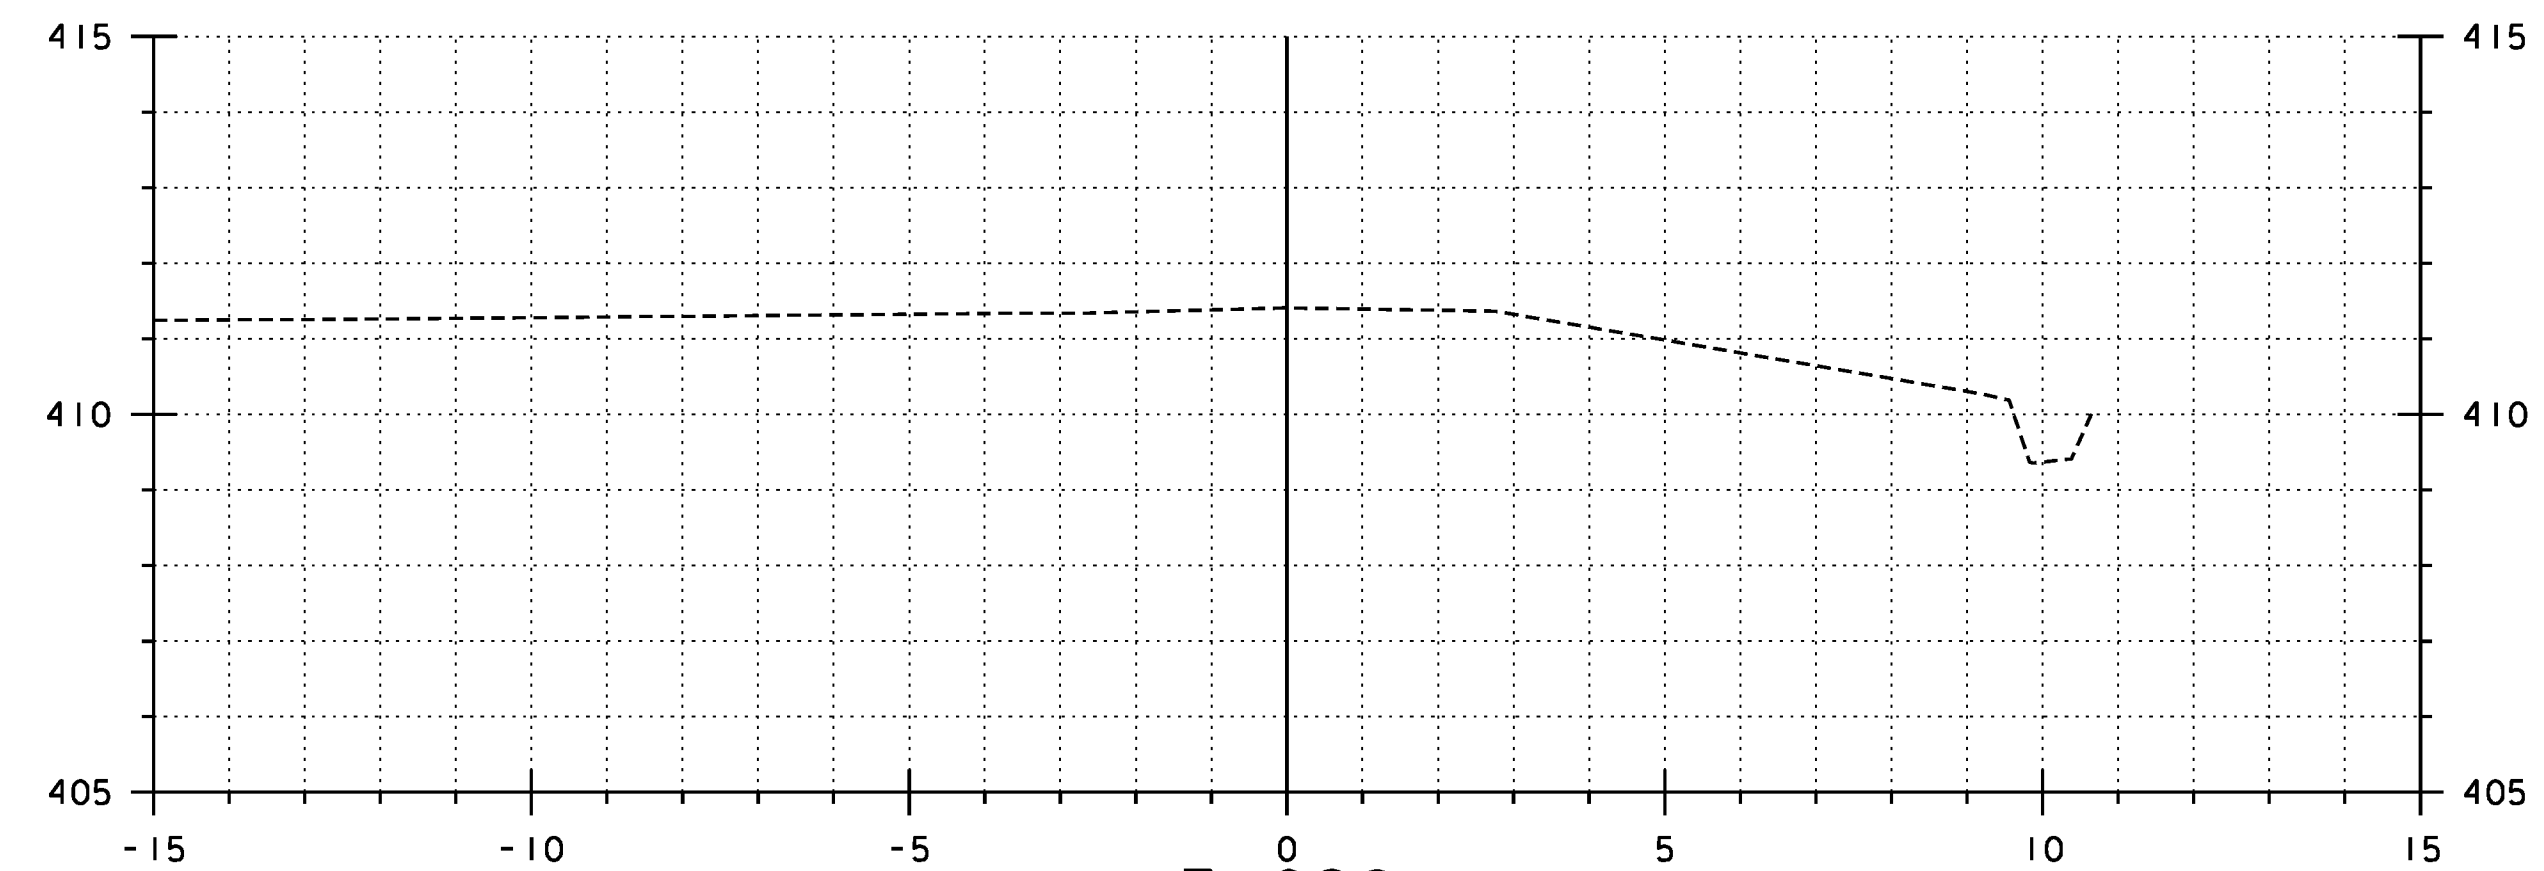

7+028  
MOUNTAIN VIEW DRIVE STA. 7+027.500  
END APPROACH CONSTRUCTION  
MATCH EXISTING

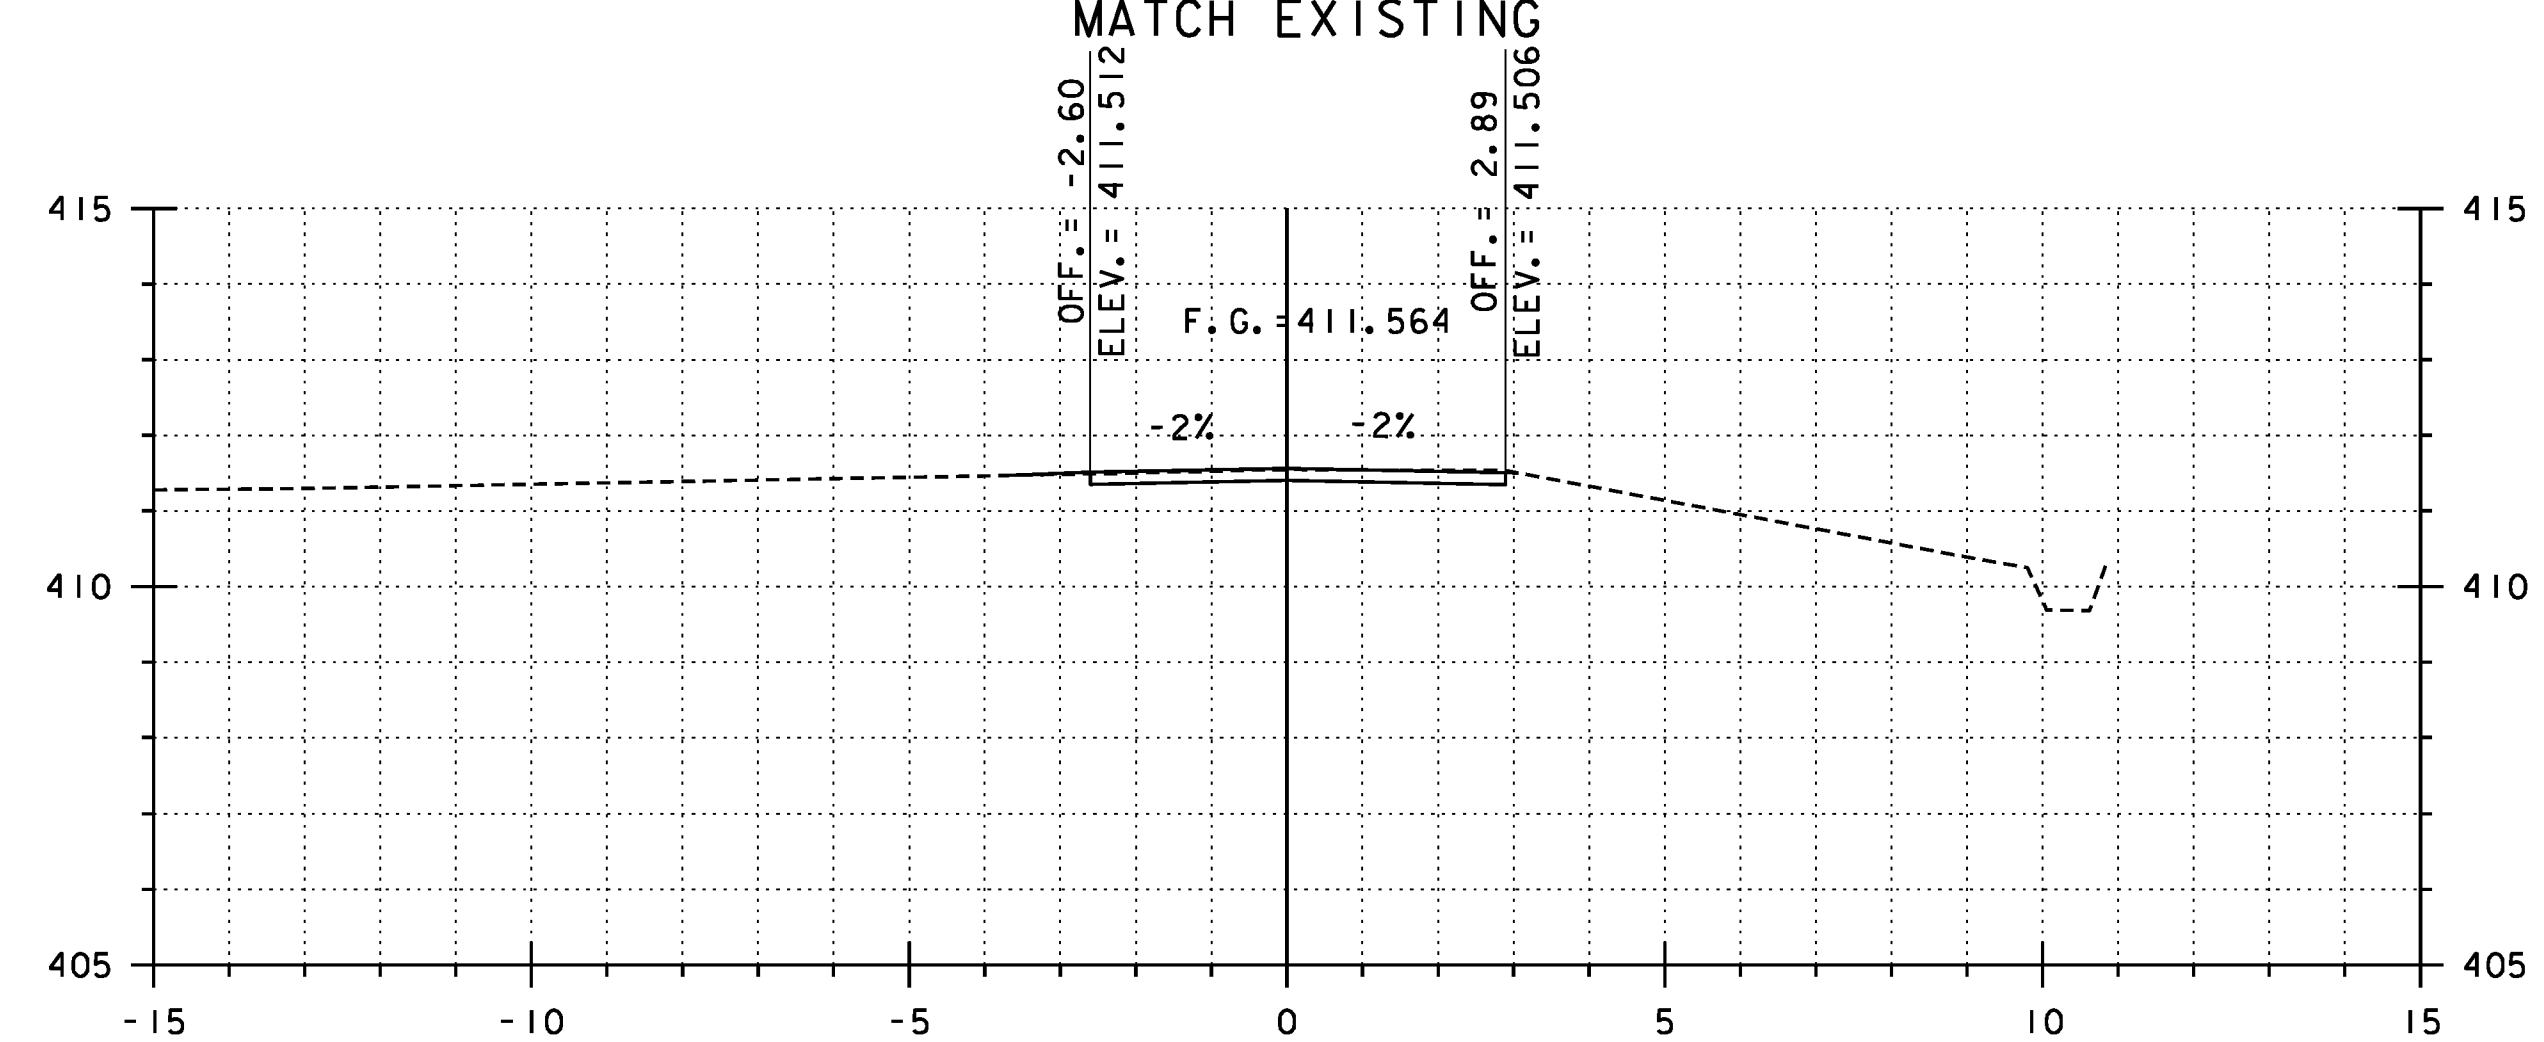

7+020

**REPLACEMENT SHEETS  
ISSUED 02/24/12**

STA 7+000.000 TO 7+028

PROJECT NAME: DANVILLE  
PROJECT NUMBER: F EGC 028-3(32)

FILE NAME: ...\\140 XS-MountainView\_10m.pxf PLOT DATE: 2/24/2012  
DESIGN SUPERVISOR: GARY SANTY DRAWN BY: STANTEC  
DESIGNED BY: STANTEC CHECKED BY: STANTEC  
MOUNTAIN VIEW CROSS SECTIONS - MVX-SHEET 289 OF 306

