


WATER MAIN PROFILE

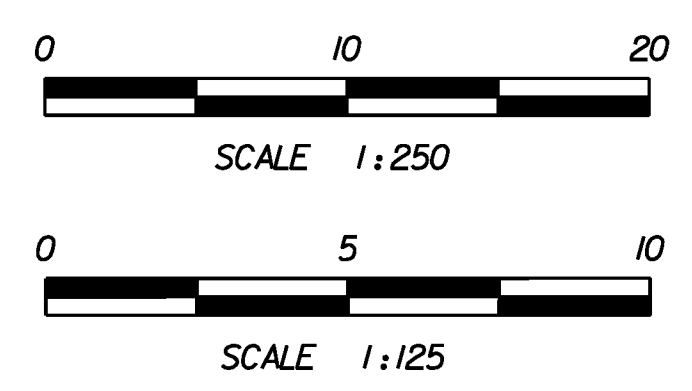

**REPLACEMENT SHEETS
ISSUED 10/5/11**

STA.W 0+520 TO STA.W 0+680

PROJECT NAME:	DANVILLE	PLOT DATE:	10/4/2011
PROJECT NUMBER:	F EGC 028-3(32)	DRAWN BY:	STANTEC
FILE NAME:	...Utilities\PlotFiles\FD-10.ptf	DESIGNED BY:	STANTEC
DESIGN SUPERVISOR:	TOM NESBITT	CHECKED BY:	STANTEC
FIRE DISTRICT WATER PLANS FD-10		SHEET 299 OF 306	



10/4/2011 12:23 PM V:\9531\cvt\ve\9530033_0092\Utilities\PlotFiles\FD-10.ptf