


101

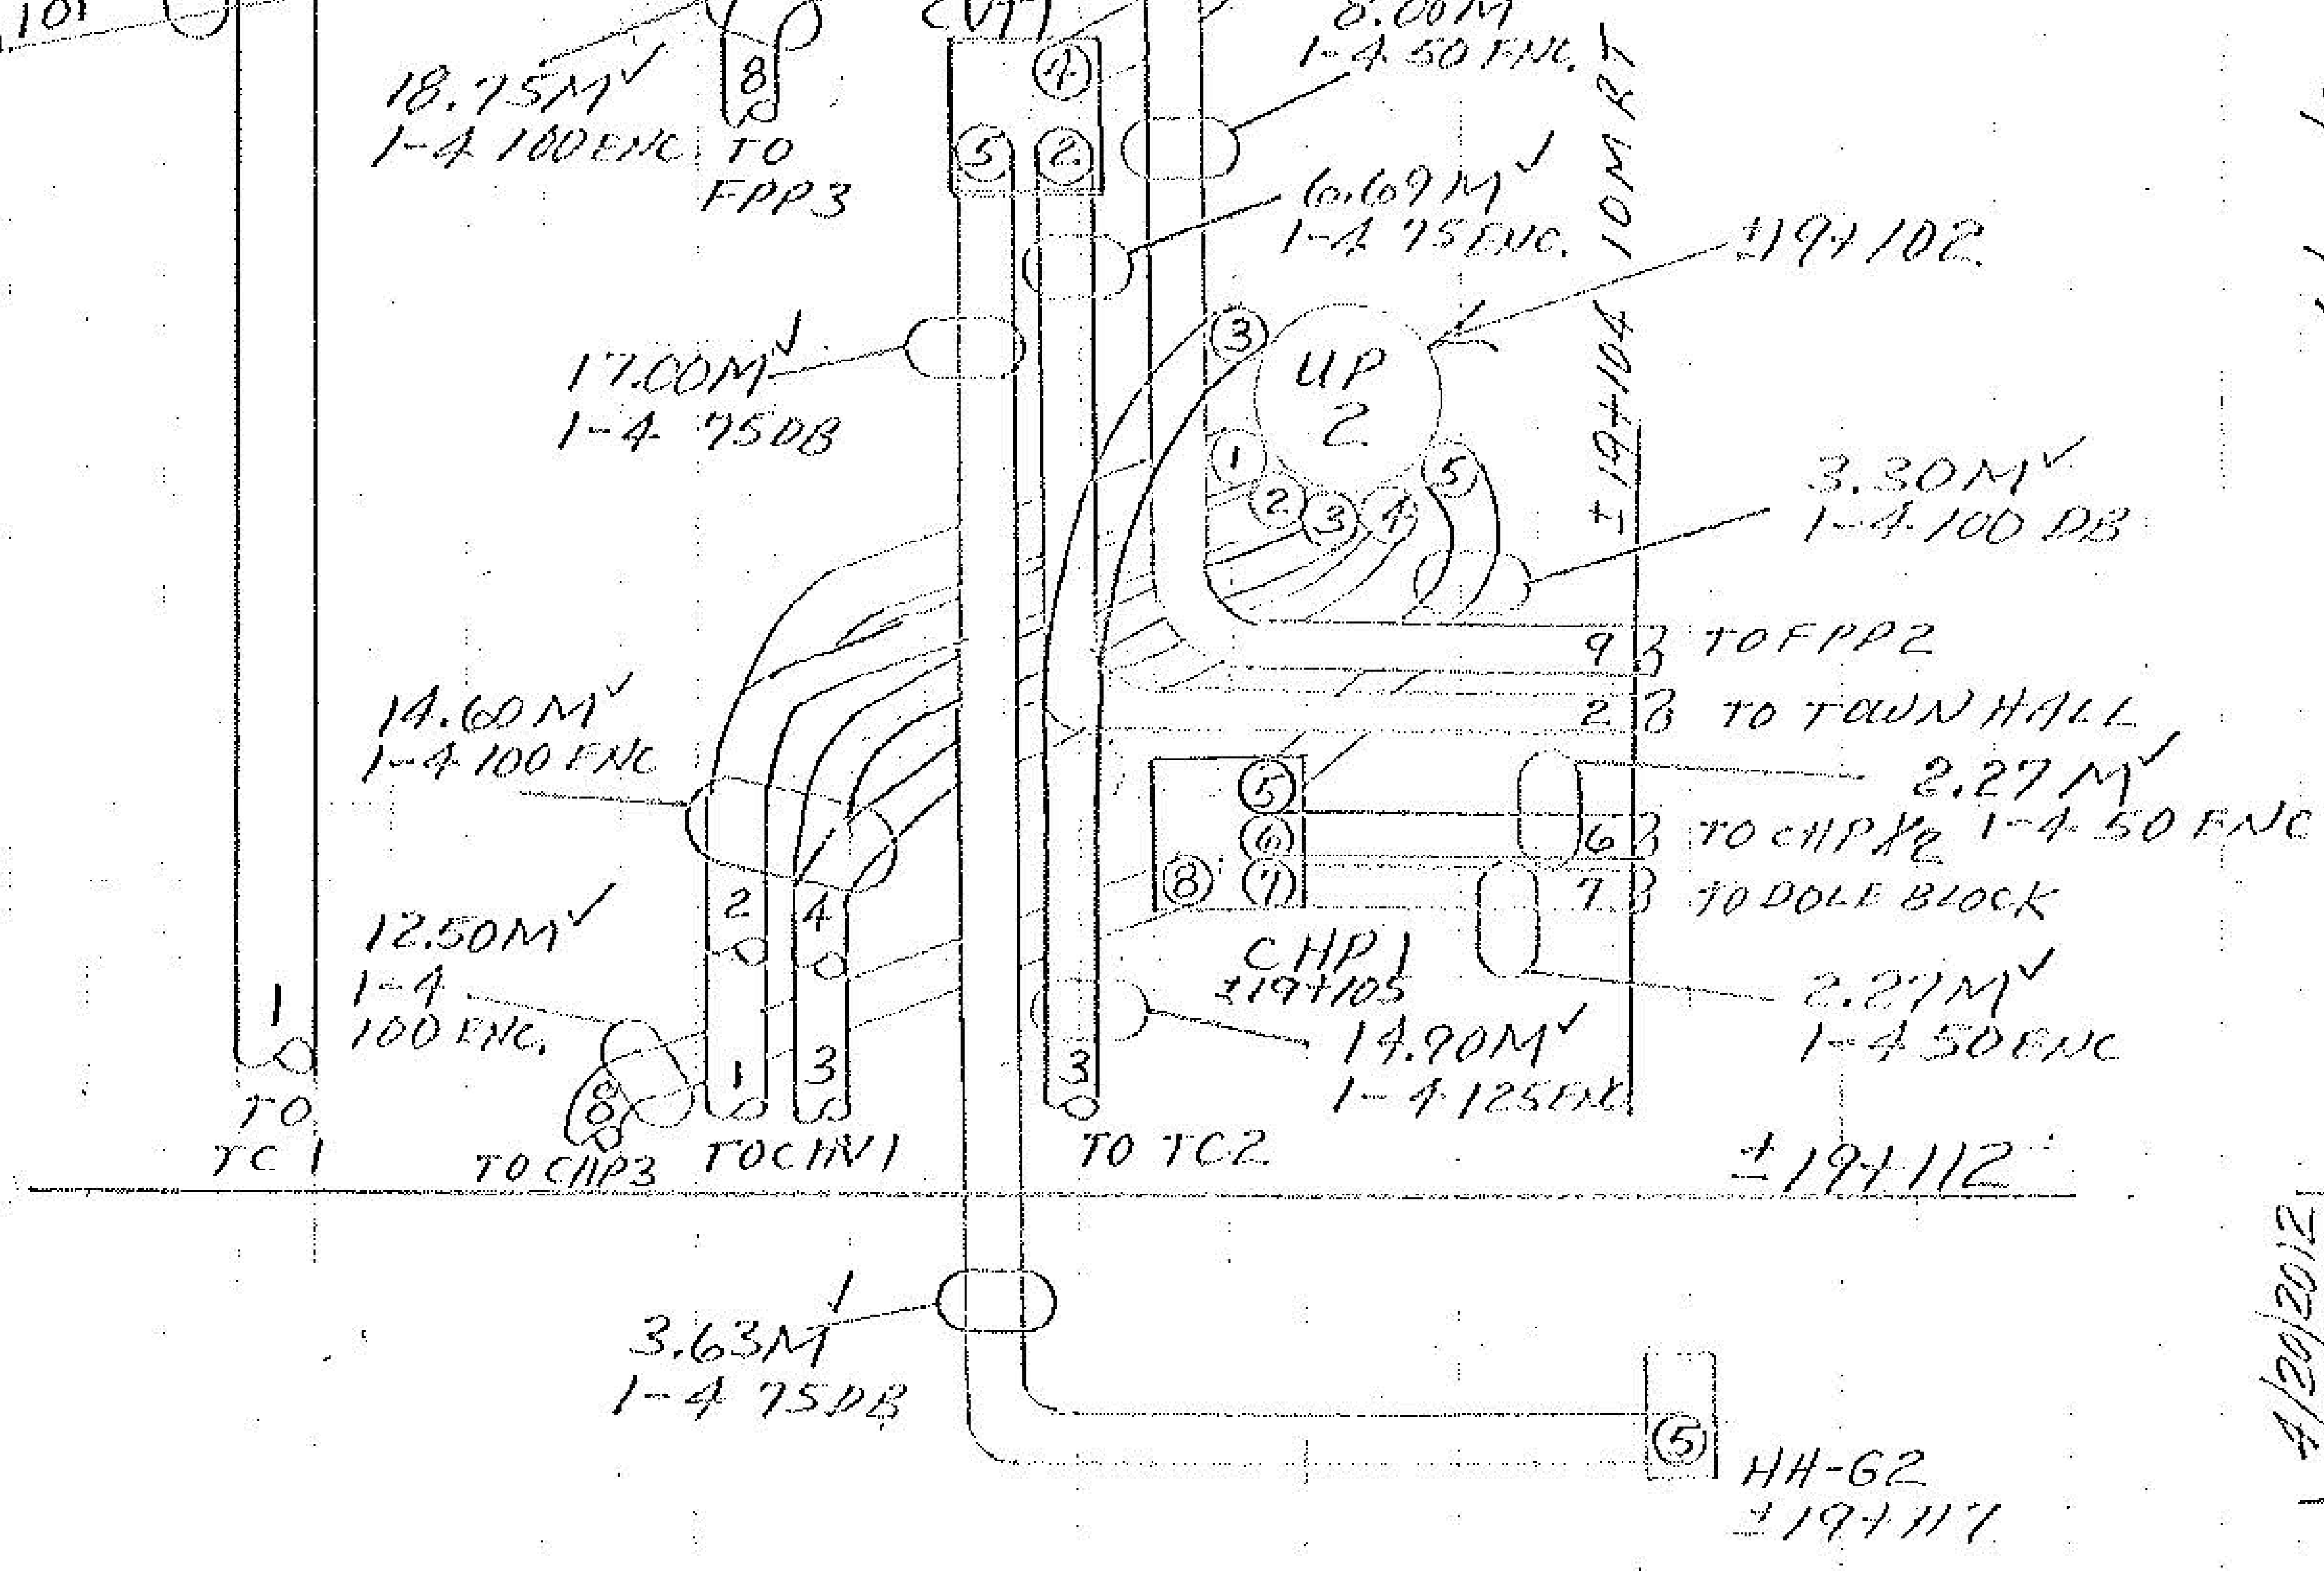

A/17/2012
 ± DATE OF DUCT PL.
 NOT NECESSARY
 4/20/2012

NO SCALE

SCHEMATIC FOR DETAILING PAY ITEMS

DUCT LOCATIONS ARE NOT NECESSARILY RELATIVE TO EACH OTHER.

H.W. NORTON
4/20/2012

OPS.
70