


5/11/2012

5/14/2012

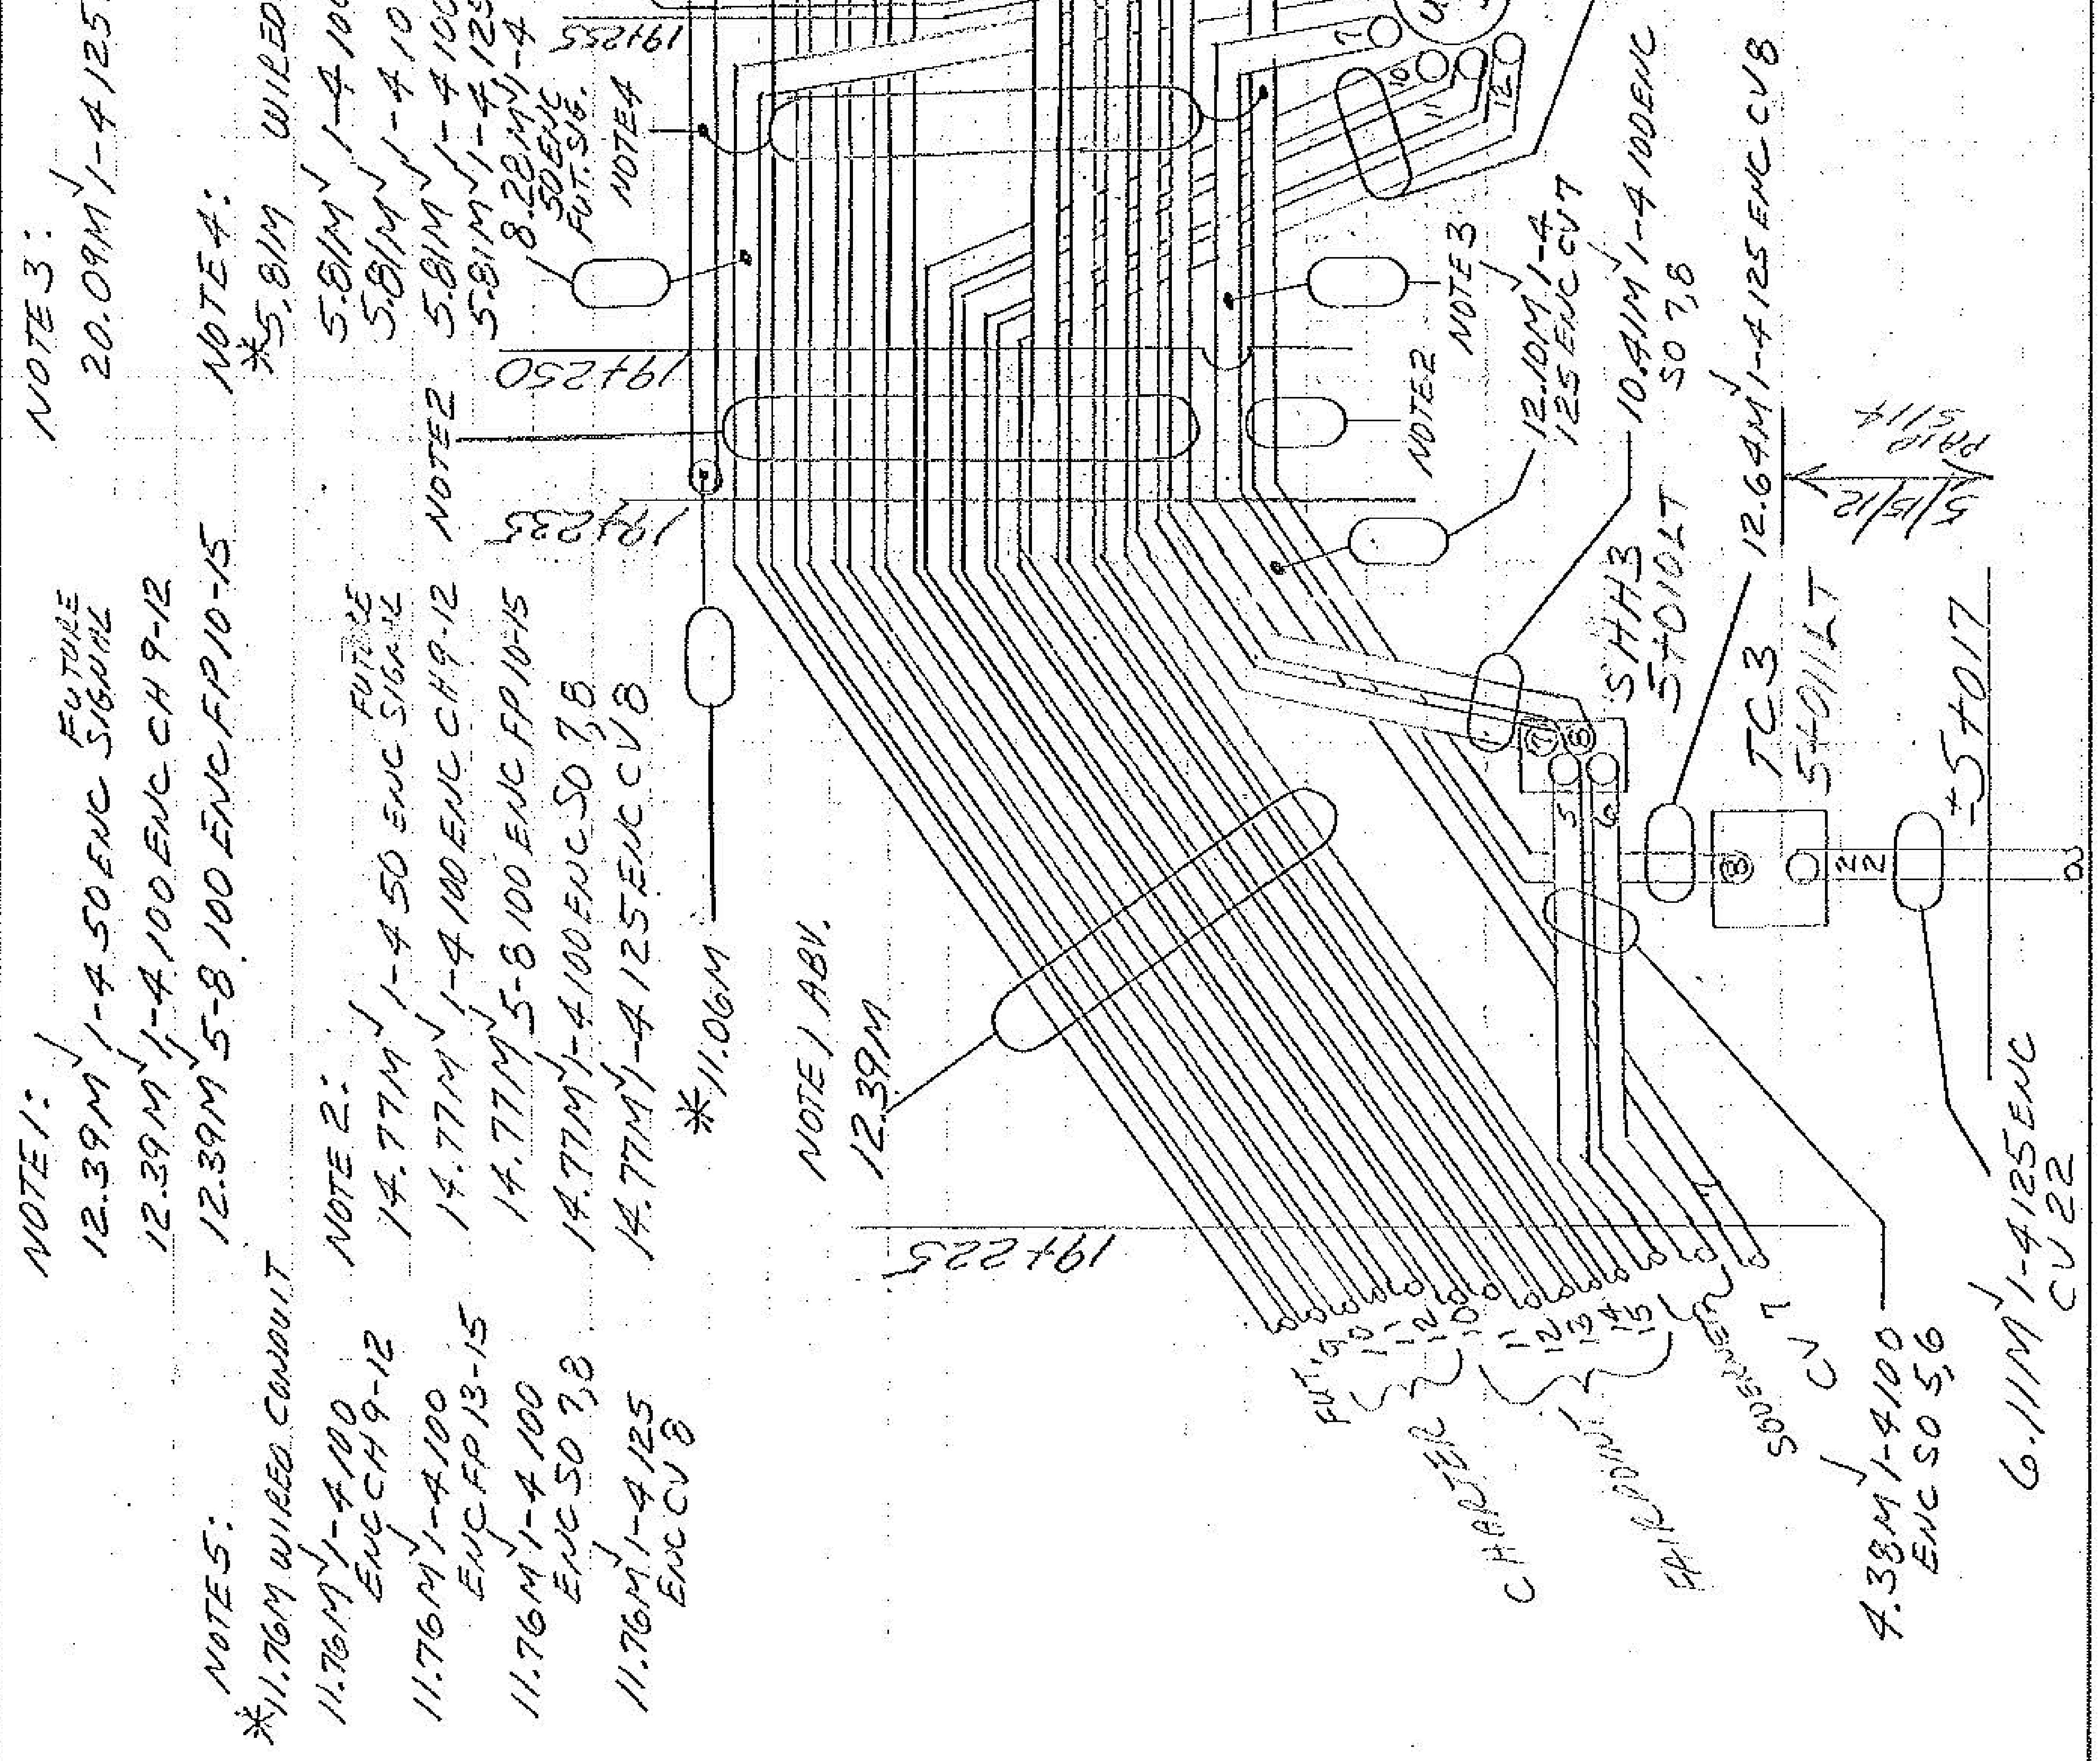

NOTE 1:

12.39M 1-4 50 ENC SIGNAL FUTURE
12.39M 1-4 100 ENC CH 9-12
12.39M 5-8 100 ENC FP 10-15

NOTE 3:

20.09M 1-4 125 ENC

NOTE 5:

*11.76M WIRED CONDUIT

NOTE 2:

11.76M 1-4 100 ENC CH 9-12 FUTURE
11.76M 1-4 100 ENC FP 13-15 FUTURE
11.76M 1-4 100 ENC 50 7,8
11.76M 1-4 125 ENC CV 8
*11.06M

NOTE 4:

*5.81M WIRED
5.81M 1-4 100
5.81M 1-4 100
5.81M 1-4 100
5.81M 1-4 125
8.28M 1-4
50 ENC
FUT. SIG.
NOTE 4

NOTE 1 ABV.

12.39M

19+225

19+233
19+250
19+251

FUTURE
CHAPTER
FAIR POINT
SOURCE
CV 7

NOTE 2
NOTE 3

12.10M 1-4
125 ENC CV 7

SHH3
57010LT
10.81M 1-4 100 ENC
50 7,8

TCC3
57011LT
12.64M 1-4 125 ENC CV 8

4.38M 1-4 100
ENC 50 5,6

6.11M 1-4 125 ENC
CV 22

5/15/12
5/15/14