


DATE OF DUCT PLACEMENT
4/26/2012

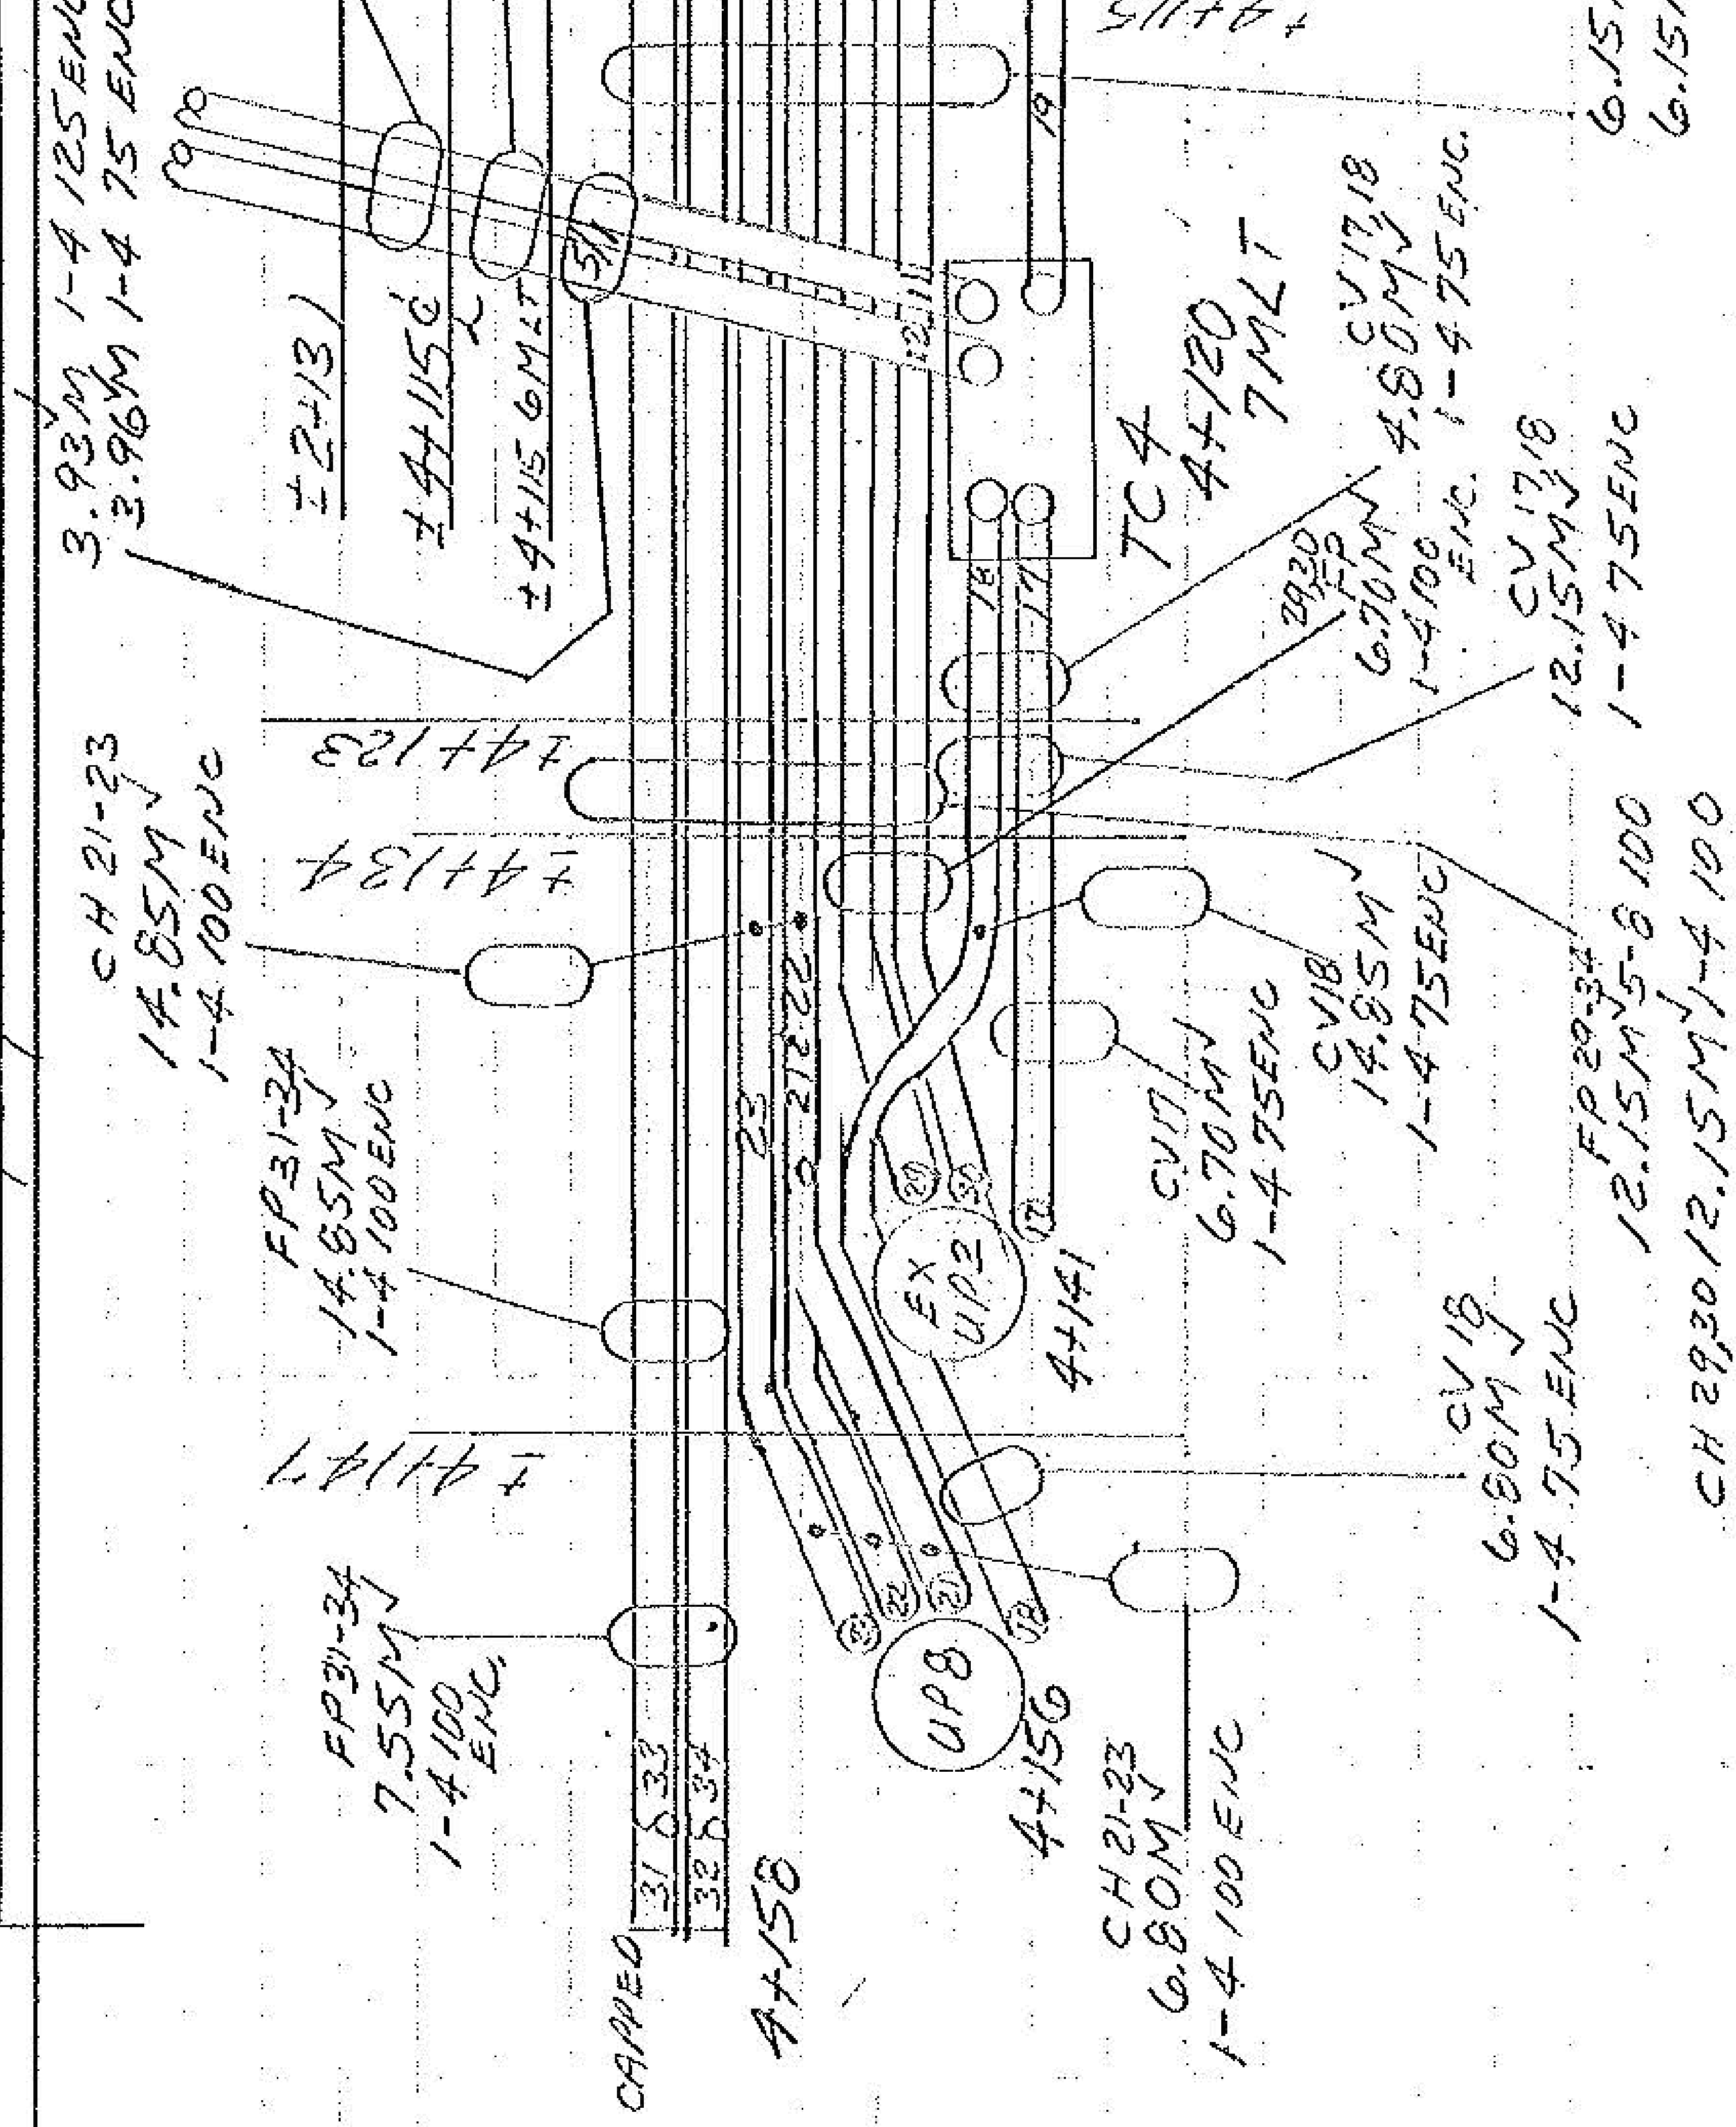

NOTE 1 ✓
8.95M ✓ 1-4 100 ENC CH 21-23

NOTE 2 ✓
10.41M ✓ 5-8 100 ENC FP 29-34

SCHEMATIC FOR DETAILING PAY ITEMS
DUCT LOCATIONS ARE NOT NECESSARILY
RELATIVE TO EACH OTHER