


5/4/2012

Y

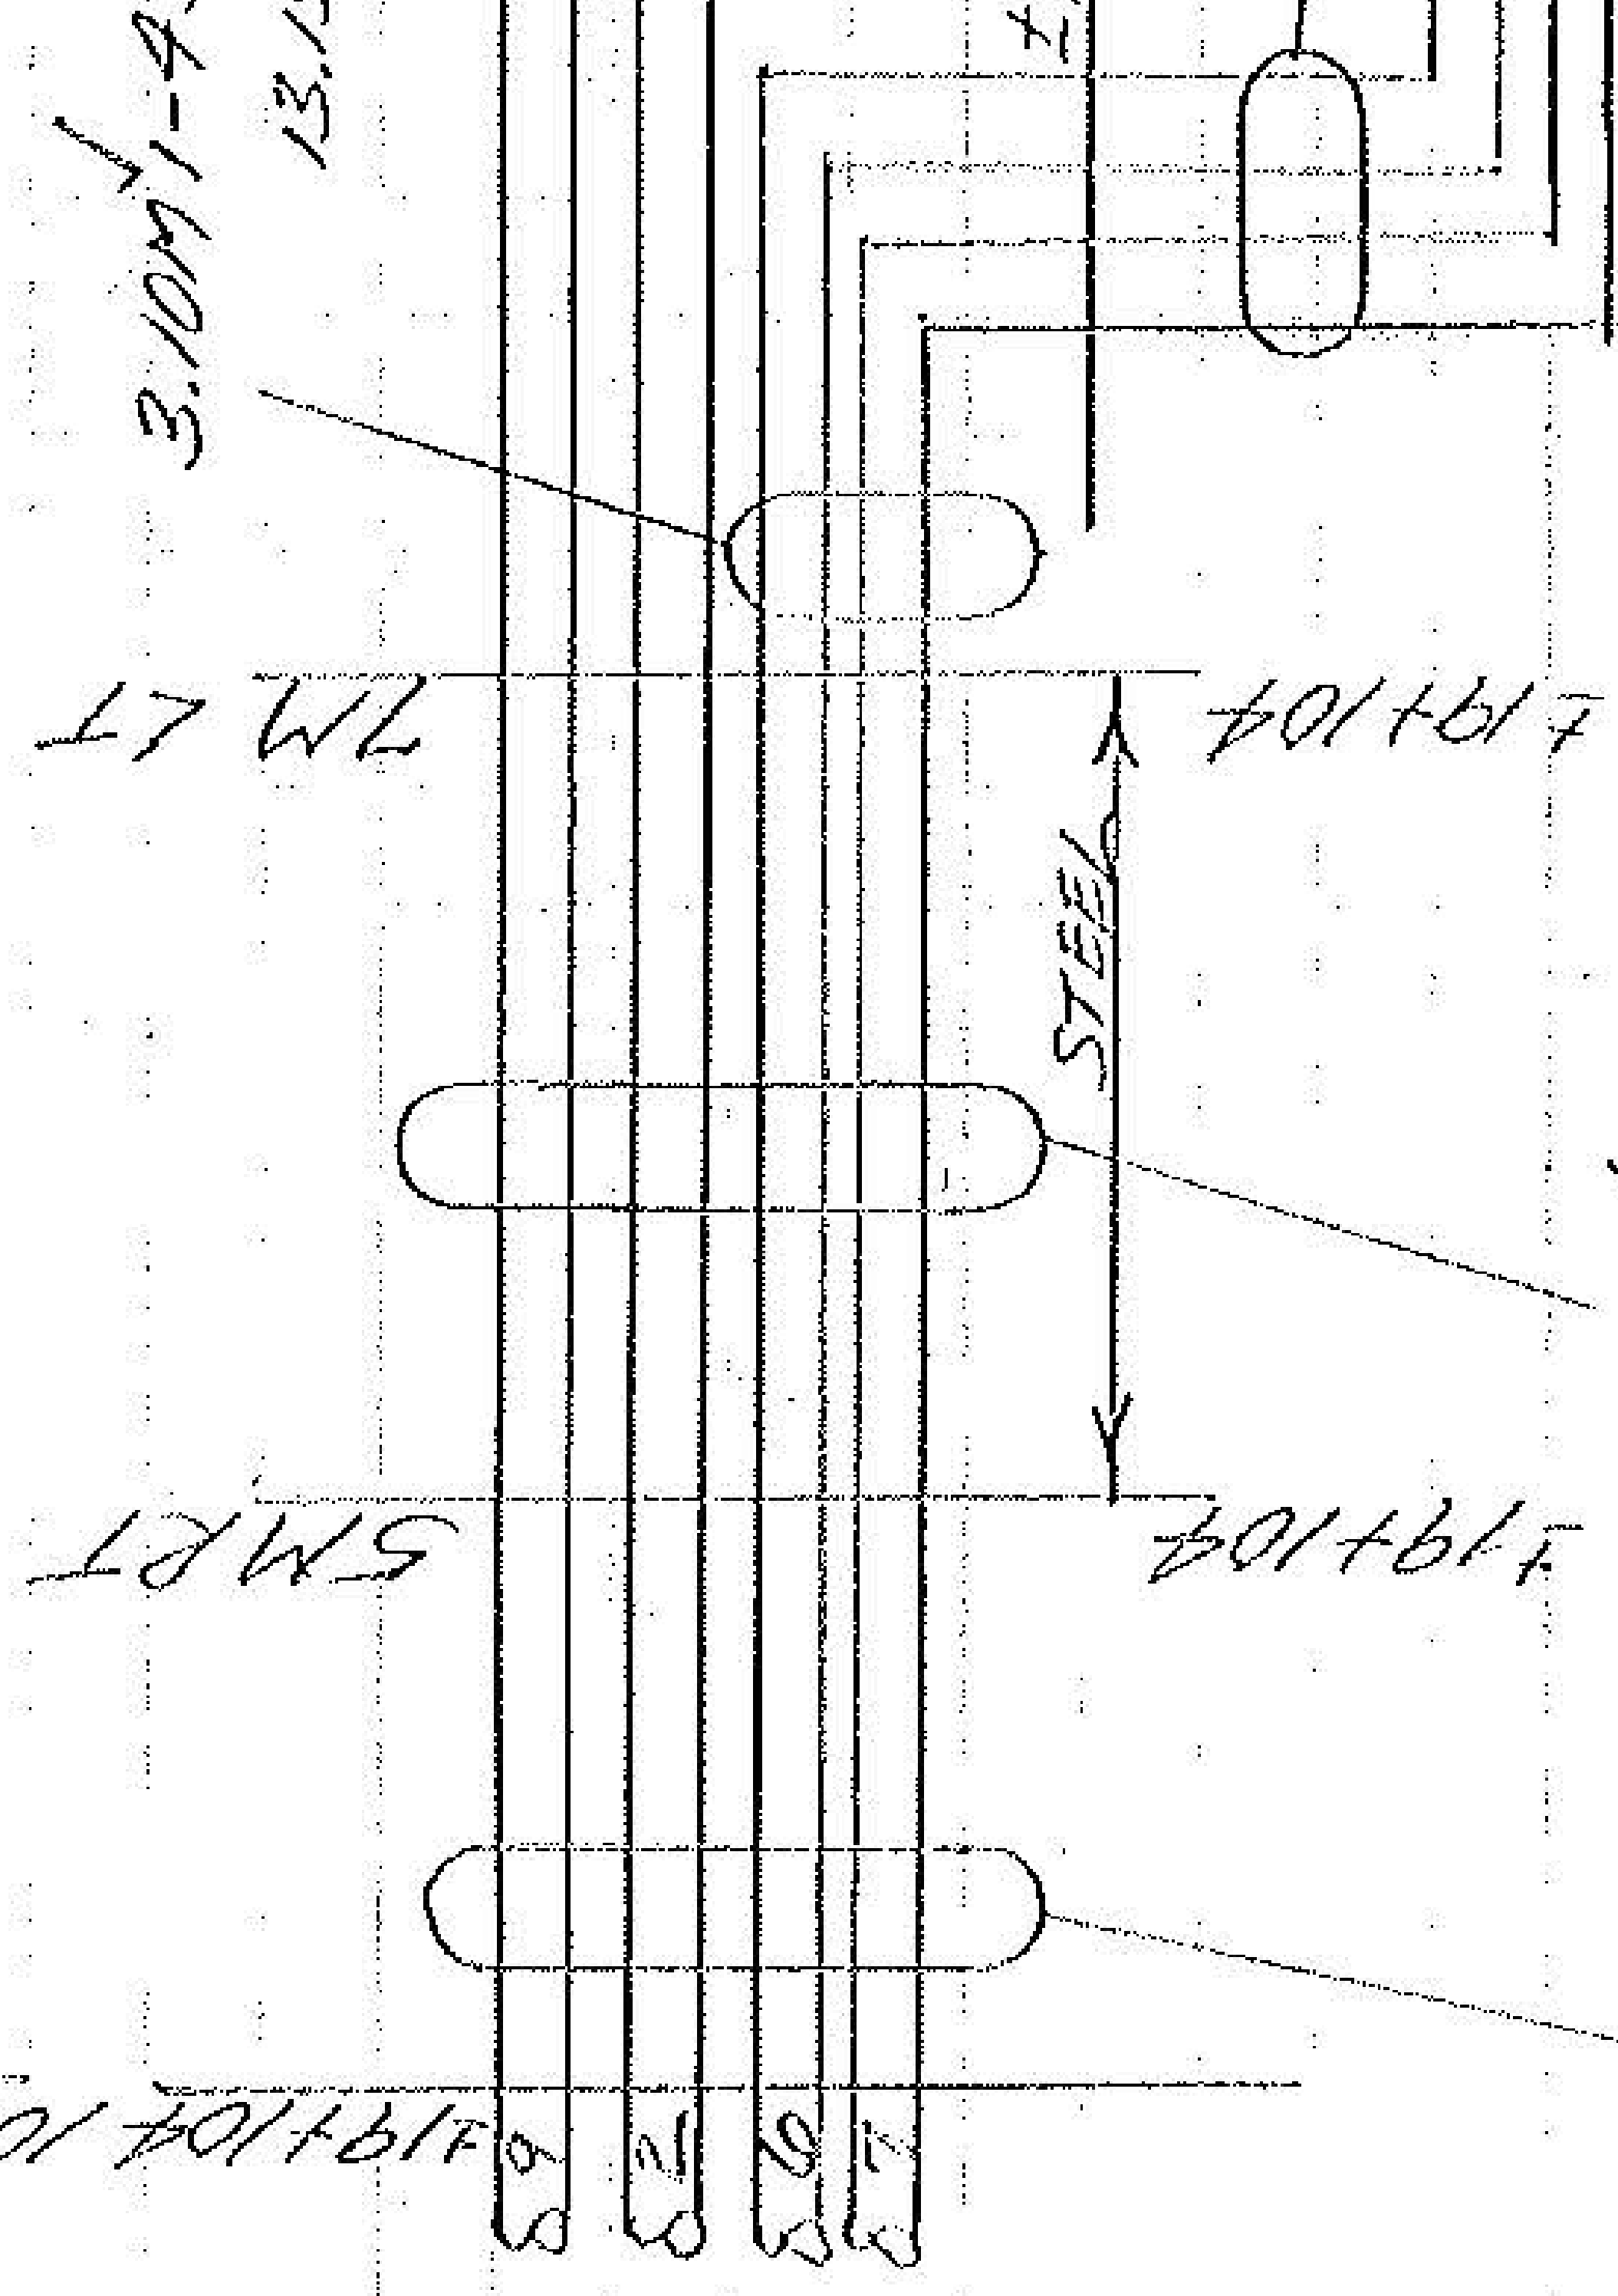

5MPT

7M LT

3.10M¹⁻⁴

13.1

5/15/2012

Y

DUCT
AREA
RELAT