

[illegible][illegible]

Technical drawing of a 'ONE WAY' street sign. The sign is rectangular with a black border. It features a large black arrow pointing upwards on the left side and a large black arrow pointing to the right, curving upwards, on the right side. The word 'ONE WAY' is written in large, bold, black capital letters at the bottom. Dimensions are provided in feet and inches:

- Overall width: 3' 0"
- Overall height: 4' 0"
- Arrow height (left): 11' 1/2"
- Arrow height (right): 12' 0"
- Arrow width (left): 2' 1/2"
- Arrow width (right): 2' 1/2"
- Arrow curve radius: 12' 0"
- Arrow curve angle: 90°
- Arrow curve start height: 5' 1/2"
- Arrow curve end height: 8' 0"
- Arrow curve start width: 1' 1/2"
- Arrow curve end width: 1' 1/2"
- Arrow curve start angle: 45°
- Arrow curve end angle: 135°
- Arrow curve start distance from bottom: 1' 1/2"
- Arrow curve end distance from bottom: 1' 1/2"
- Arrow curve start distance from left: 1' 1/2"
- Arrow curve end distance from left: 1' 1/2"
- Arrow curve start distance from right: 1' 1/2"
- Arrow curve end distance from right: 1' 1/2"
- Arrow curve start distance from top: 1' 1/2"
- Arrow curve end distance from top: 1' 1/2"

Temp 4" White

250' TAPER

MM 3.90


Durable 8" Yellow (Diag.)

Durable 4" Yellow (obl.)


RIGHT LANE FOR RIGHT TURN

3.90 RT.

NOT TO SCALE

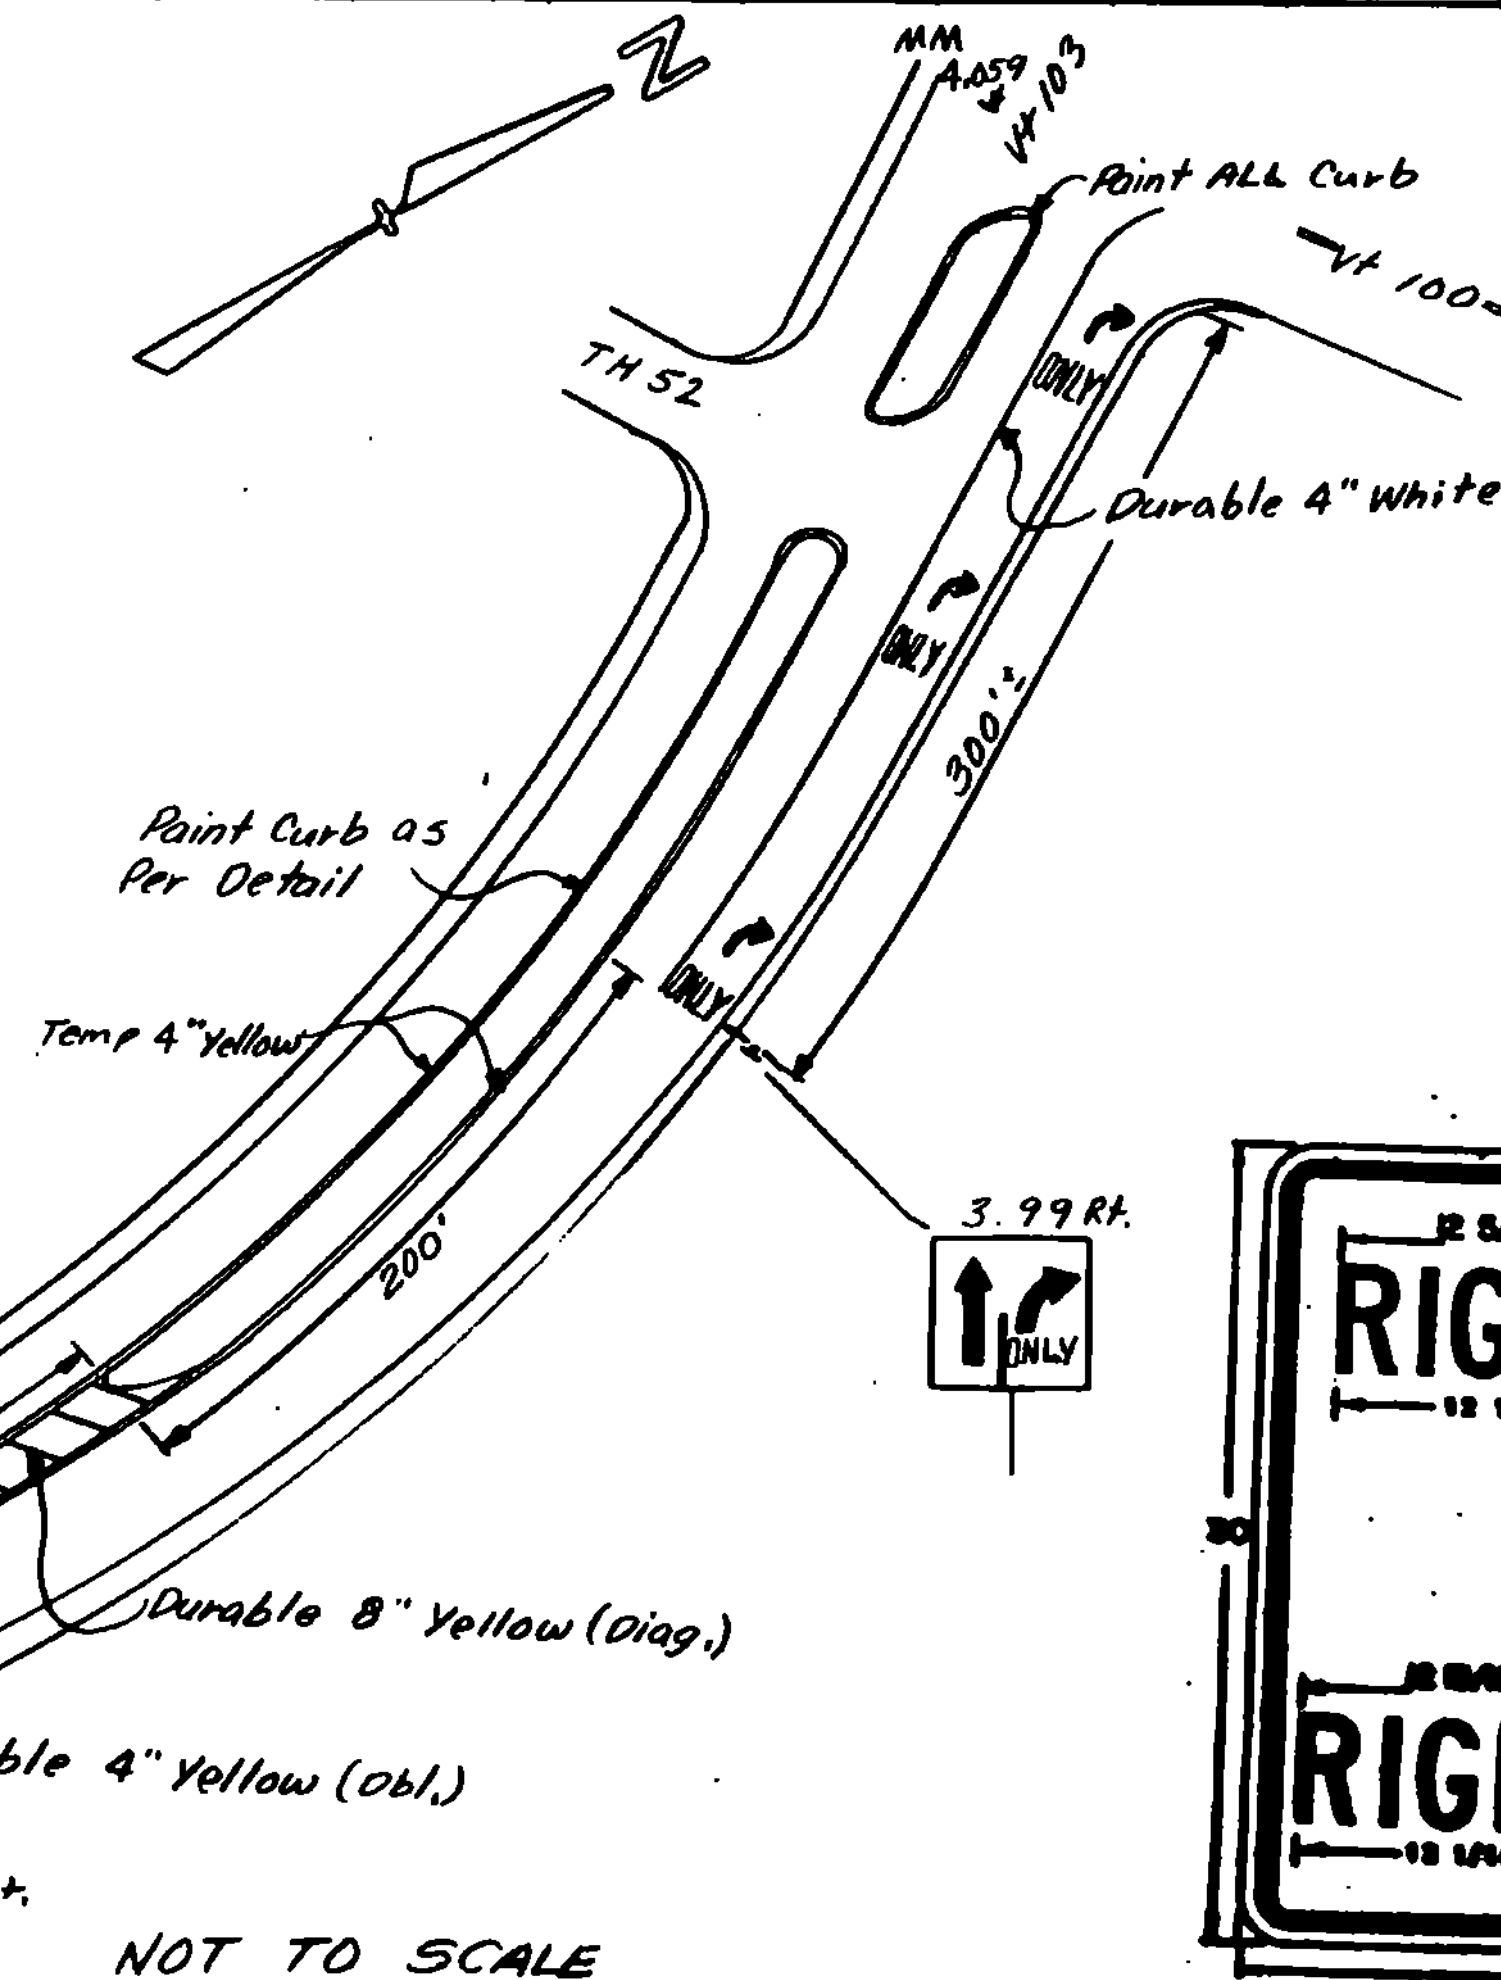

MILE	MILE	LT.	RT.	QTY. LEFT	QTY. RT.	TOTAL
2.00	2.20	Solid	Solid	1785	1785	3570
3.20	3.55	Dash	Dash		462	462
3.55	2.64	Dash	Solid	119	475	594
3.64	3.90	Solid	Solid	1373	1373	2746
						7372
			4 TH'S 60' x 2		-	320
						7052
			100% lost in leveling		+	7052
						14104
			Edges in around Islands		+	800
					TOTAL	14904

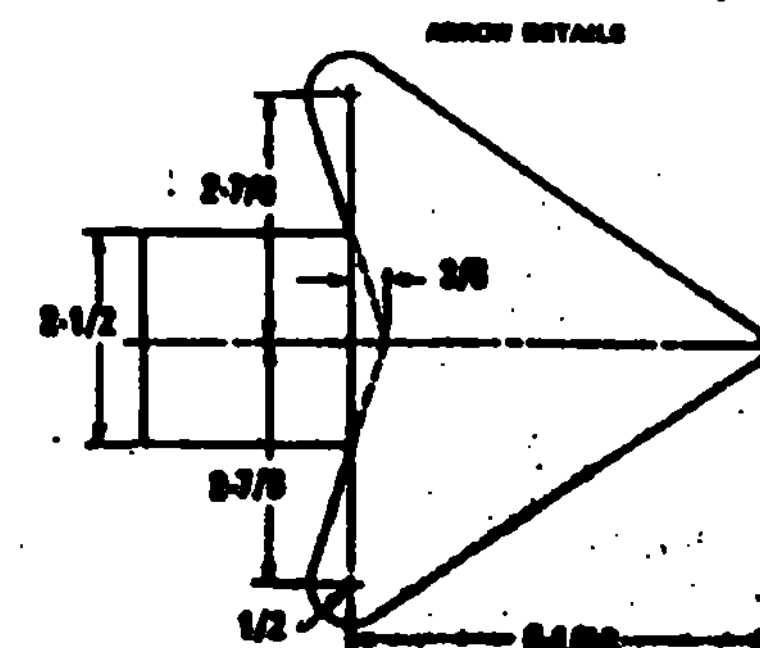[illegible]

DRAWN BY JB DATE 12-8
 CHECKED BY _____ DATE _____
 LUDLOW
 PROJ. F NO. 025-1(29)5
 TRAFFIC SHEET NO. 522 SHEET 4 OF 40