
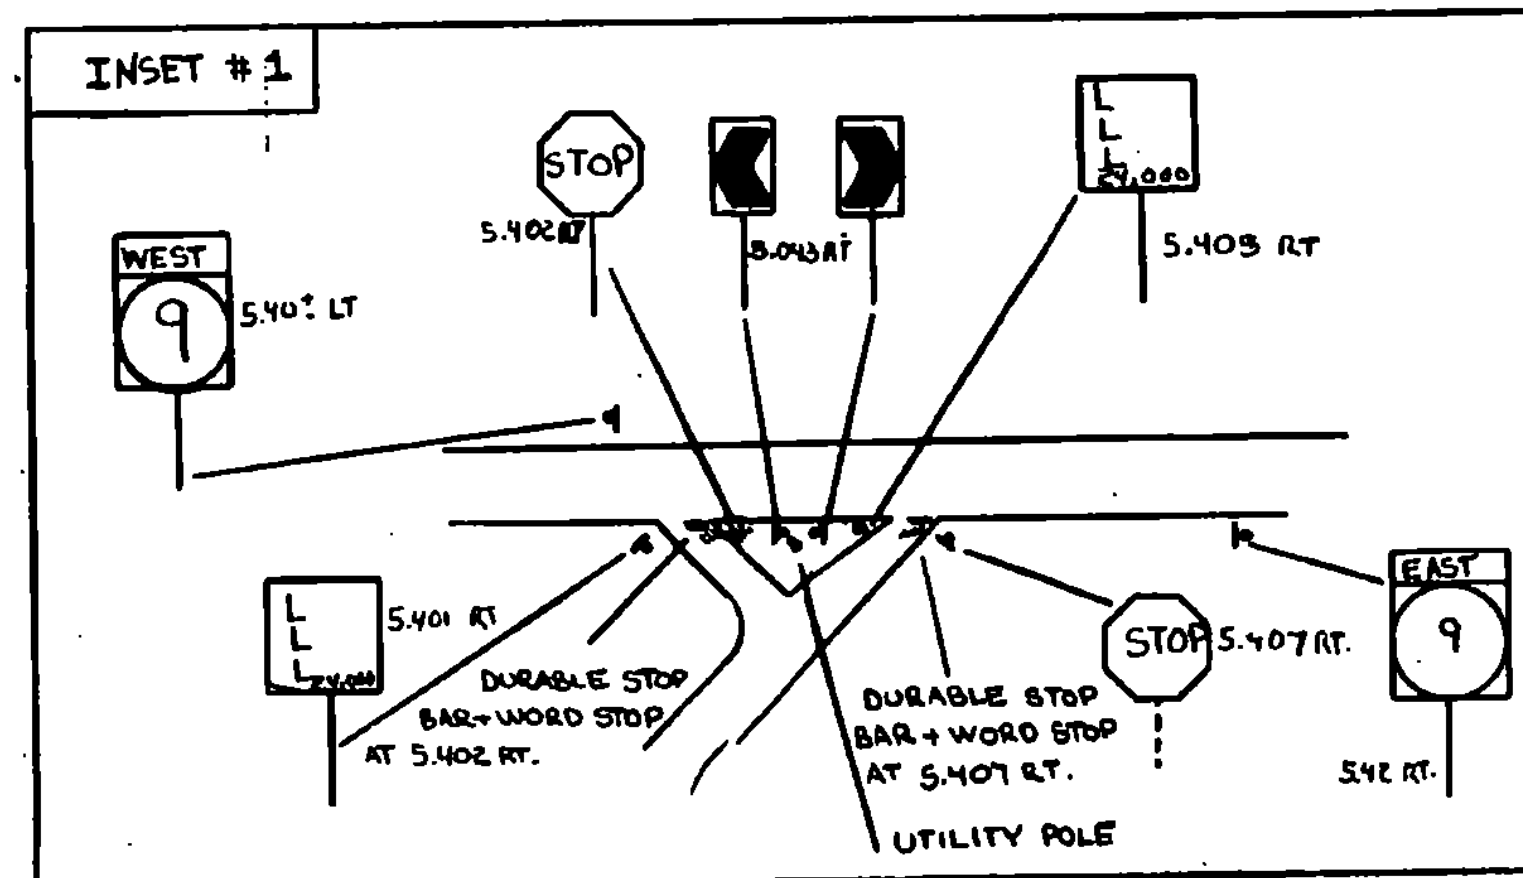


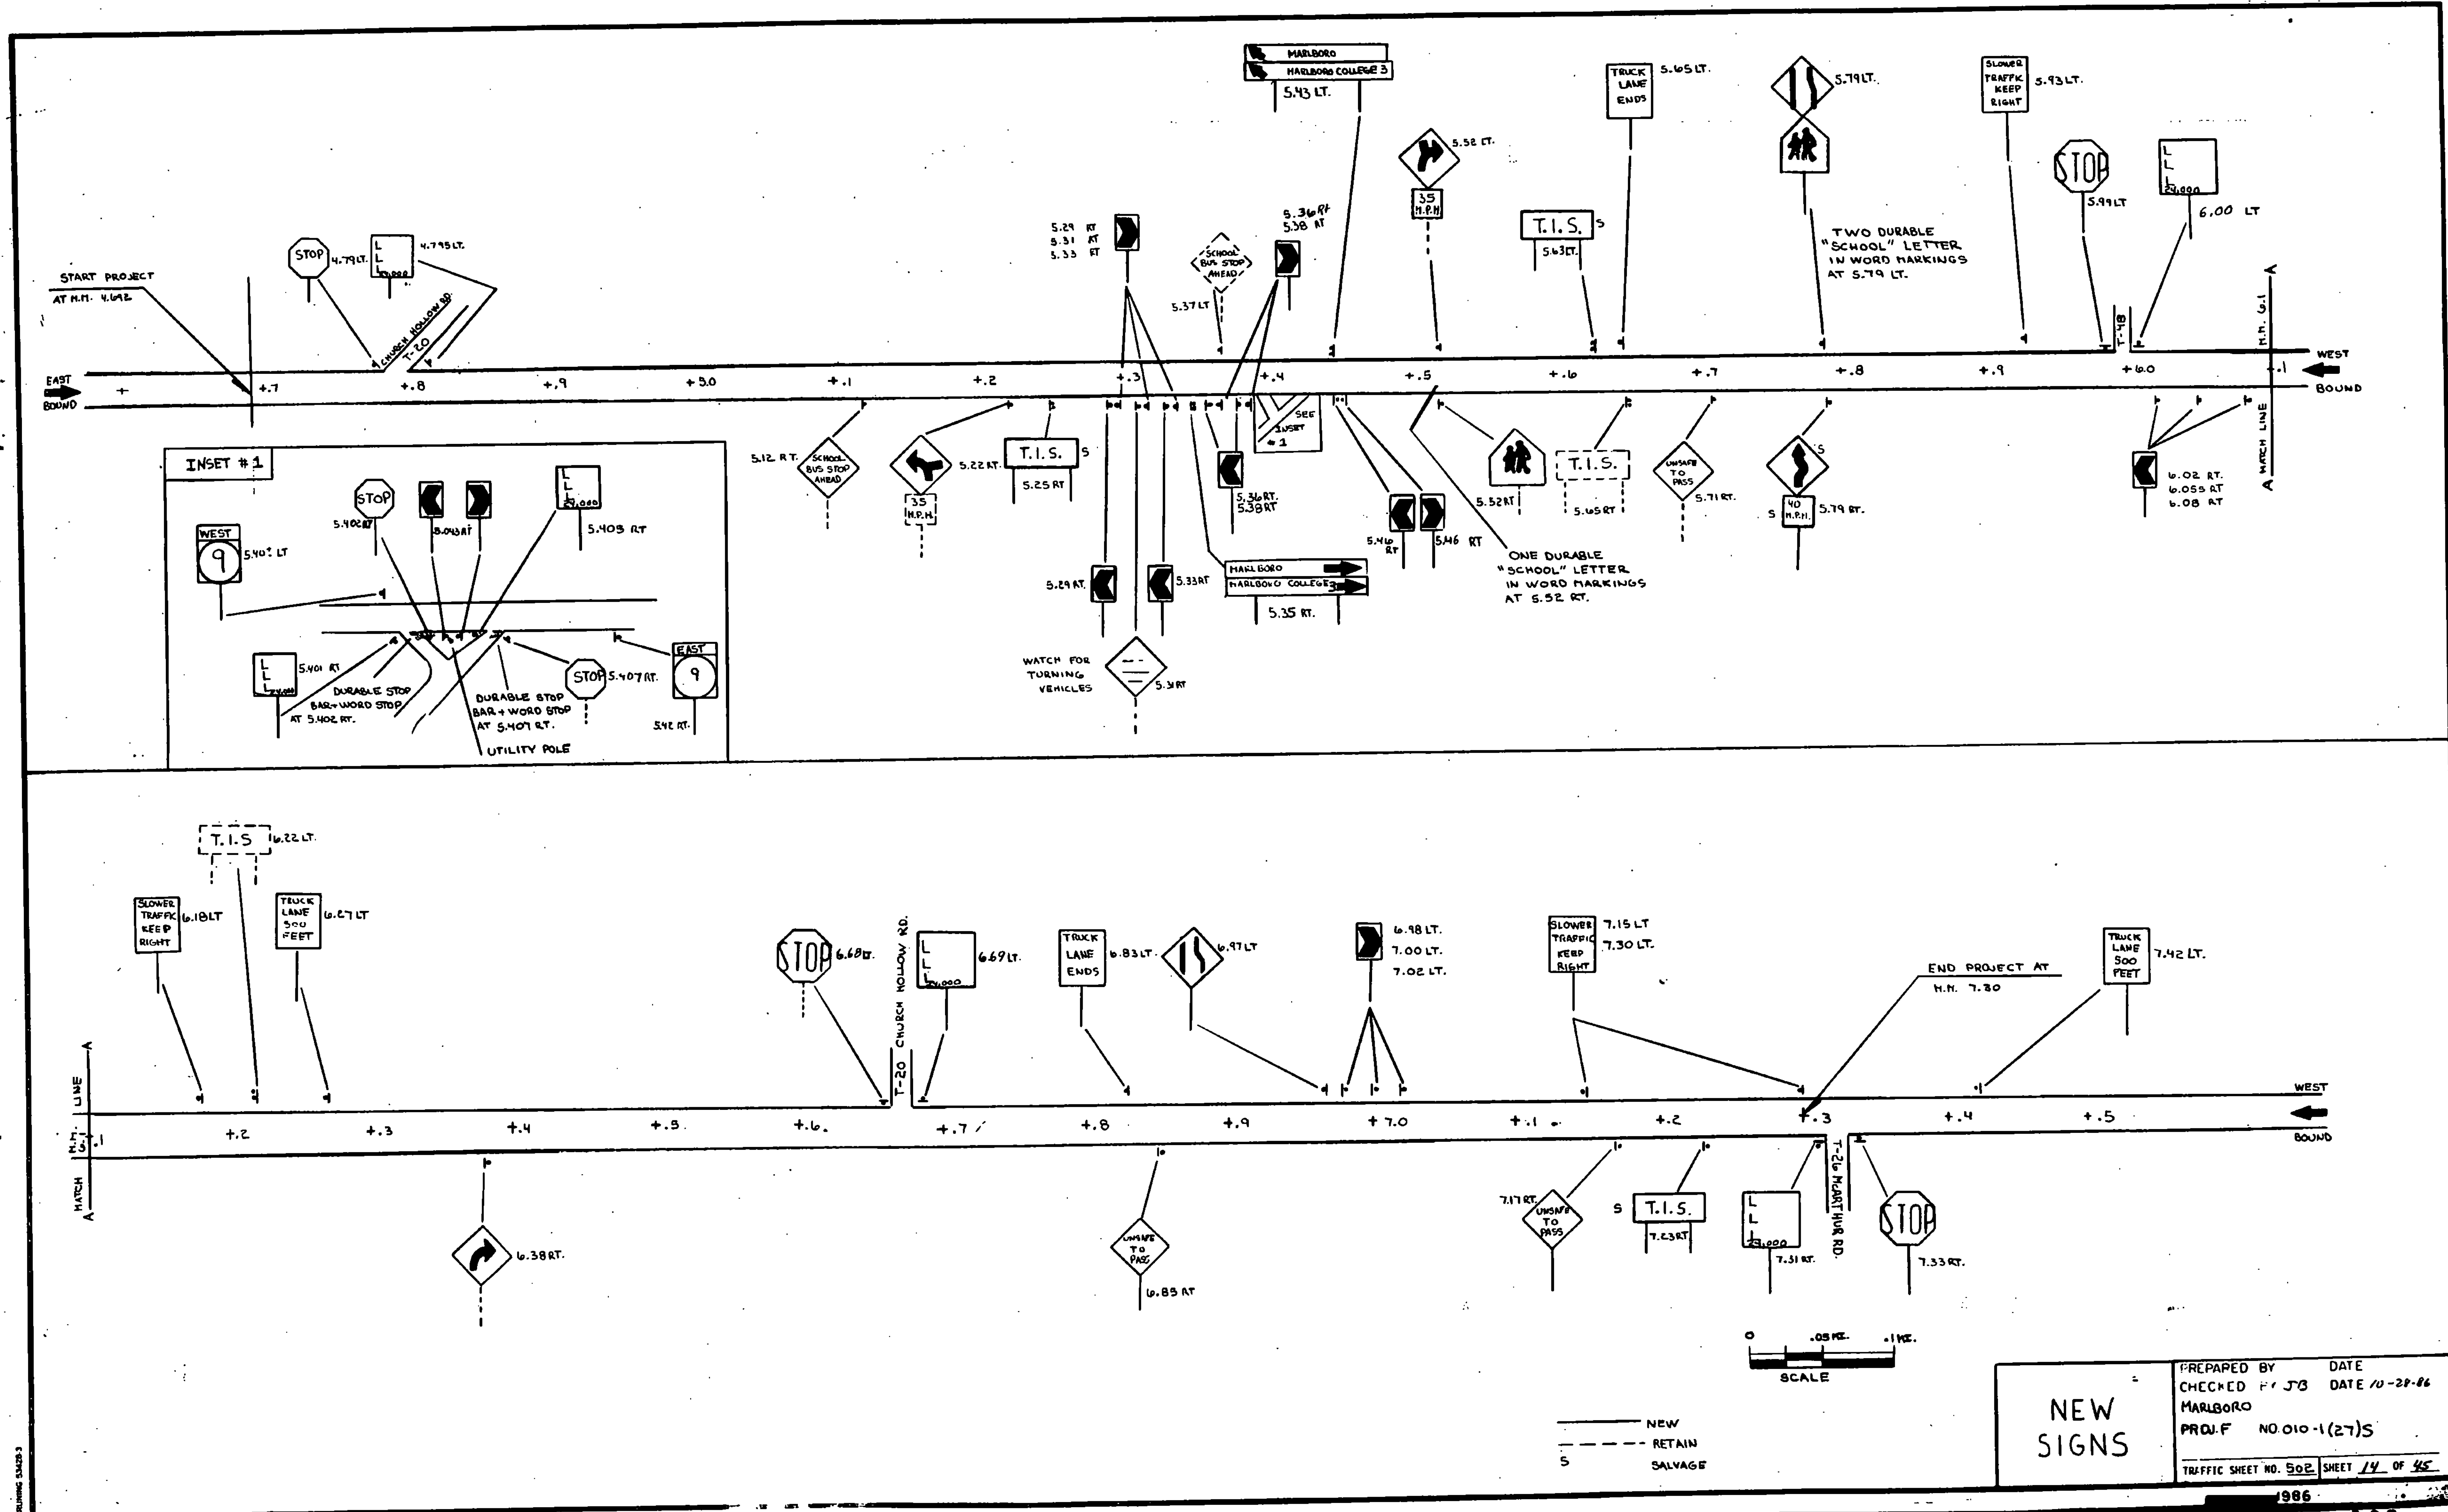

NEW SIGNS	PREPARED BY	DATE
	CHECKED BY J.B.	DATE 10-28-86
	MARLBORO	
	PROJ. F NO. 010-1(27)S	
TRAFFIC SHEET NO. 502		SHEET 14 OF 45