


[illegible]

NOTES AND DETAILS

TEMPORARY 4" WHITE LINE						
MILE	MILE	LT.	RT.	QTY. LEFT	Σ SMALL DASH	QTY. RT. (LF) TOTAL
4.682	7.30	SOLID CLIMBING DASH	SOLID LARGE DASH	13770		13770 27940
5.623	6.18	CLIMBING DASH	LARGE DASH		700	700
6.83	7.3	CLIMBING DASH	LARGE DASH		620	620
						TOTAL 28860

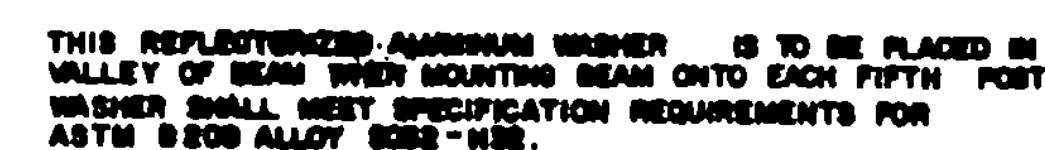

DRAWN BY _____ DATE _____
 CWKED BY JTB DATE 10-28-90
 MARLBORO
 PROJ. # NO 010-1(27)S
 TRAFFIC SHEET NO. 506 SHEET 18 OF 45