


- LEGEND
- EXISTING
  - R REMOVE
  - RET RETAIN
  - R+S REMOVE AND SALVAGE

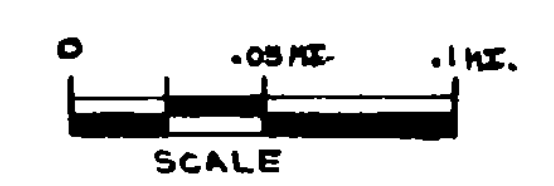

EXISTING SIGNS

PREPARED BY DATE  
 CHECKED BY J.B. DATE 10-28-76  
 MARLBORO  
 PROJ. F NO 010-1(27)S  
 TRAFFIC SHEET NO. 501 SHEET 13 OF 25