


TRAFFIC ITEM SUMMARY

ITEM NO.	ITEM	UNIT	QUANTITY	RNDS	TOTAL
Wb.21	PAINTED CURB	LF	1135	65	1200
MOD. Wb.30	DURABLE 4" WHITE LINE	LF	4341	59	4400
MOD. Wb.31	DURABLE 4" YELLOW LINE	LF	4342	58	4400
MOD. Wb.32	DURABLE 8" YELLOW LINE	LF	257	3	260
MOD. Wb.42	DURABLE ARROW MARKING	EA.	2	-	2
MOD. Wb.44	DURABLE LETTER IN WORD MARKING	EA.	8	-	8
MOD. Wb.46	DURABLE 8" WHITE LINE	LF	1	-	1
MOD. Wb.48	TEMP. 4" WHITE LINE	LF	75	-	75
MOD. Wb.51	TEMP. 4" YELLOW LINE	LF	1500	-	1500

NOTE:
ALL DURABLE MARKINGS ON THE FINAL COURSE SHALL BE INLAID DURABLE TAPE AND APPLIED AS PER MANUFACTURERS SPECIFICATIONS. SPECIFICATIONS SHALL BE SUBMITTED TO TRAFFIC DESIGN FOR APPROVAL PRIOR TO APPLICATION. FAILURE TO COMPLY SHALL RESULT IN NONPAYMENT FOR MARKINGS.

TEMPORARY MARKINGS SHALL BE APPLIED AT THE END OF EACH WORK DAY. TEMPORARY 4" YELLOW MARKINGS REQUIRED ARE APPROACHES TO ISLANDS AT THE BEGINNING AND END OF THE PROJECT AND 4" WHITE FOR THE LEFT TURN LANE LINE. ALL TEMPORARY MARKINGS SHALL BE TEMPORARY TAPE.

RAMP GORE MARKINGS, IF REQUIRED, ARE TO BE INLAID DURABLE 8" WHITE TAPE.

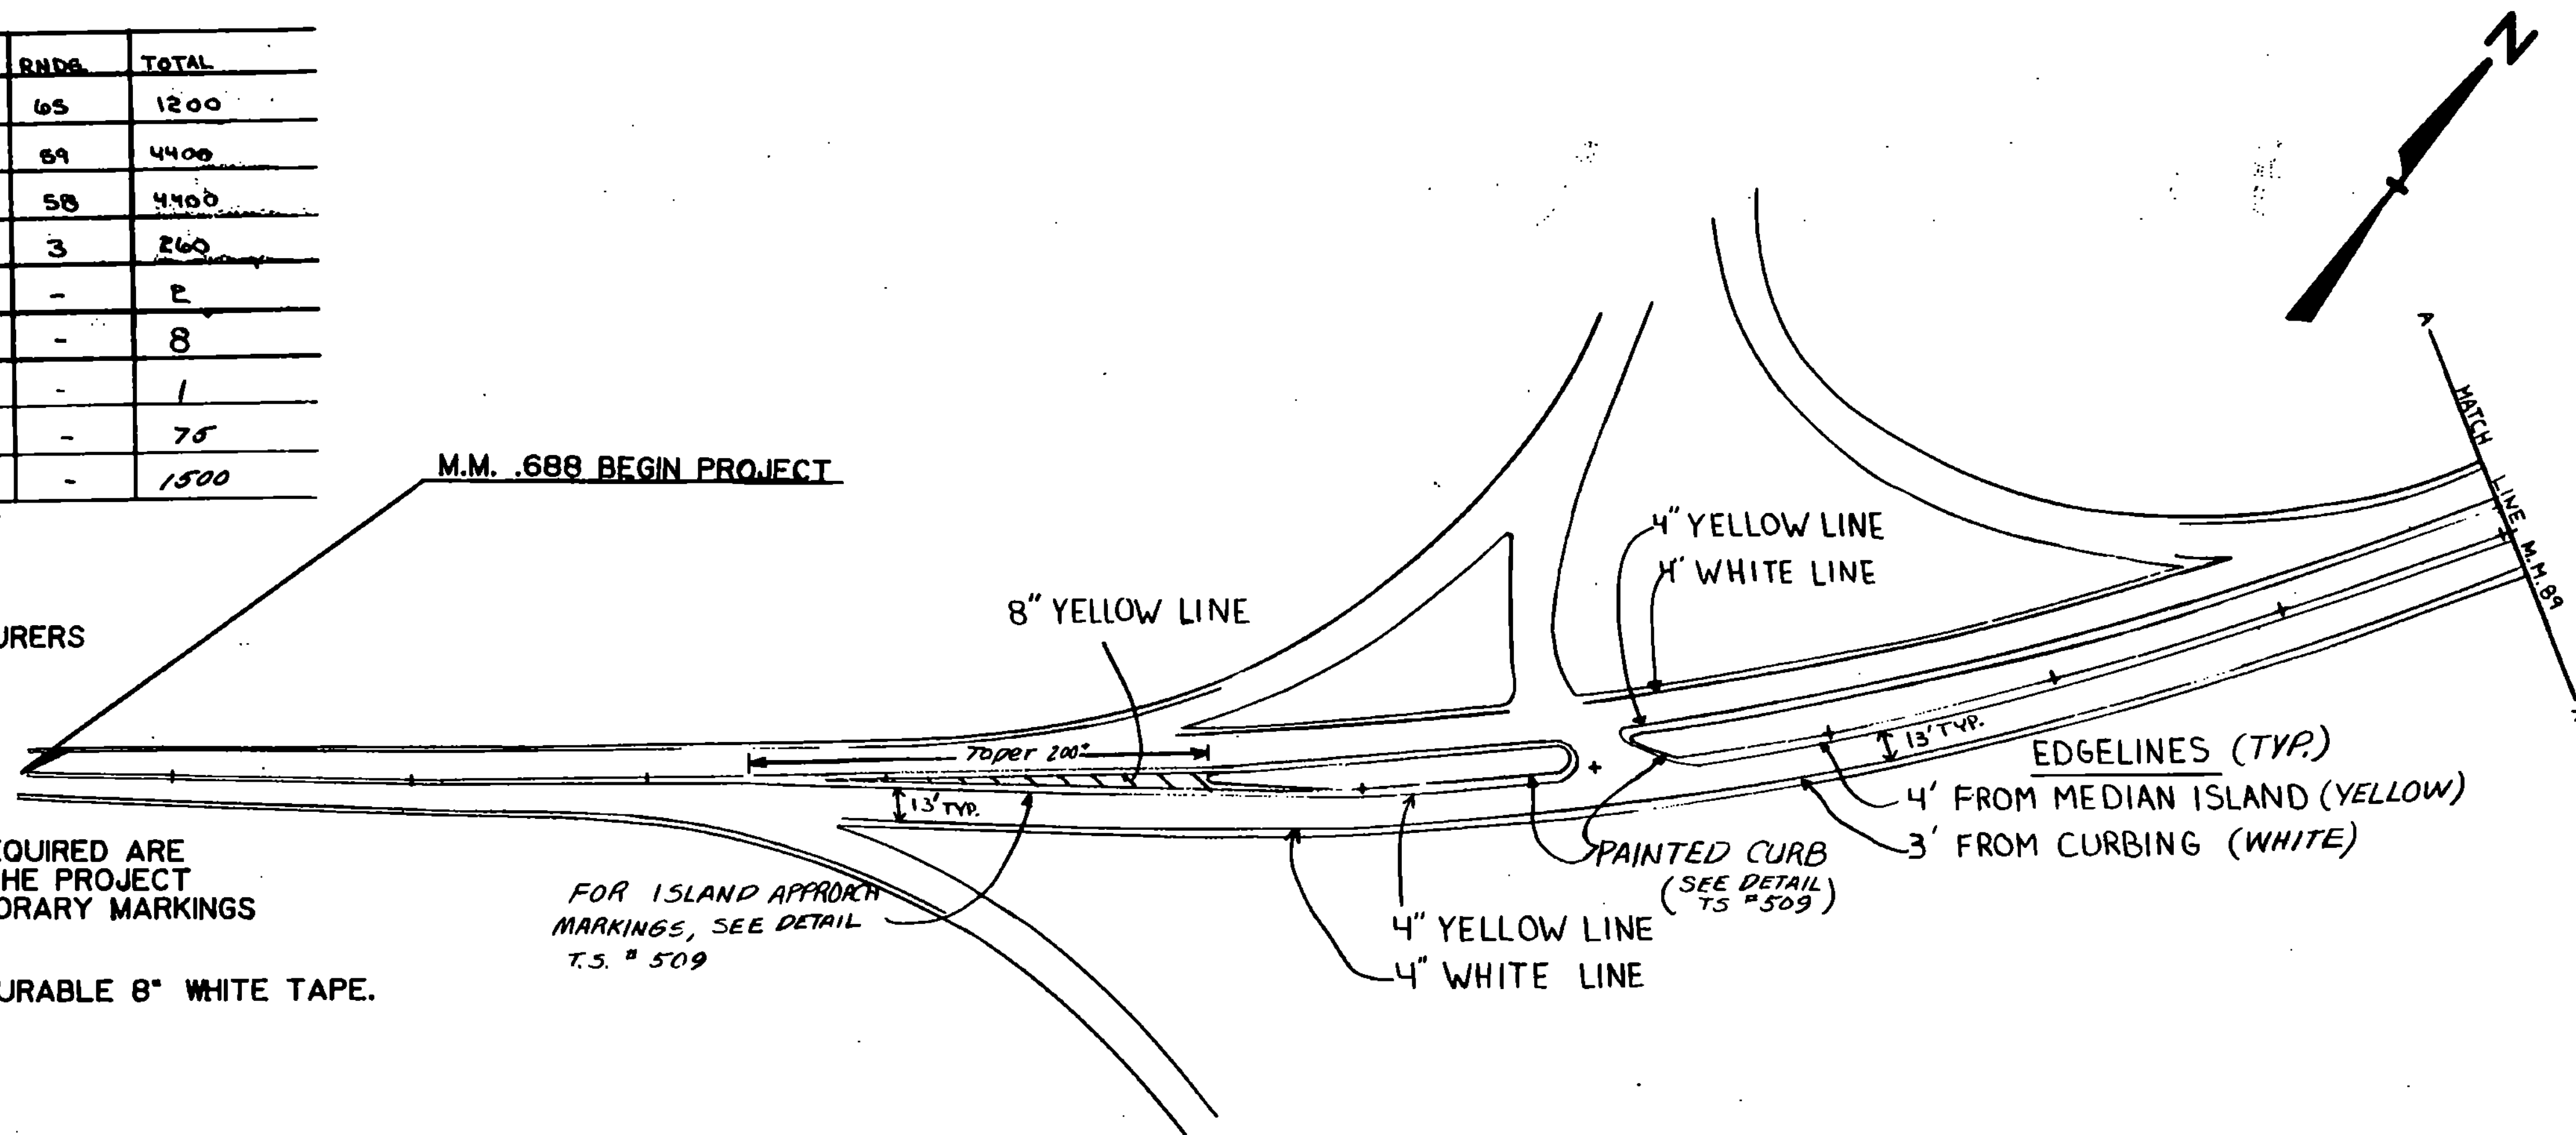

DURABLE LETTER IN WORD MARKING

"ONLY"
"ONLY" (AS SHOWN)

DURABLE 8" YELLOW LINE

PAINTED ISLAND-DIAGONAL LINES
(AS SHOWN)
(SEE DETAIL TS # 509)

DURABLE ARROW MARKINGS

(AS SHOWN)

PAINTED CURB



ALL ISLANDS (AS SHOWN)
SEE T.S. 509

DURABLE 4" YELLOW LINE

PAINTED ISLANDS AND DUAL
LT. TURN (AS SHOWN)

DURABLE 4" WHITE LINE

EDGE LINES AND LEFT TURN
LANE LINE (AS SHOWN)

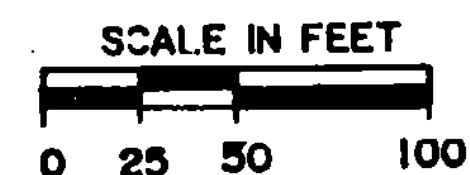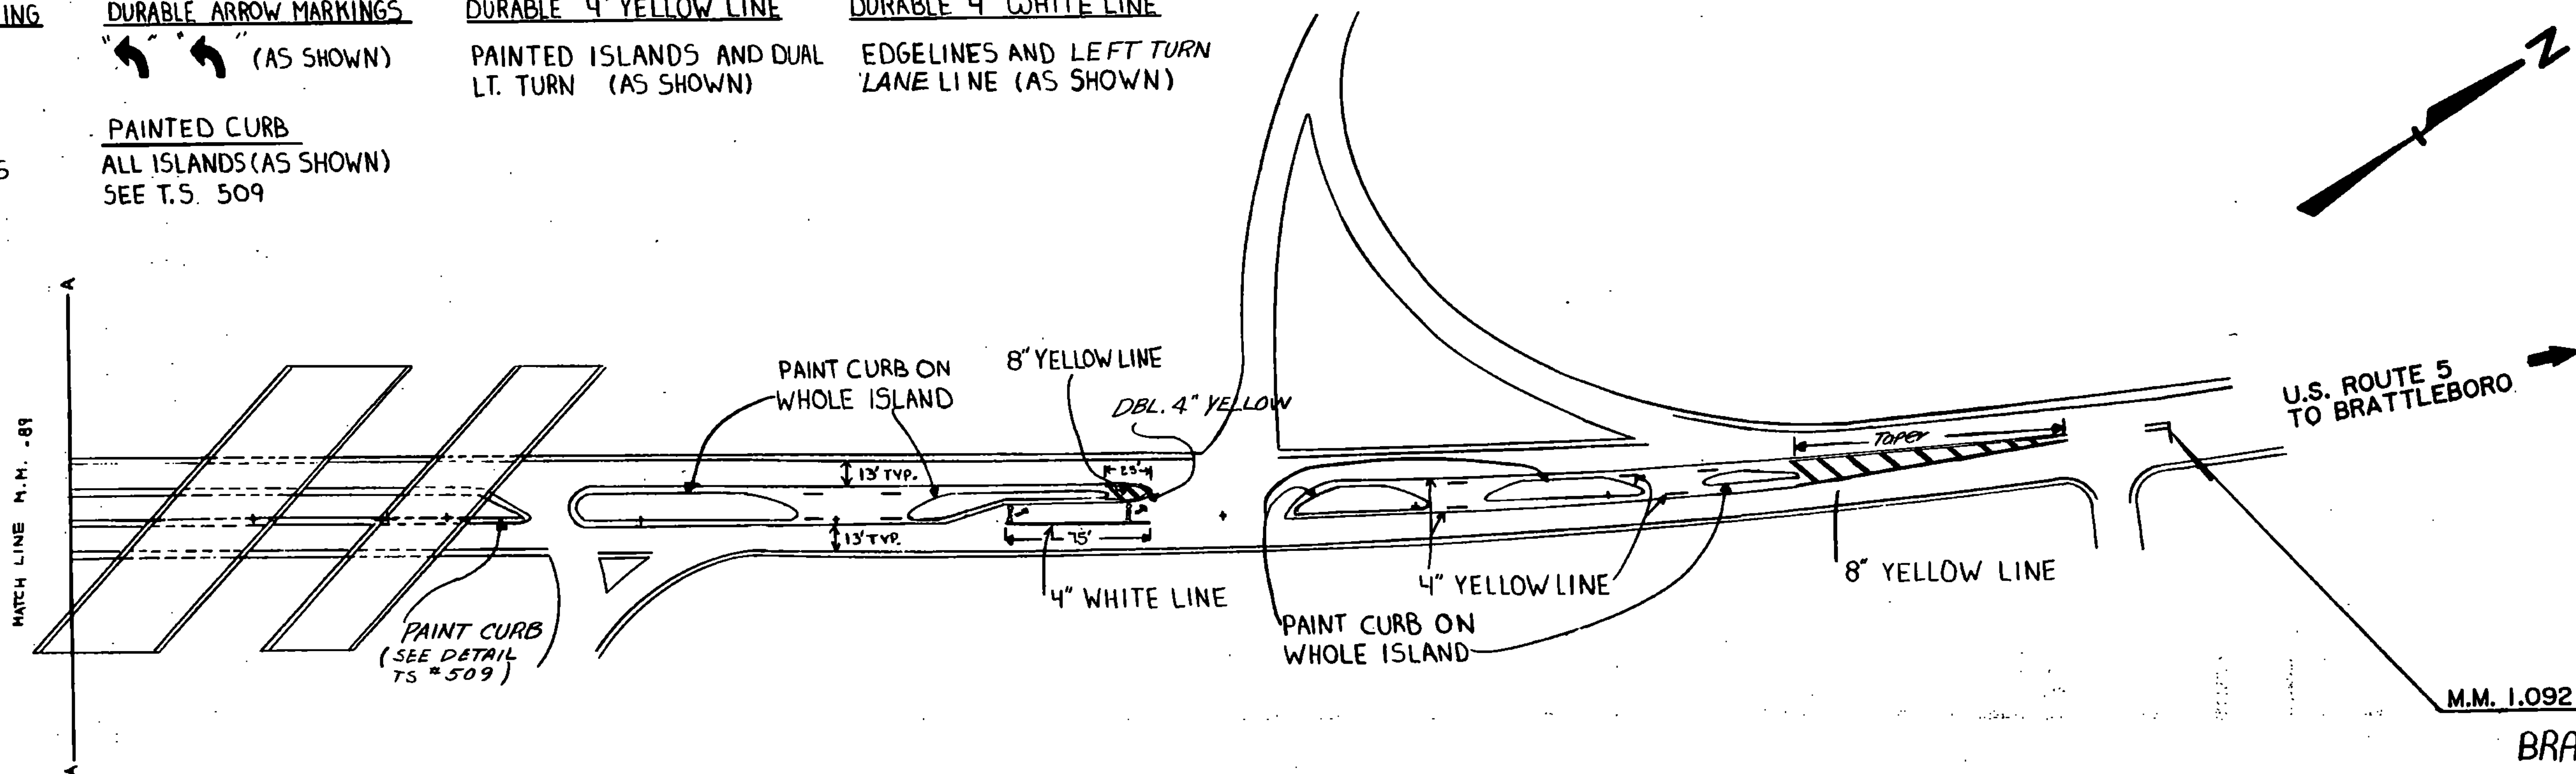

PREPARED BY _____ DATE _____
CHECKED BY J.B. DATE 10-31-8
BRATTLEBORO
PROJ. H NO. 2000(14)5
TRAFFIC SHEET NO. 1388 SHEET 20 OF 45