

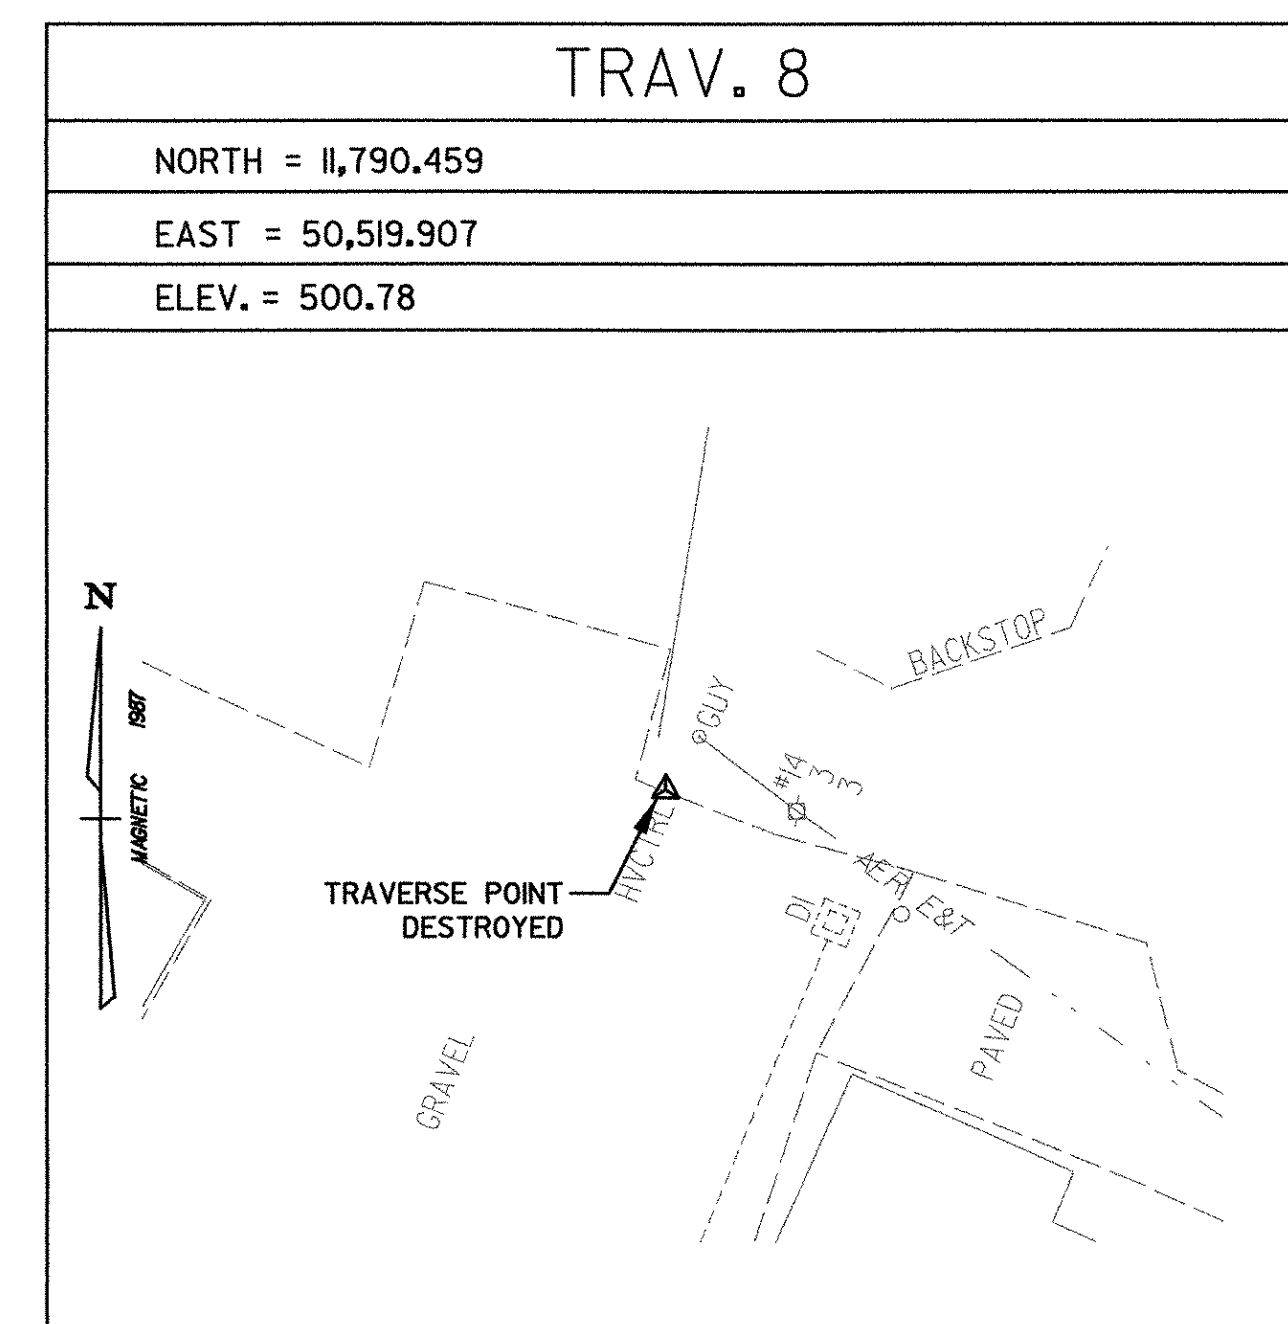
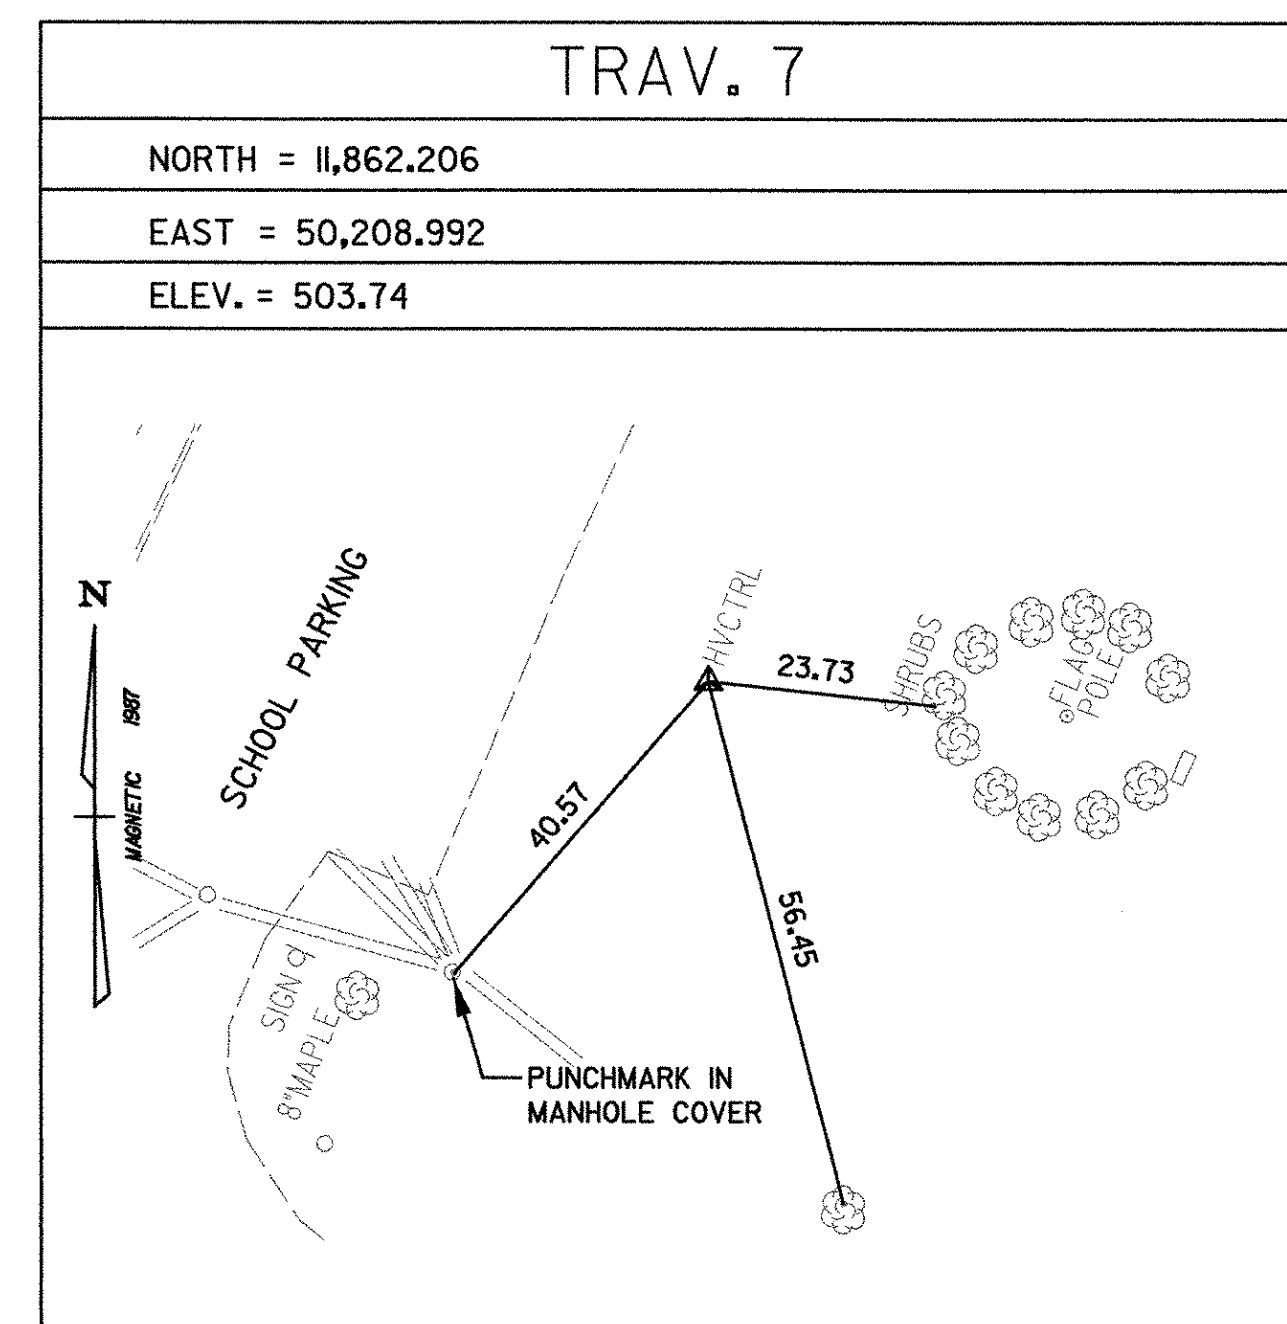
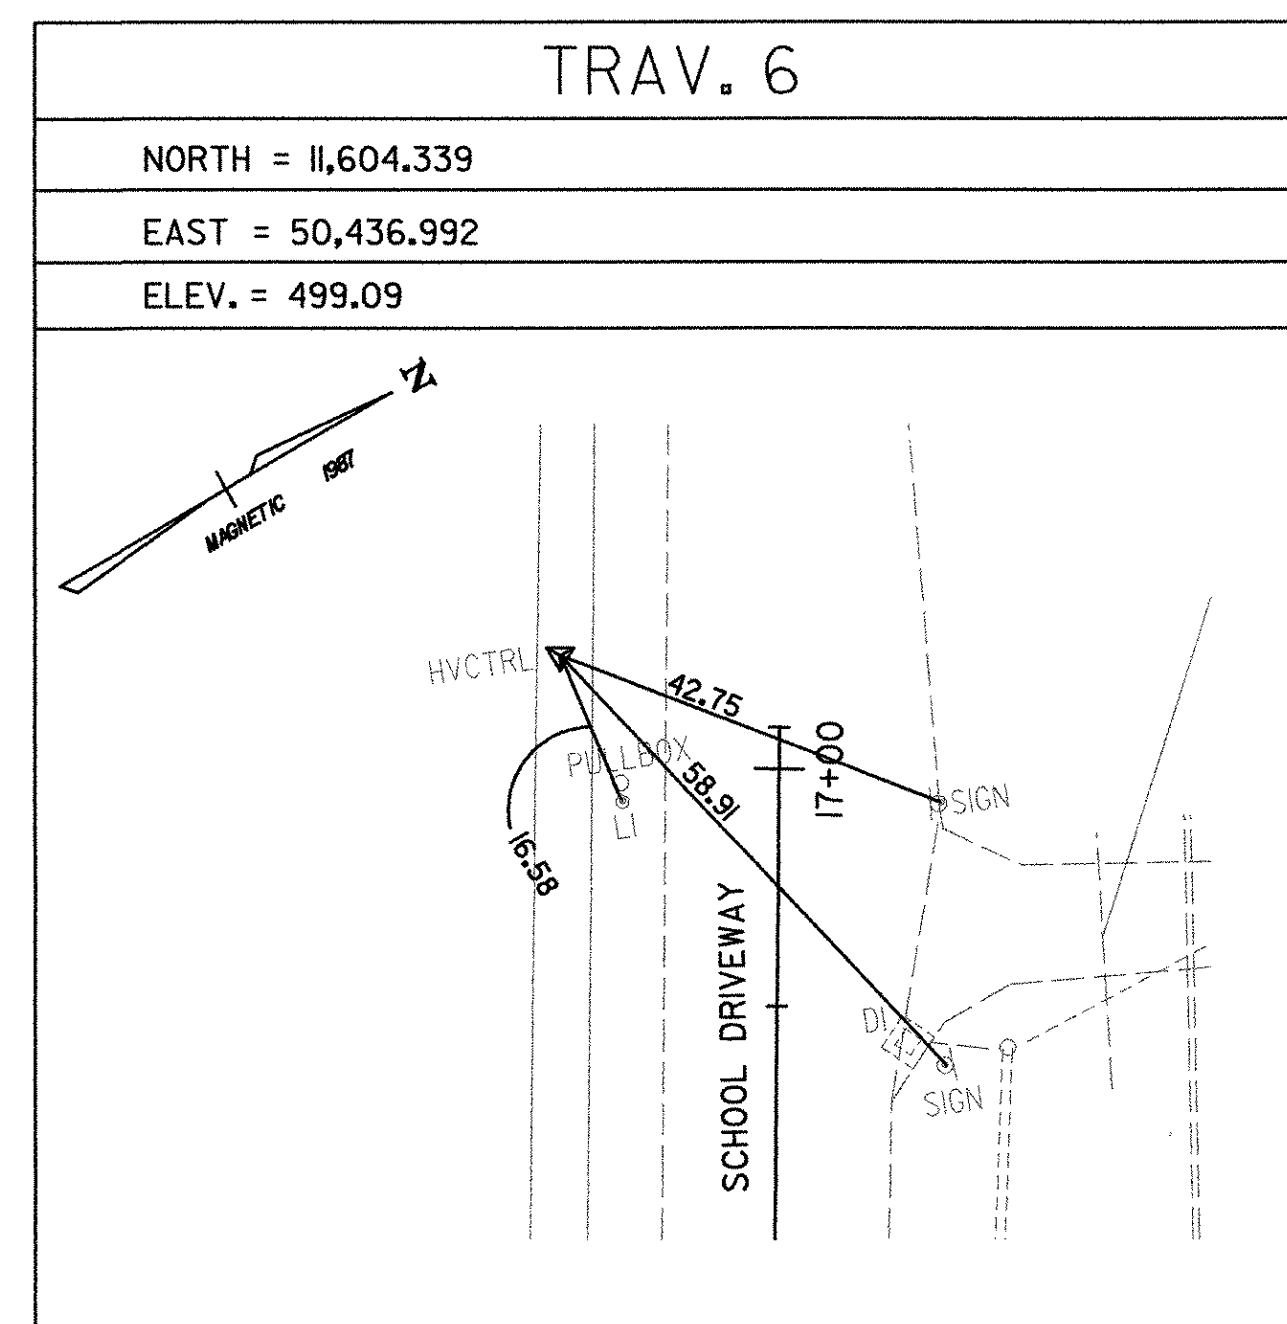
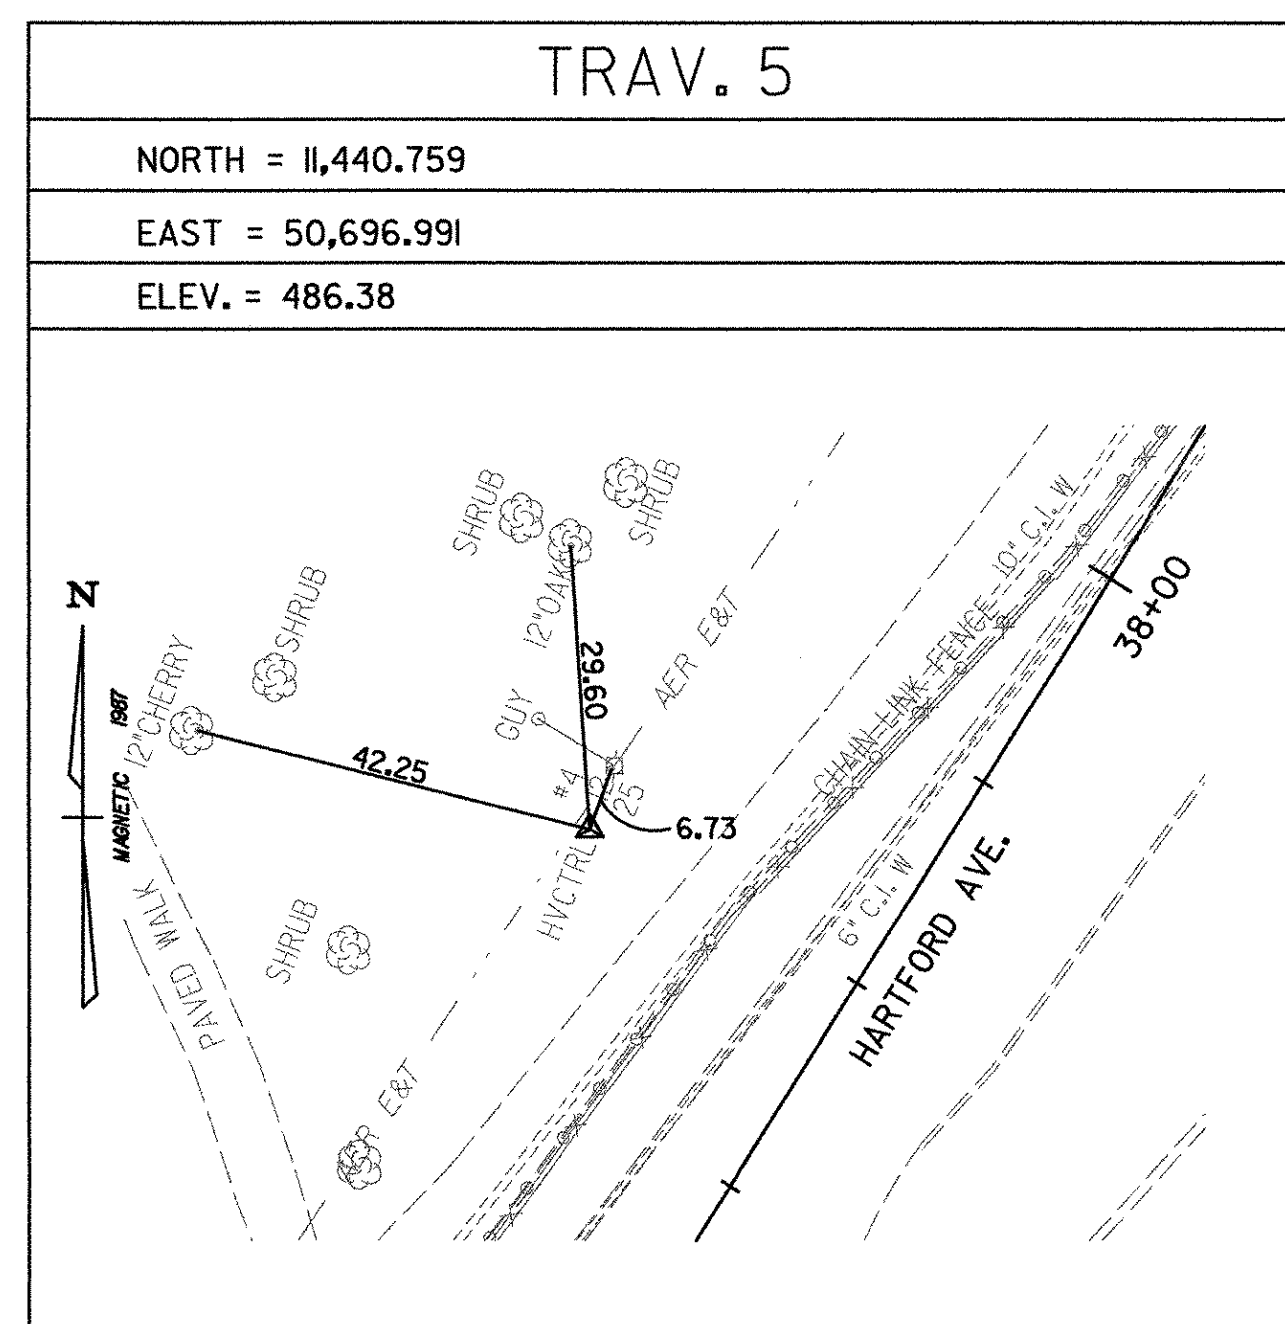
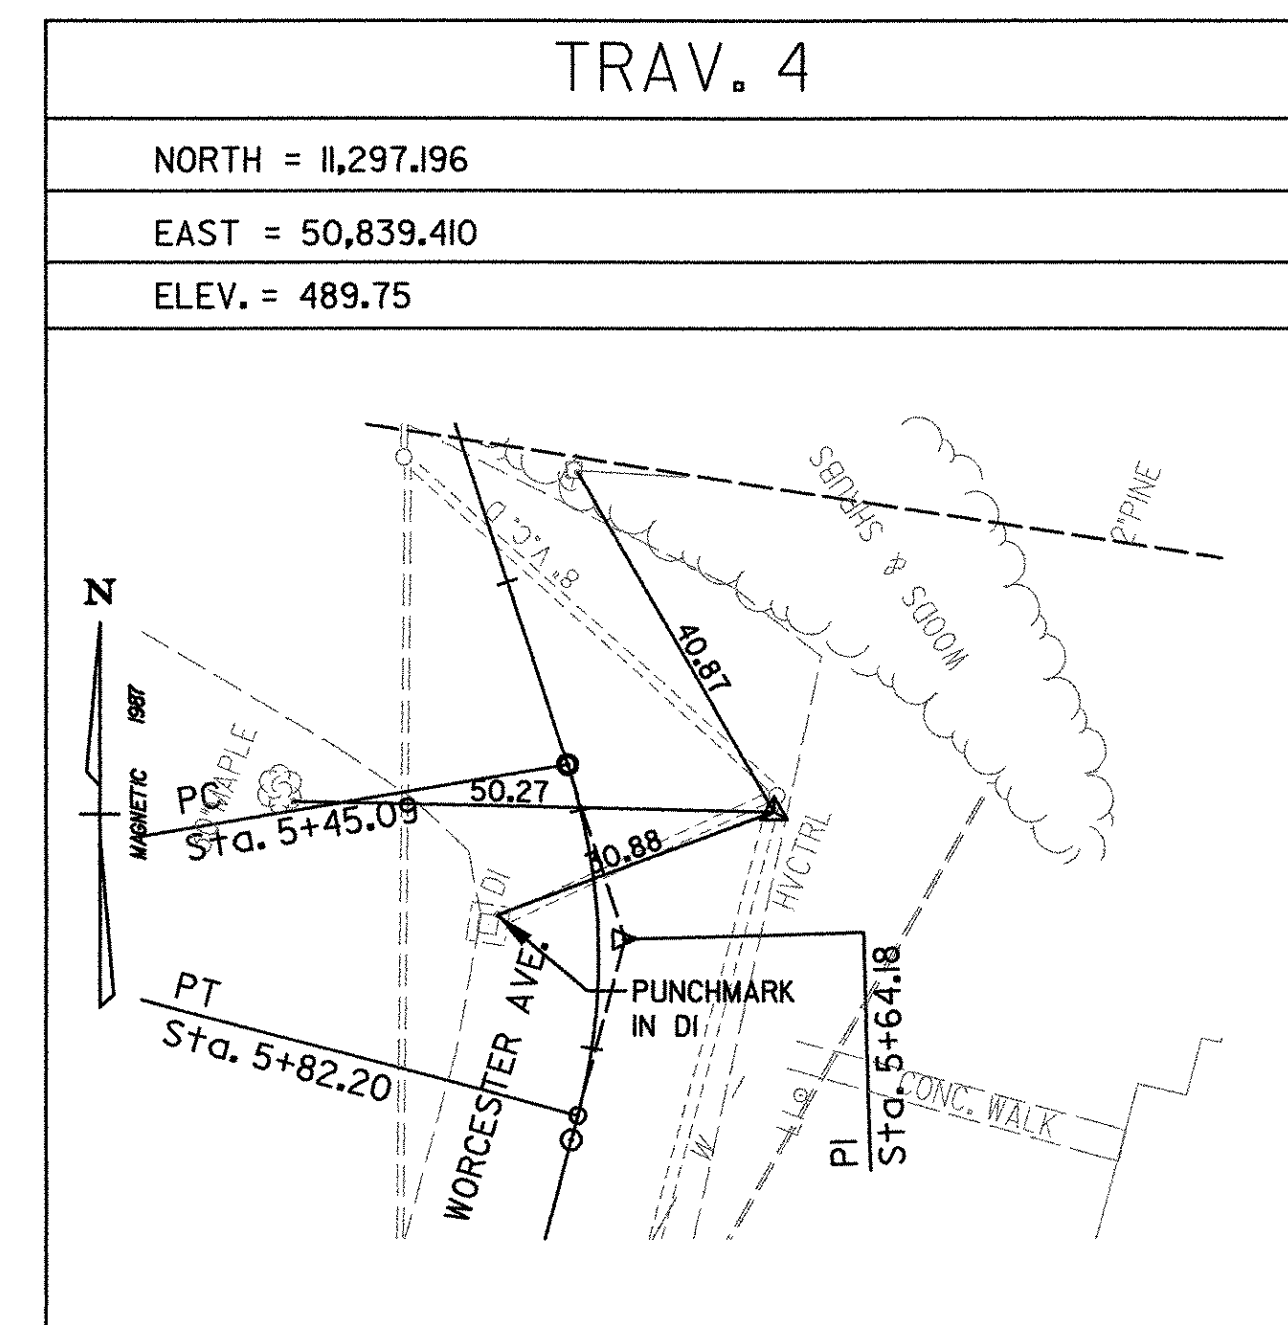
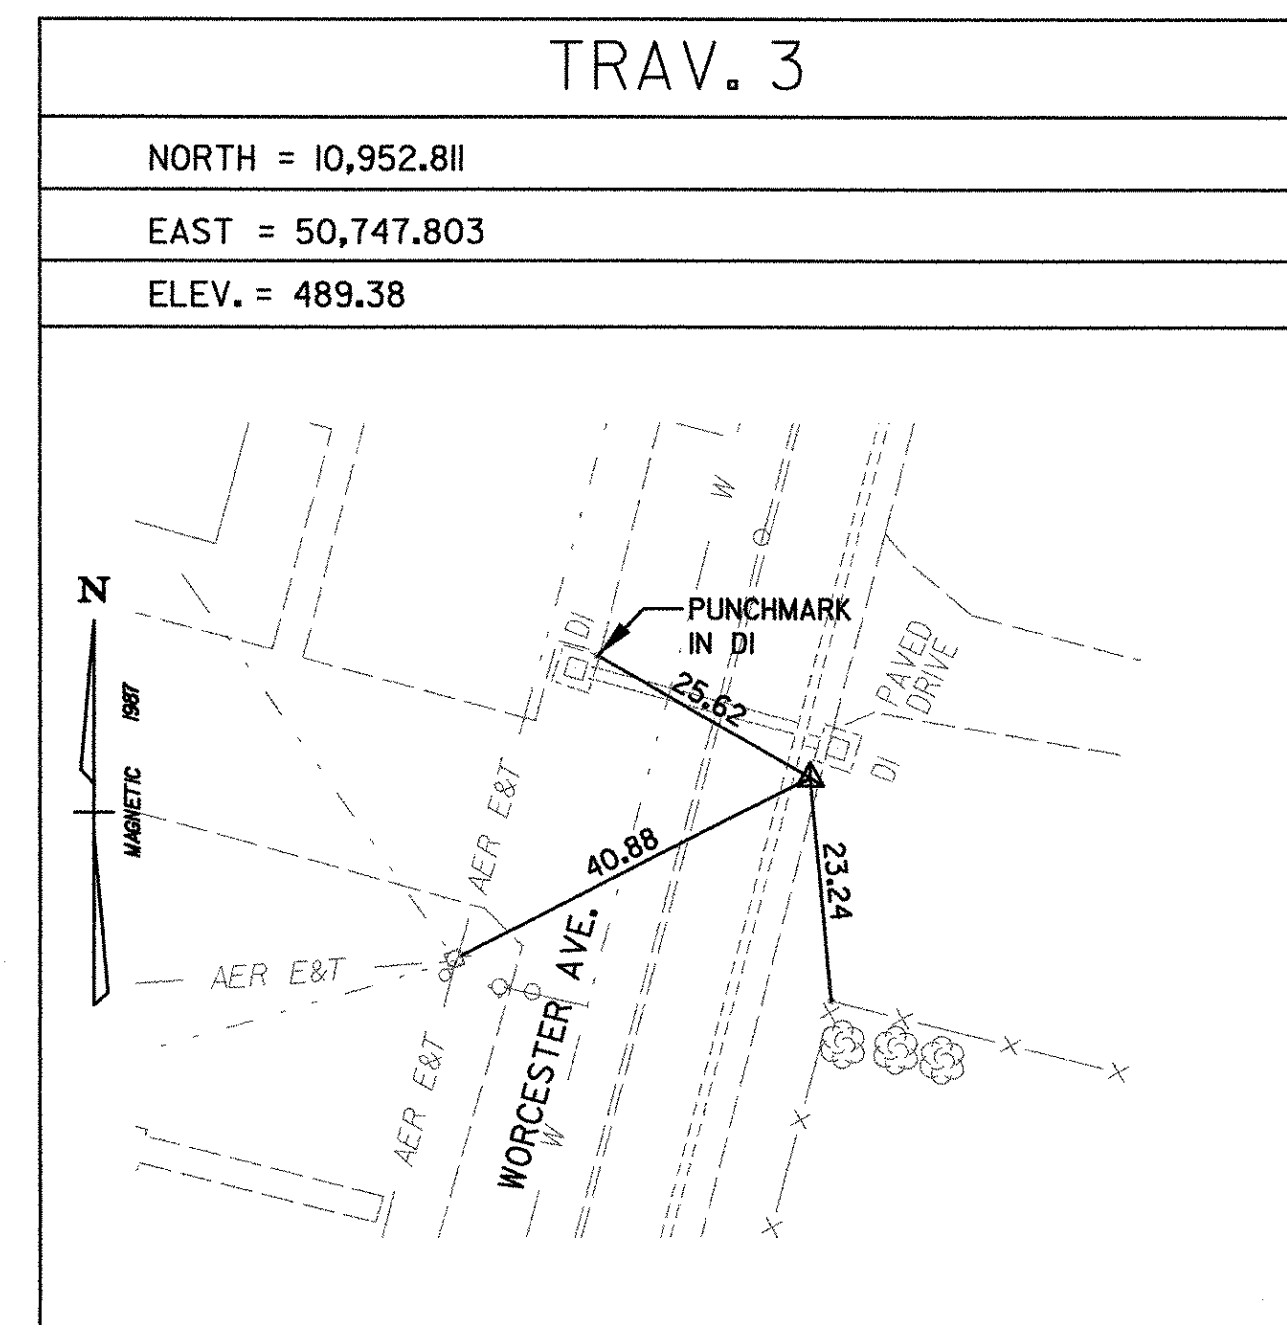
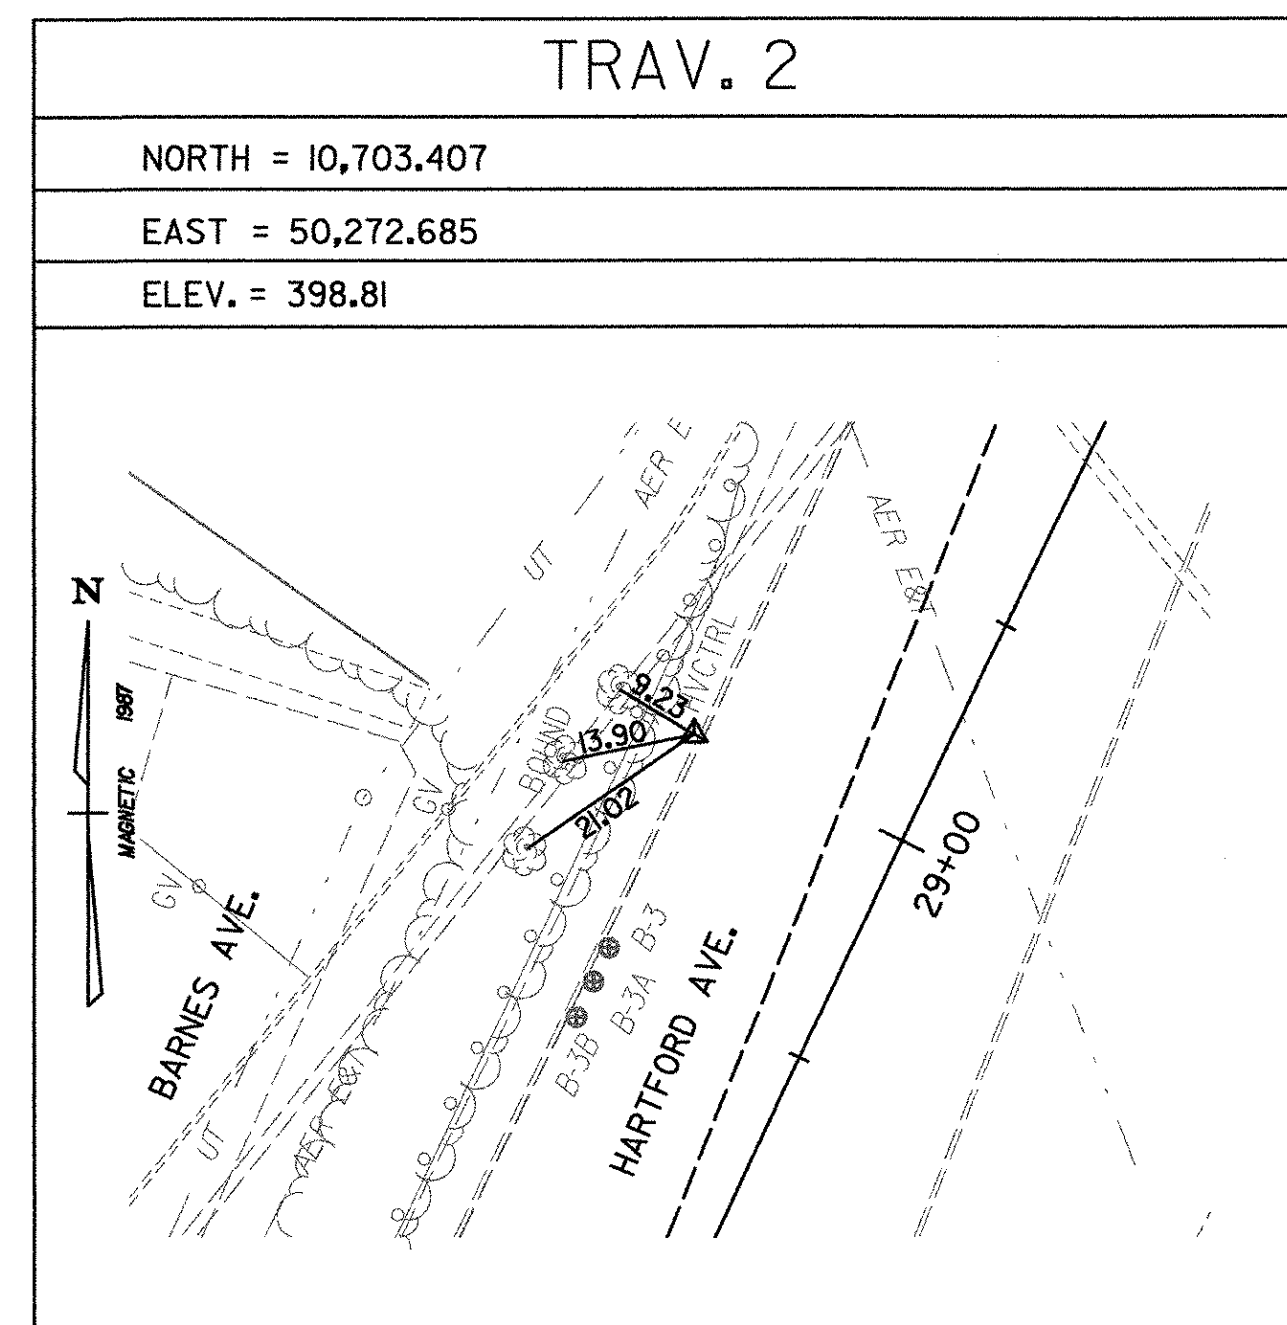


TRAVERSE TIES

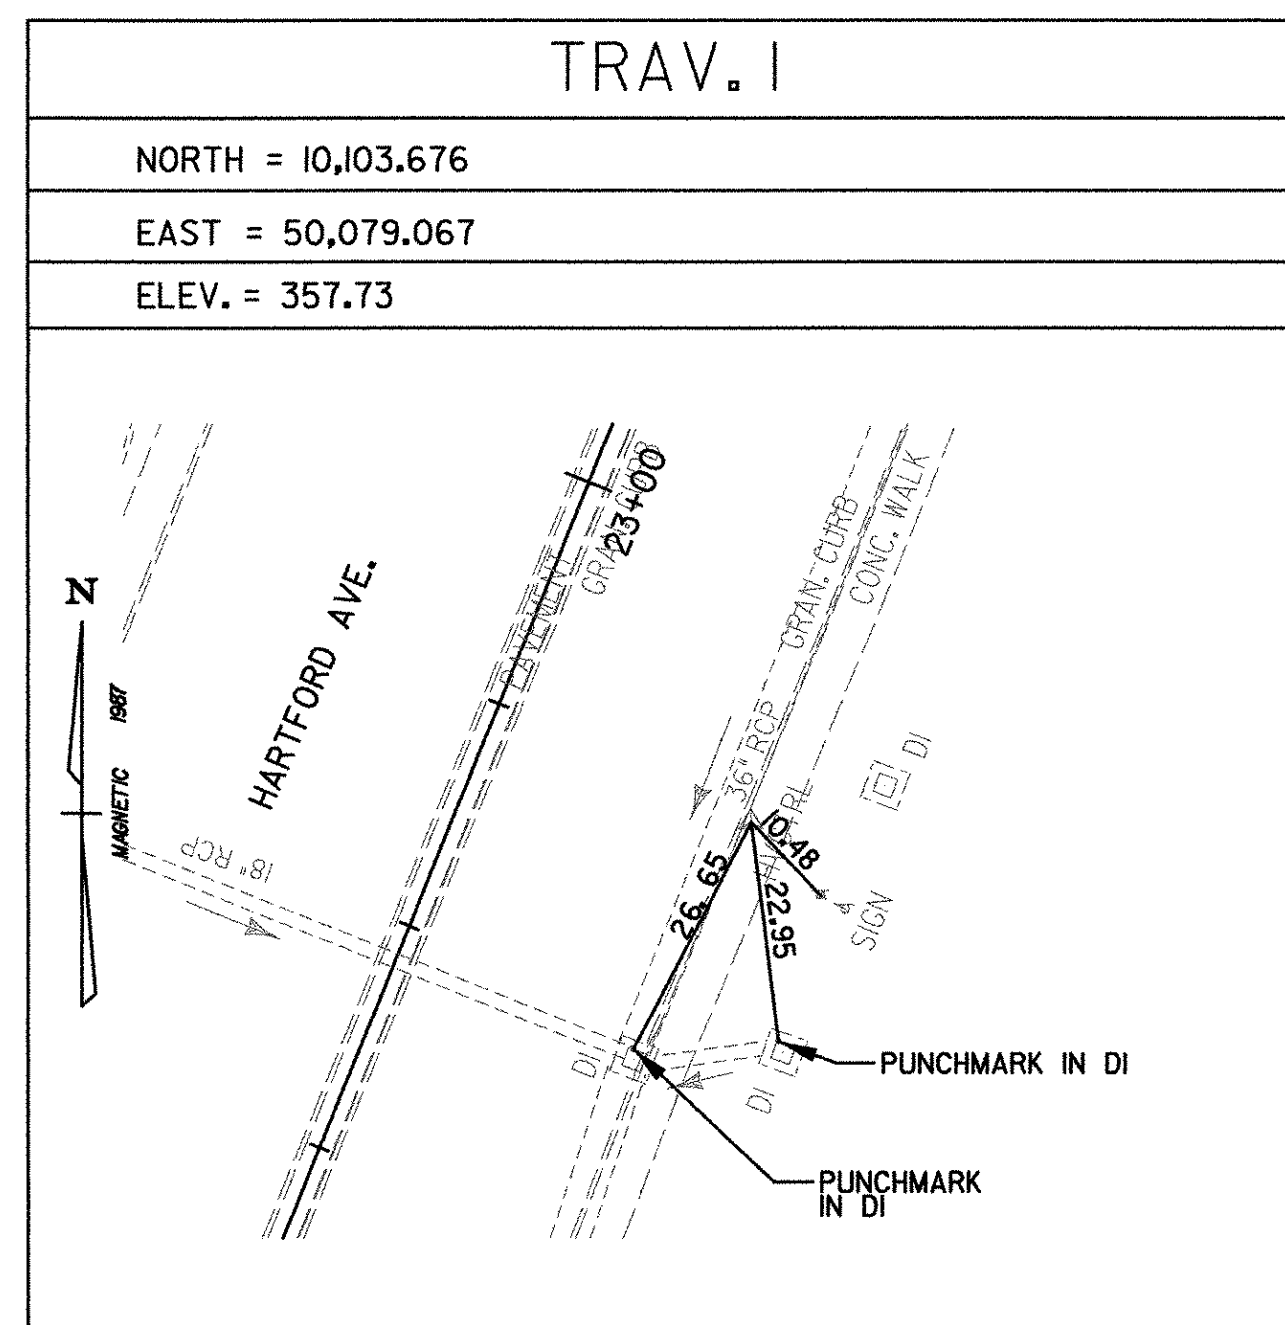

DATUM
VERTICAL <u>NGVD 1929</u>
HORIZONTAL <u>N/A</u>

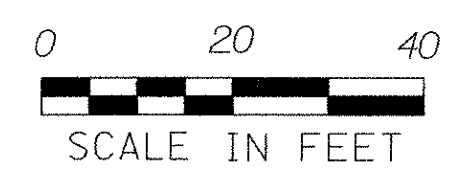

PROJECT: HARTFORD	PROJECT NO. : RS 0113(40)
DESIGN FILE NAME: z86c027+1es.DGN	PLOT DATE: 1/5/2007
IPARM FILE NAME:	SURVEY DATE: 1/87
SURVEYED BY: FANTONI	DRAWN BY: E. ATKINS
SQUAD LEADER: KEN UPMAL	SHEET: 18 OF 239