

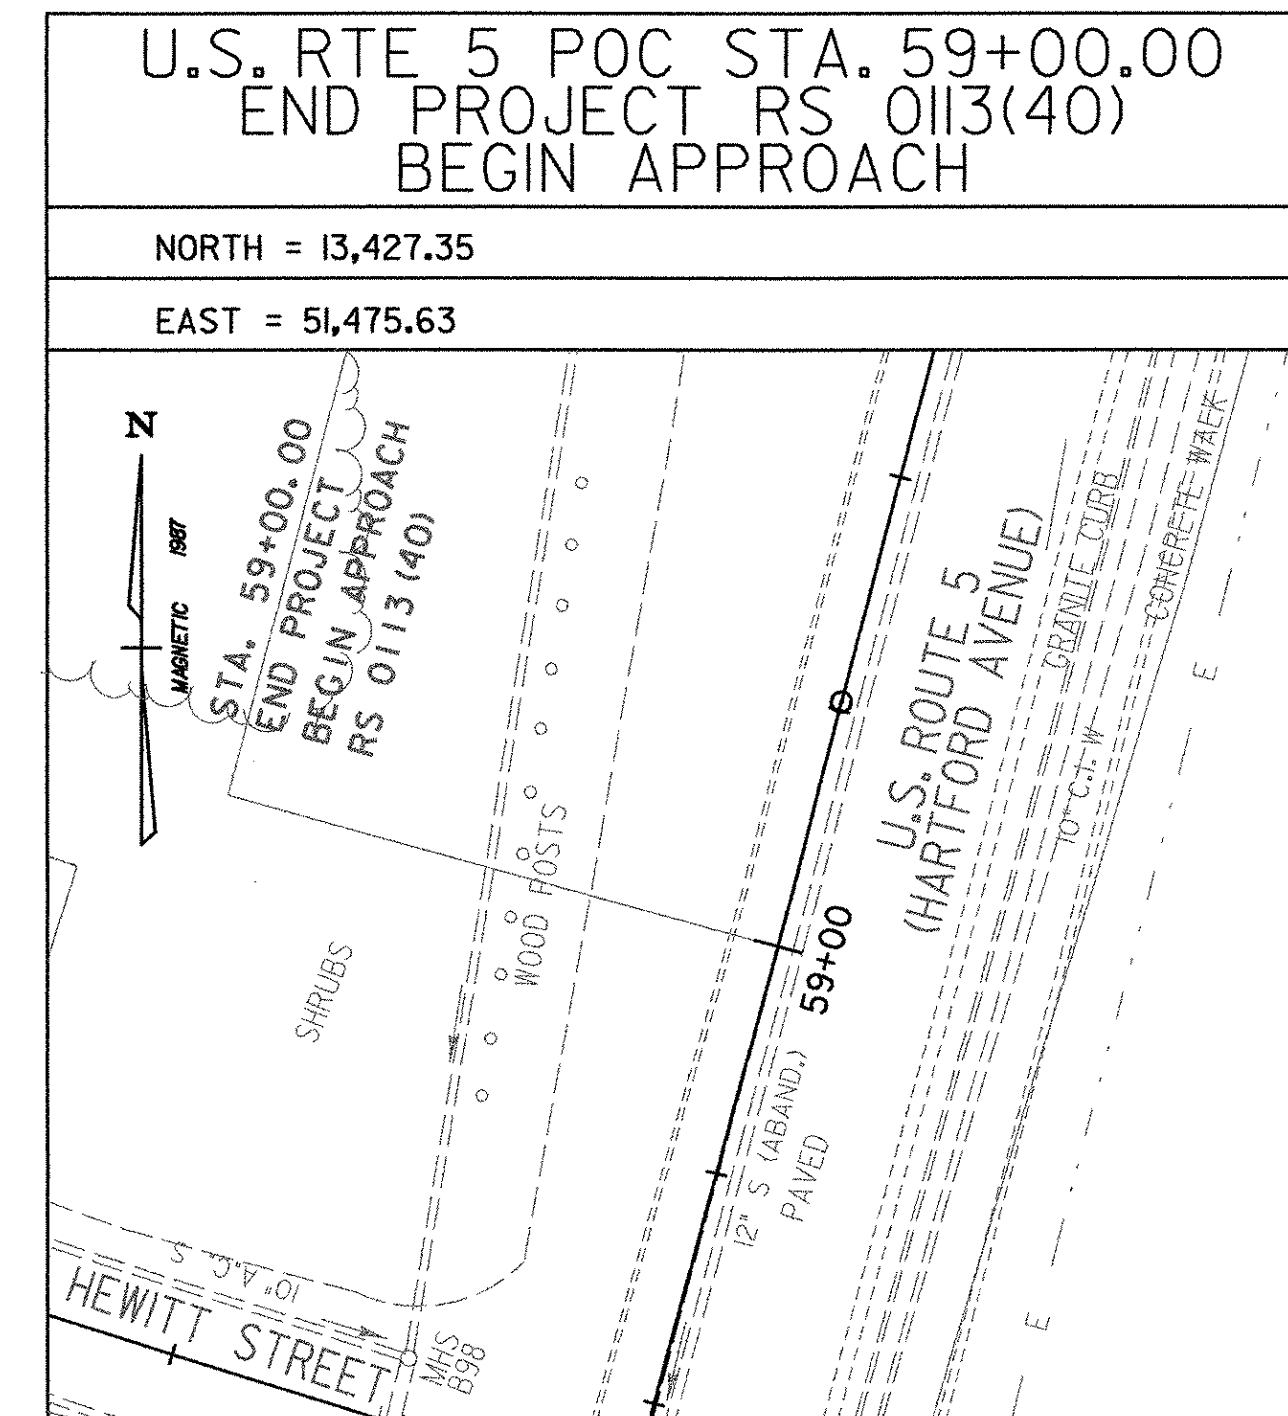
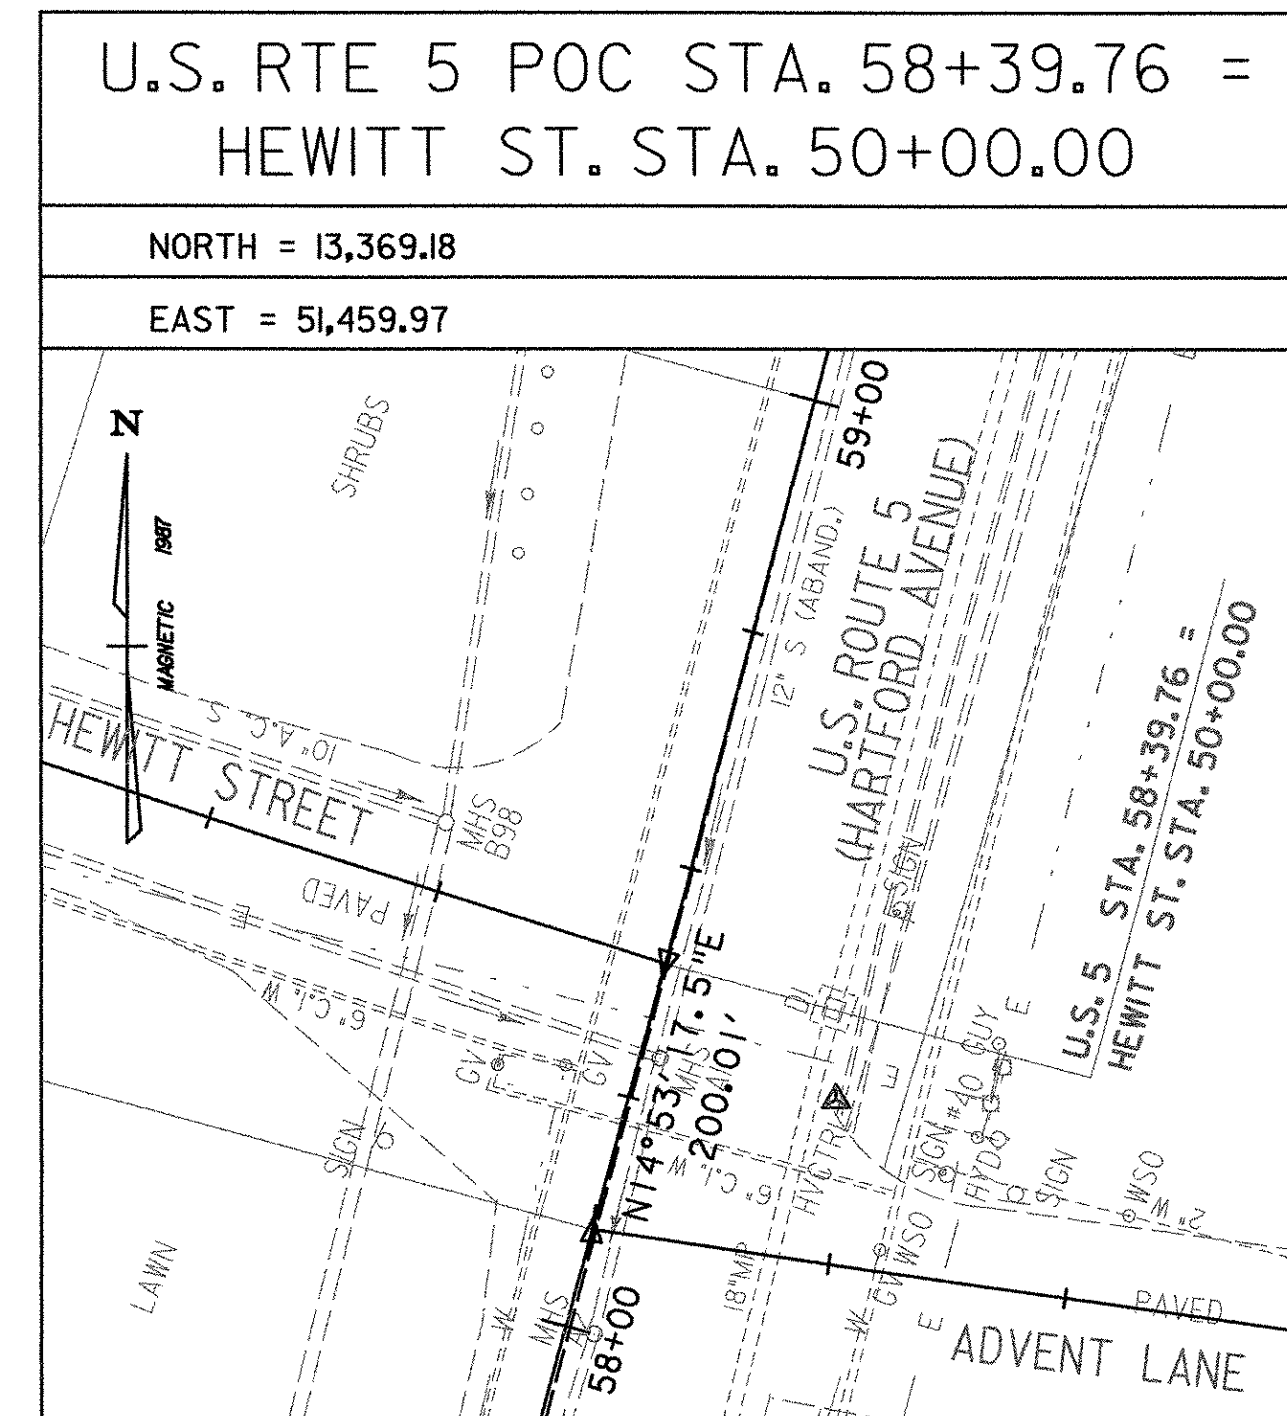
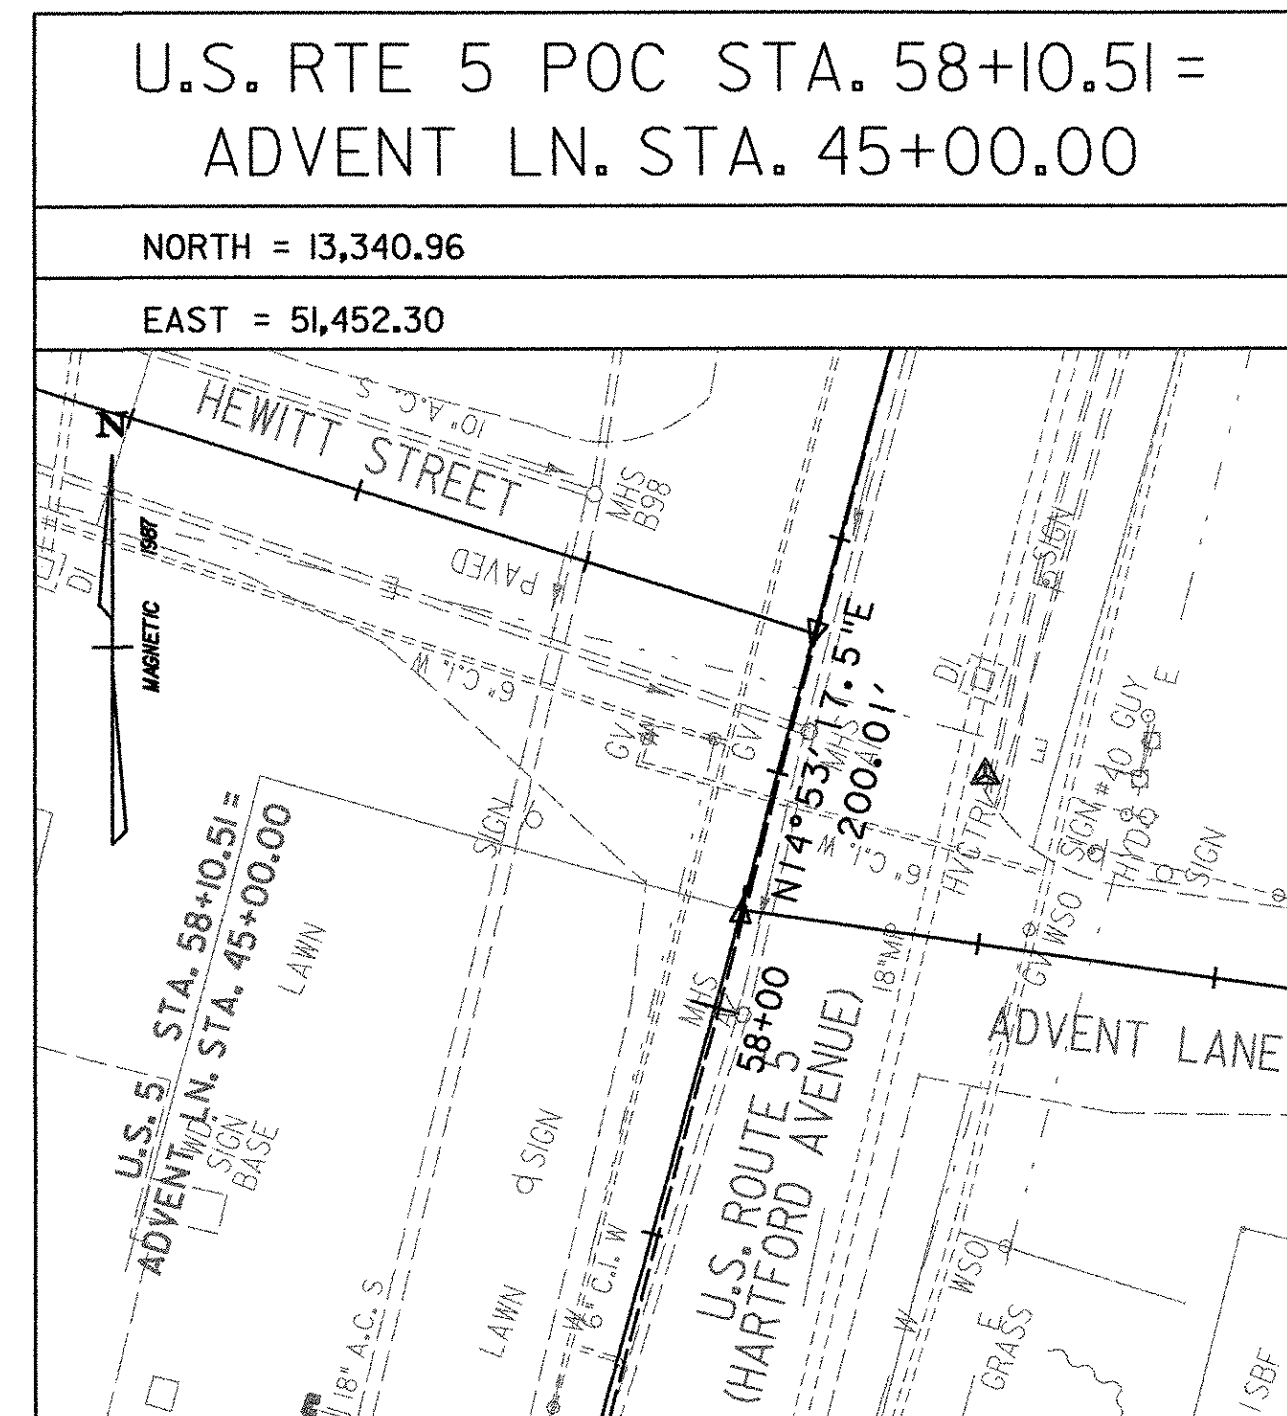
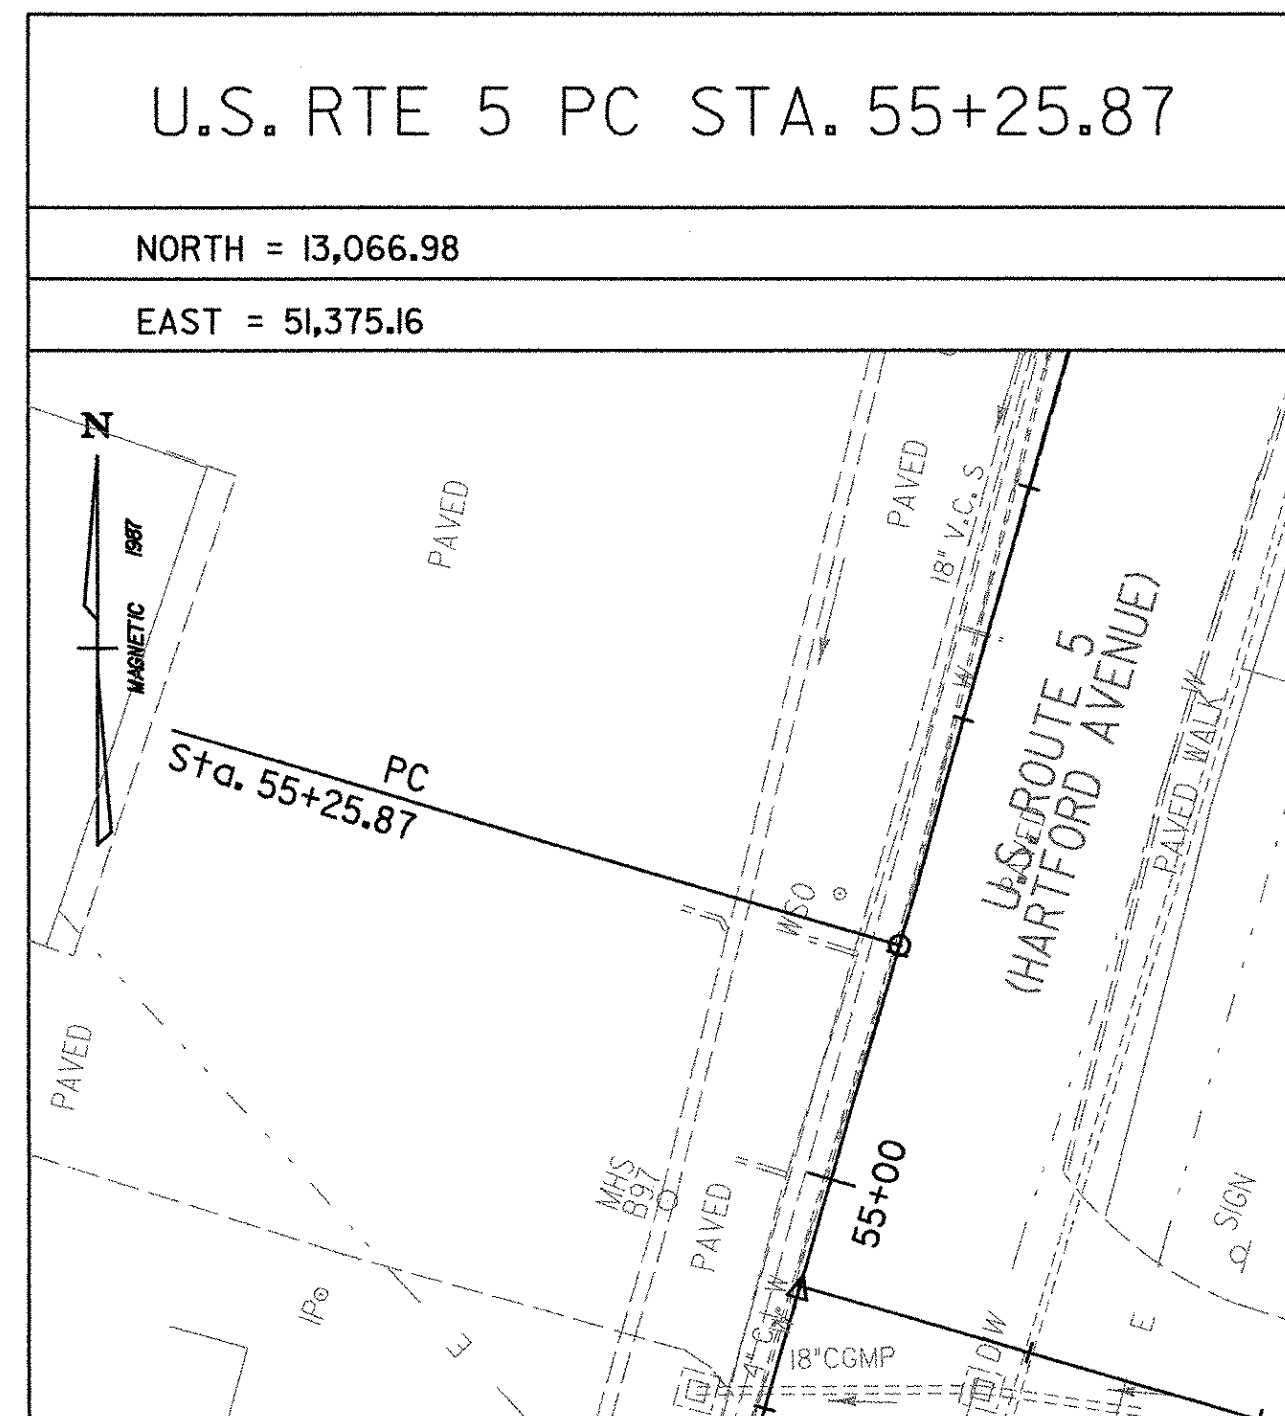
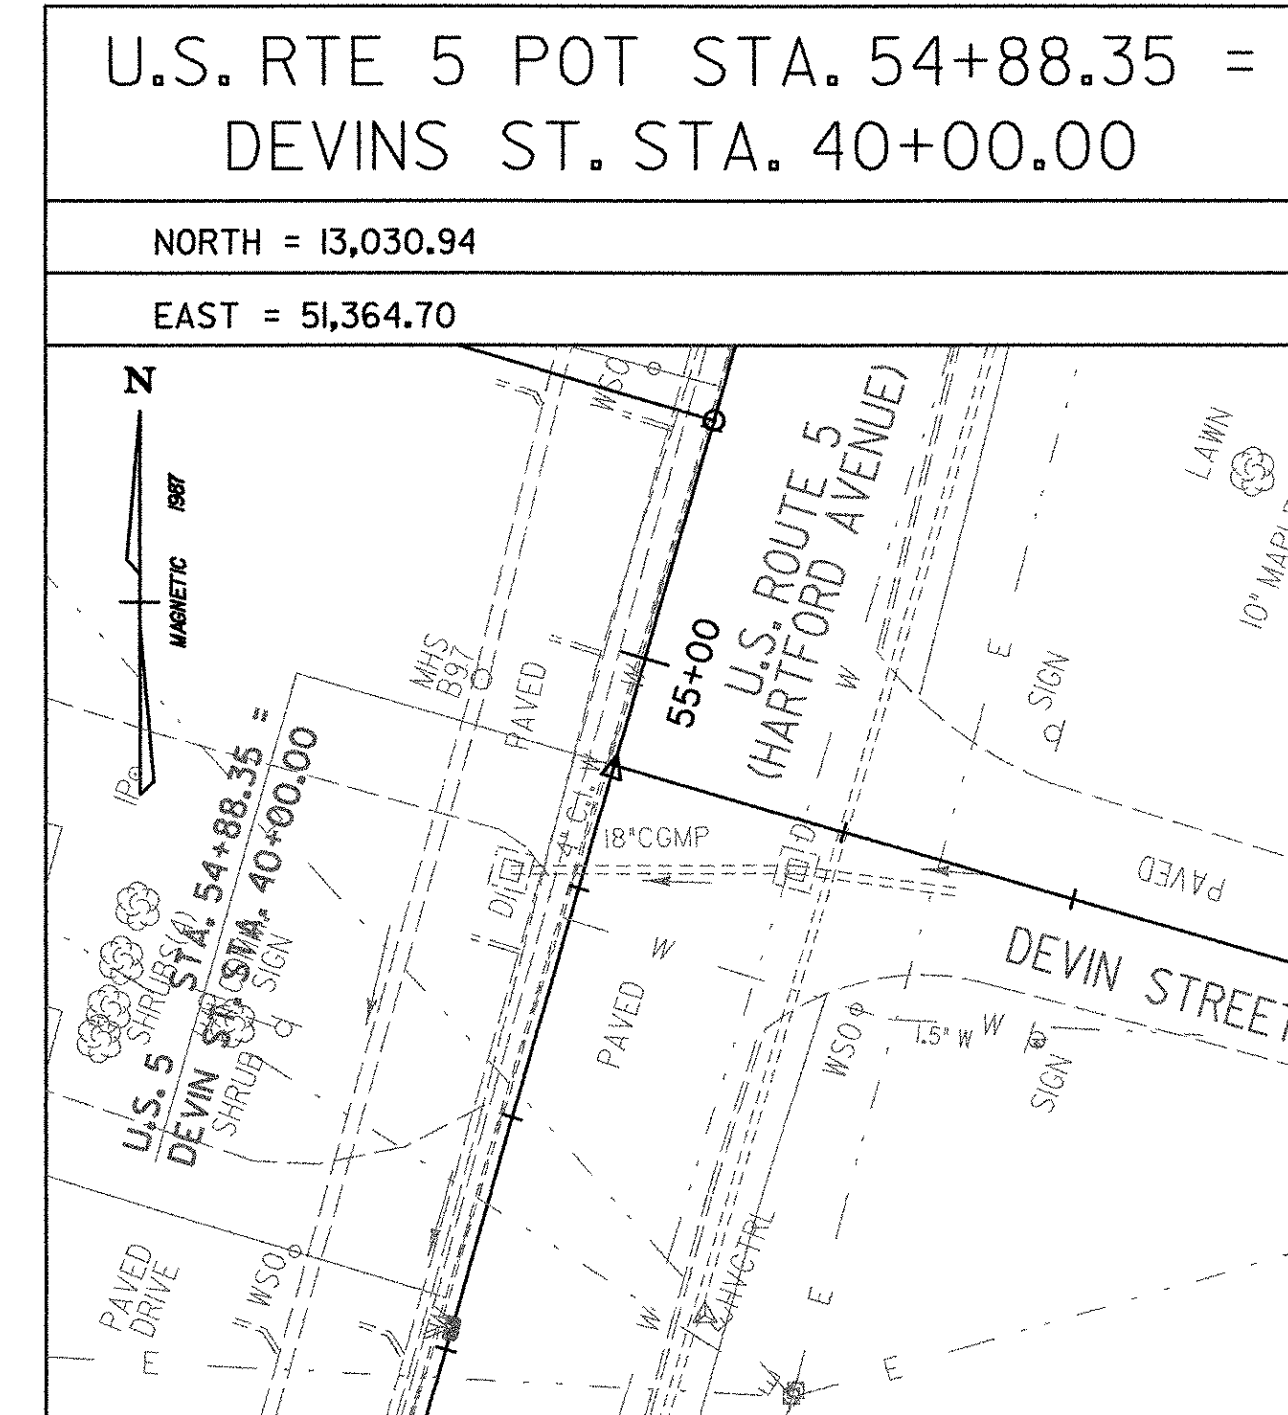
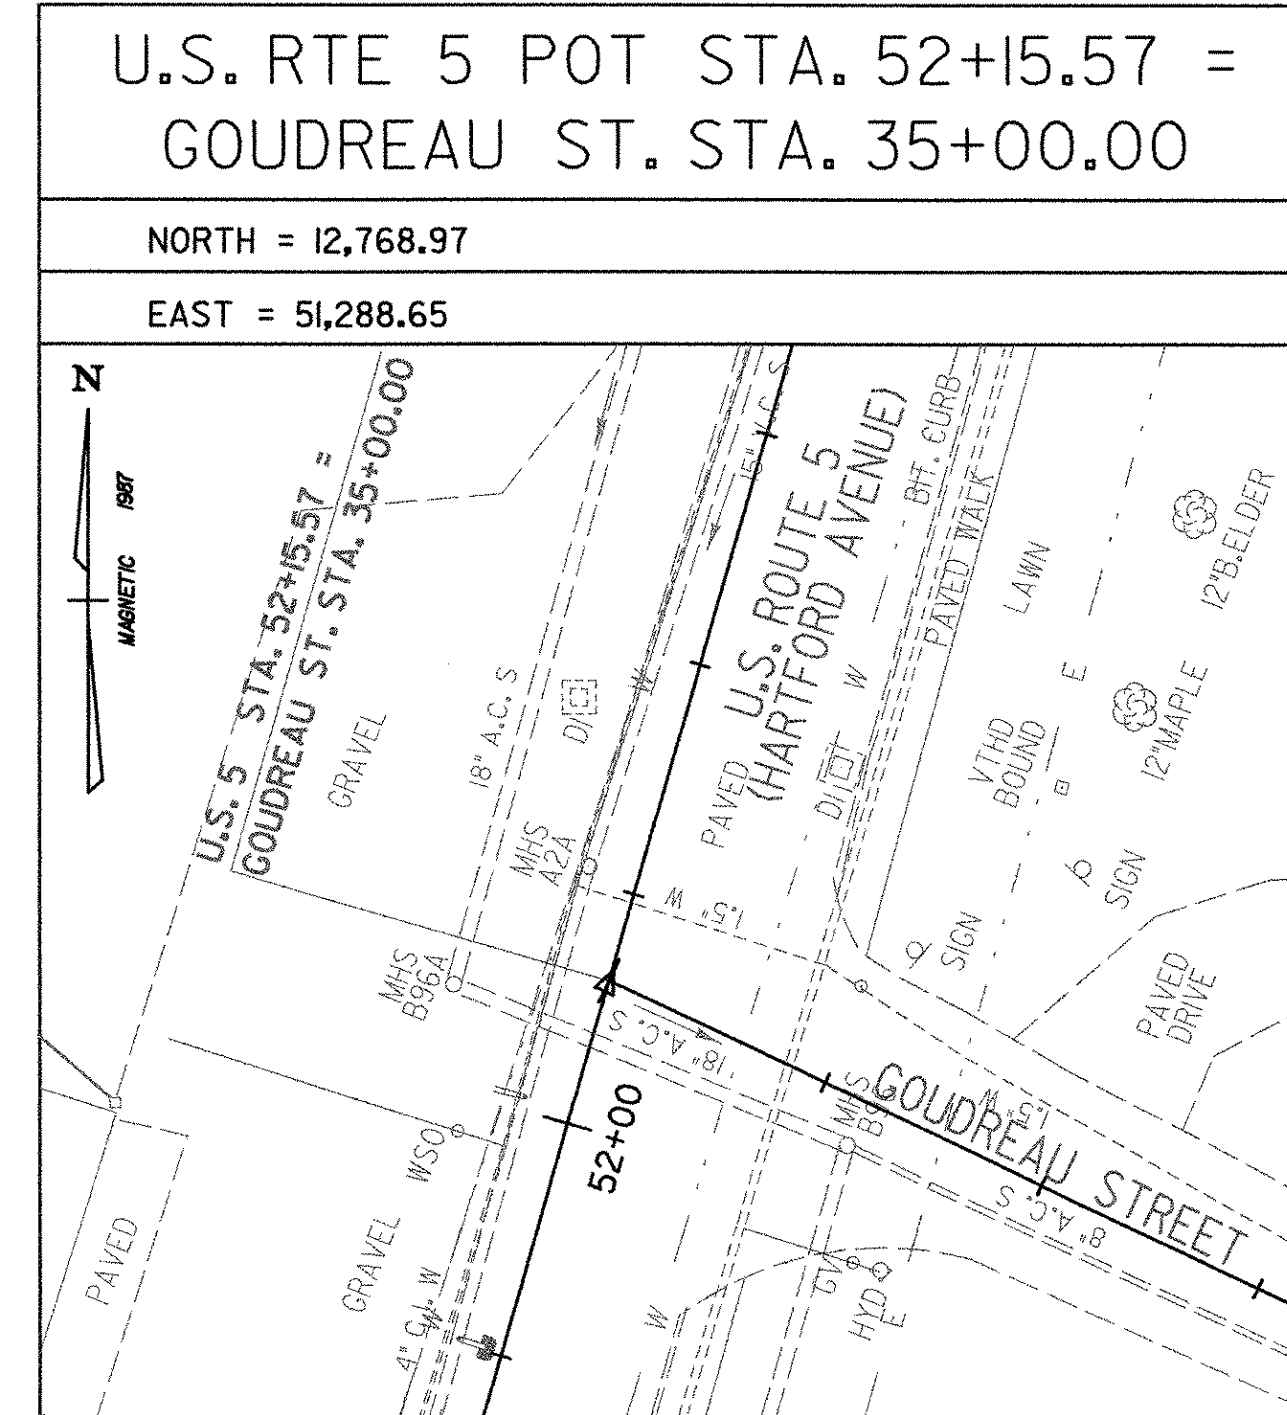
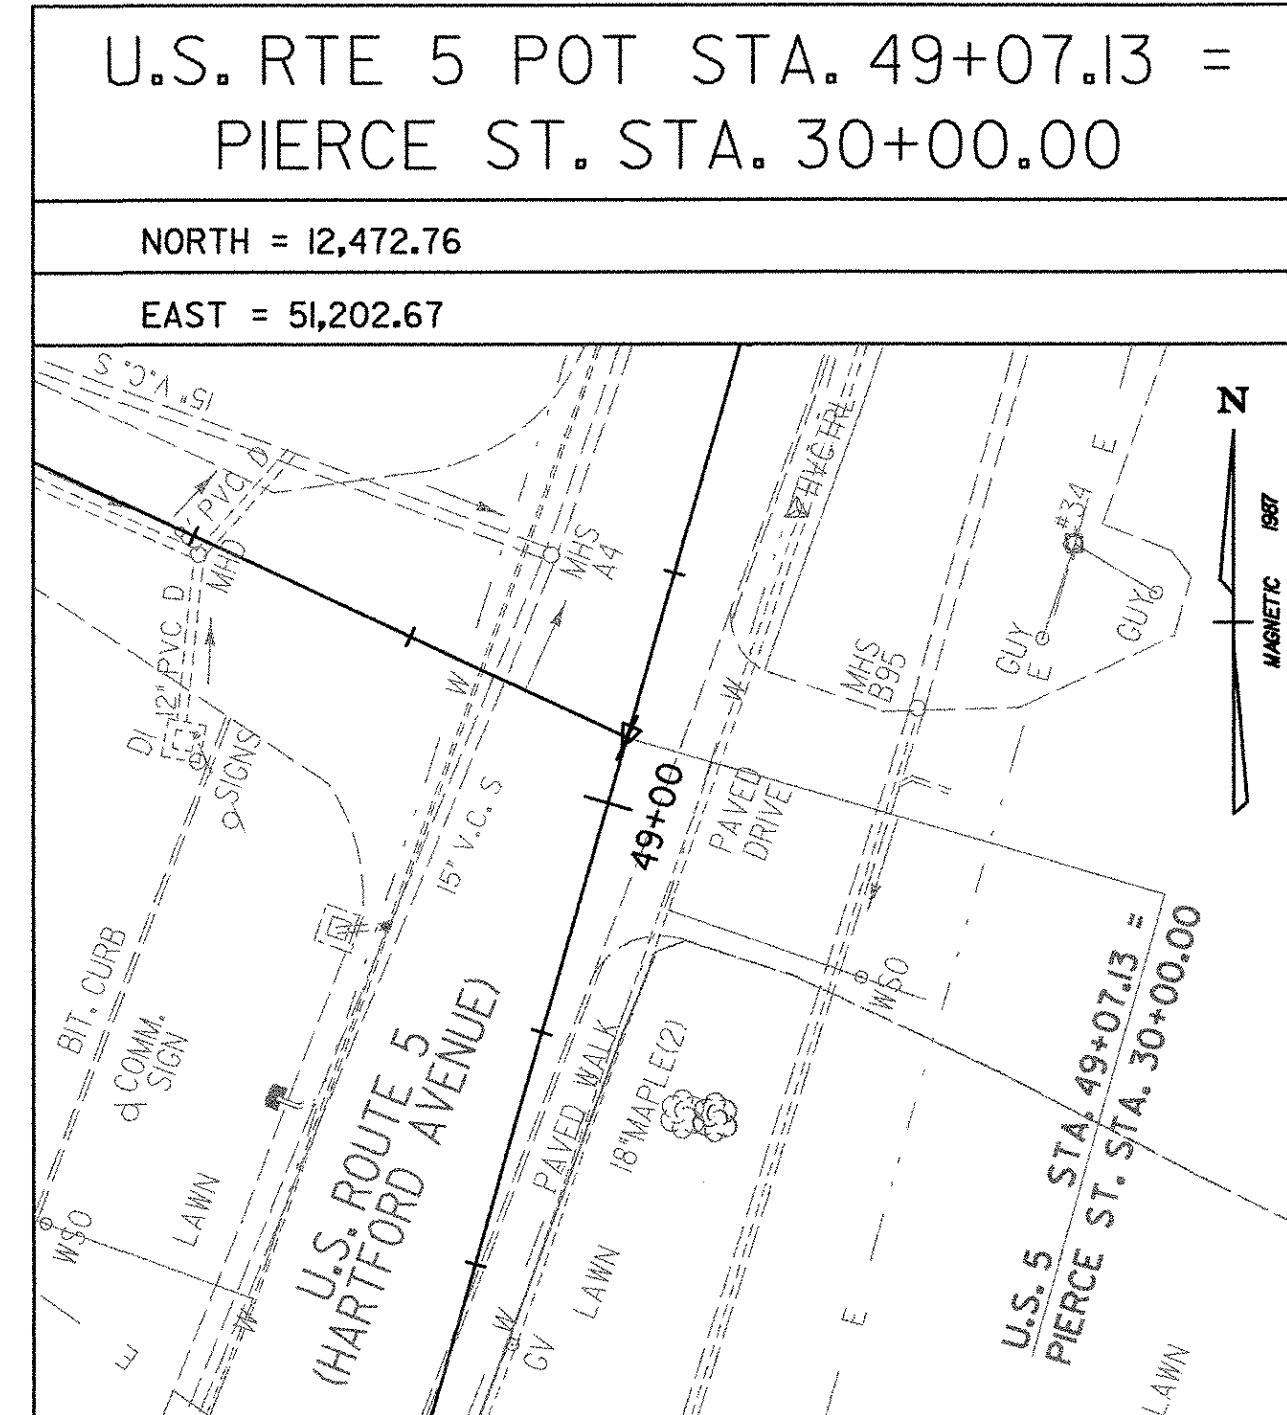


ALIGNMENT TIES

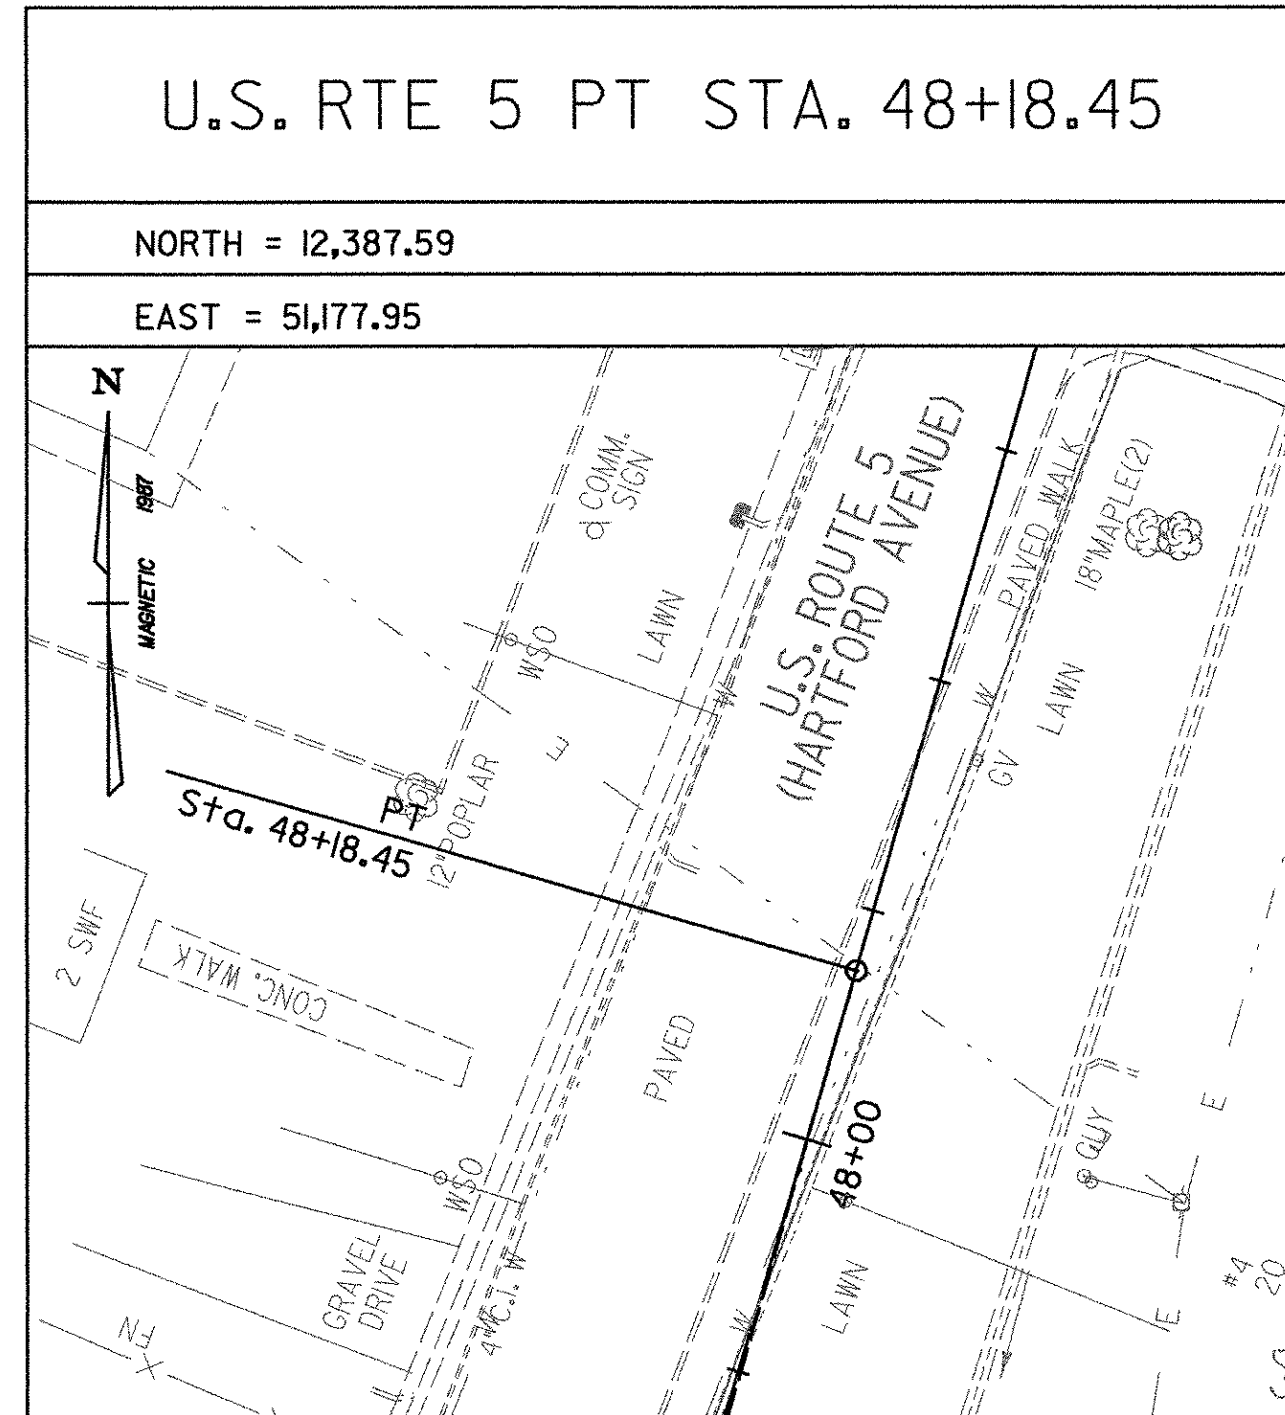

DATUM	
VERTICAL	NGVD 1929
HORIZONTAL	N/A

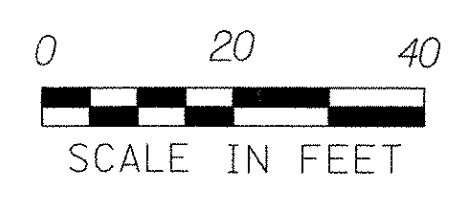

PROJECT: HARTFORD	PROJECT NO. : RS 0113(40)
DESIGN FILE NAME: z86c0271tes.DGN	PLOT DATE: 1/5/2007
IPARM FILE NAME:	SURVEY DATE: 1/87
SURVEYED BY: FANTONI	DRAWN BY: E. ATKINS
SQUAD LEADER: KEN UPMAL	SHEET: 21 OF 239