
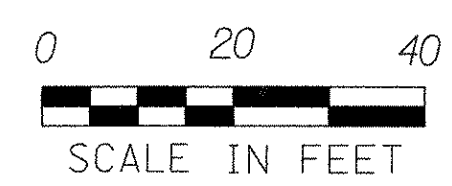
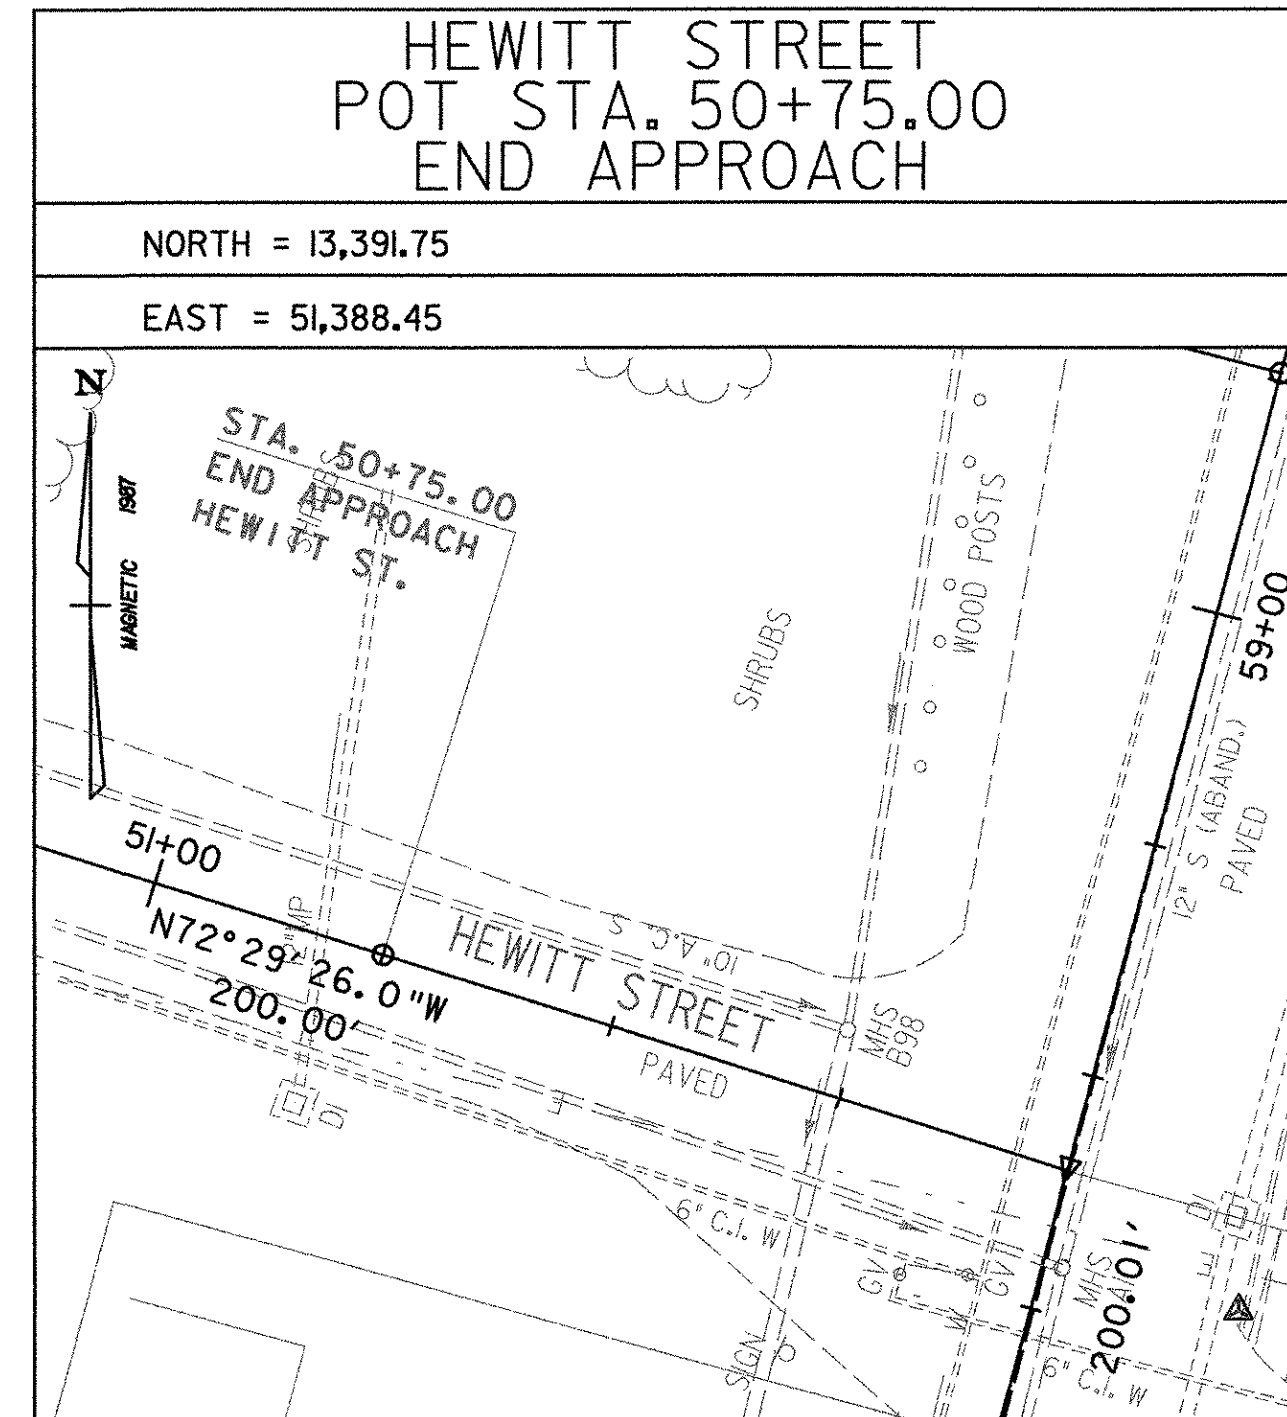


ALIGNMENT TIES

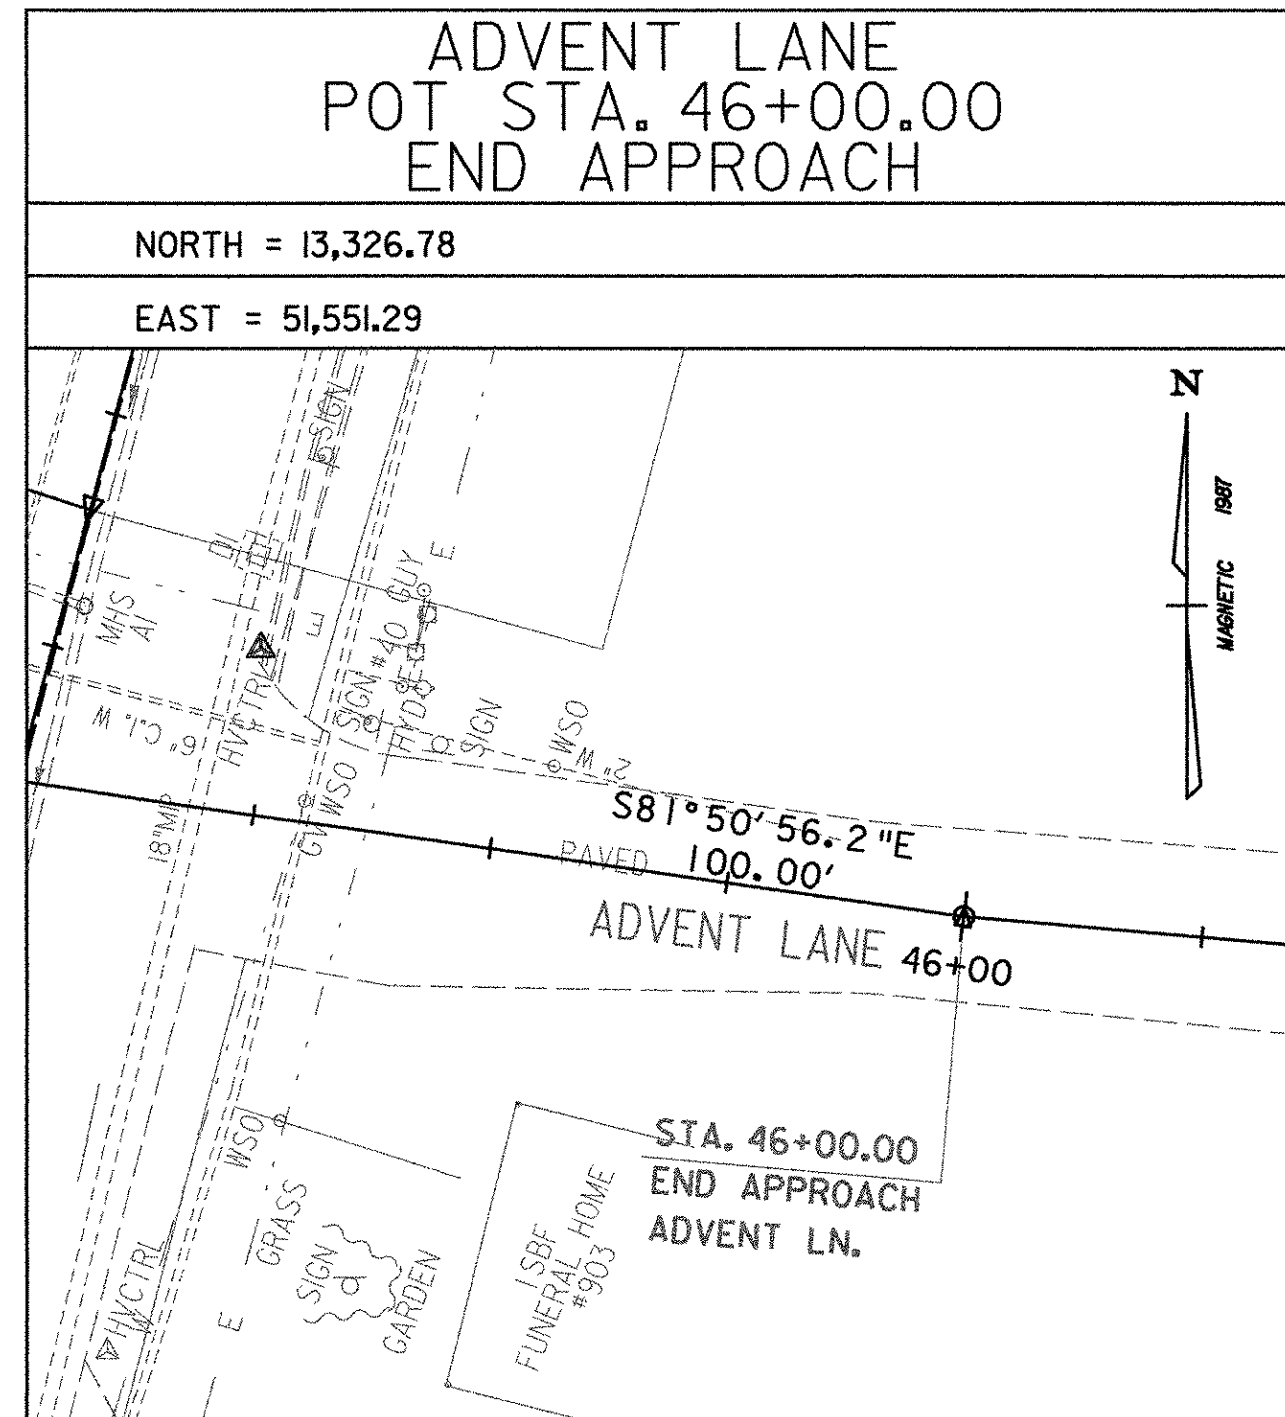

| | |
|--------------|-----------|
| DATUM | |
| VERTICAL | NGVD 1929 |
| HORIZONTAL | N/A |

| | |
|----------------------------------|------------------------------|
| PROJECT: HARTFORD | PROJECT NO. : RS 0113(40) |
| DESIGN FILE NAME: z86c0271es.DGN | PLOT DATE: 1/5/2007 |
| IPARM FILE NAME: | SURVEY DATE: 1/87 |
| SURVEYED BY: FANTONI | DRAWN BY: E. ATKINS |
| SQUAD LEADER: KEN UPMAL | SHEET: 25 OF 239 |

TIE SHEET 8