

RIGHT - OF - WAY DETAIL SHEET


TABLE OF PROPERTY ACQUISITION

PARCEL NO.	PROPERTY OWNER	SHEET NO.	BEGINNING STATION	ENDING STATION	TAKE	REMAINDER	RIGHT			RECORDING DATA				REMARKS	
							AREA±	AREA±	TYPE	(T)(P)	AREA ±	TITLE	DATE		TOWN / CITY
1	MASCOMA SAVINGS BANK,FSB	53	22+30.86 LT. 22+46.87 LT. 22+41.99 LT.	20+68.30 LT. 22+51.20 LT.			SLOPE CULVERT INSTALL	(T) (P) (T)	13.1 SF						INCLUDES DROP INLET EROSION CONTROL
2	HARTFORD LAND COMPANY	53	22+02.84 RT. 22+49.95 RT. 22+02.84 RT. 23+75.19 RT.	23+82.18 RT. 23+75.21 RT. 24+47.88 RT.			SLOPE INSTALL & MAINT. INSTALL INSTALL	(T) (P) (T) (T)	302.5 SF						INCLUDES PDF DROP INLET CURB EROSION CONTROL & PDF
3	SMITH, BJORN E.	54	27+01.13 LT.	27+10.44 LT.			INSTALL	(T)							EROSION CONTROL
4	SMITH, EVERETT J. & SANDRA F.	54,55	28+91.16 LT. 28+91.22 LT. 28+91.24 LT. 28+91.24 LT.	33+05.42 LT. 29+13.64 LT. 29+13.64 LT. 29+13.64 LT.	0.24A		SLOPE INSTALL LANDSCAPE	(T) (T) (T)	213.1 SF 163.1 SF						EROSION CONTROL & PDF TREES/SHRUBS
5	BLAKE, CAROLE I.	54,55	30+26.00 RT. 30+04.90 RT. 30+13.58 RT. 30+13.75 RT.	30+67.81 RT. 30+71.94 RT. 30+70.74 RT. 30+70.94 RT.			INSTALL & MAINTAIN INSTALL LANDSCAPE SLOPE	(P) (T) (T) (P)	353.3 SF 884.2 SF	WD	06/19/06	HARTFORD	404	650- 651	SOIL ANCHORS MODIFIED PDF FENCE TREES/SHRUBS
6	CARTER, DERROL N. & THERESA A.	55	30+65.68 RT. 30+71.94 RT. 30+65.76 RT. 30+65.68 RT.	31+75.07 RT. 31+73.17 RT. 31+72.25 RT. 31+71.49 RT.			INSTALL & MAINTAIN INSTALL LANDSCAPE SLOPE	(P) (T) (T) (P)	0.07 A 1501.1 SF						SOIL ANCHORS MODIFIED PDF FENCE TREES/SHRUBS
7	GILBERT, KENDALL S. & LINDA R.	55	31+65.58 RT. 31+73.07 RT. 31+65.68 RT. 32+36.23 RT. 31+65.58 RT.	32+80.88 RT. 32+70.92 RT. 32+70.52 RT. 32+66.16 RT. 32+70.37 RT.			INSTALL & MAINTAIN INSTALL LANDSCAPE DIT. & DR. SLOPE	(P) (T) (T) (P) (P)	0.24 A 5.3 SF 2279.3 SF						SOIL ANCHORS MODIFIED PDF FENCE TREES/SHRUBS

TABLE OF REVISIONS

REVISION NO.	SHEET NO.	DESCRIPTION	DATE
1	46,55	PARCEL NO. 5 BLAKE. ADD SLOPE (P) AT STA. 30+13.75 RT. ~ 30+70.94 RT.; 884.2 SF± REMOVE 1967 SLOPE LIMITS THAT ARE ON THE LAYOUTS. PER C.O. 9457. MADE BY: JAB APPROVED BY: RPD	06/23/06
2	46,55	PARCEL NO. 6 CARTER. ADD SLOPE (P) AT STA. 30+65.68 RT. ~ 31+74.49 RT.; 1501.1 SF± REMOVE 1967 SLOPE LIMITS THAT ARE ON THE LAYOUTS. PER C.O. 9458. MADE BY: JAB APPROVED BY: RPD	06/23/06
3	46,55	PARCEL NO. 7 GILBERT. ADD SLOPE (P) AT STA. 31+65.58 RT. ~ 32+70.37 RT.; 2279.3 SF± REMOVE 1967 SLOPE LIMITS THAT ARE ON THE LAYOUTS. PER C.O. 9459. MADE BY: JAB APPROVED BY: RPD	06/23/06
4	47,55	PARCEL NO. 8 HODGDON. ADD SLOPE (P) AT STA. 32+66.25 RT. ~ 33+65.97 RT.; 1359.8 SF± REMOVE 1967 SLOPE LIMITS THAT ARE ON THE LAYOUTS. PER C.O. 9460. MADE BY: JAB APPROVED BY: RPD	06/23/06
5	47,55	PARCEL NO. 9 LERNER. ADD SLOPE (P) AT STA. 33+63.43 RT. ~ 34+58.58 RT.; 690.4 SF± REMOVE 1967 SLOPE LIMITS THAT ARE ON THE LAYOUTS. PER C.O. 9461. MADE BY: JAB APPROVED BY: RPD	06/23/06
6	47, 55, 56	PARCEL NO. 10 DALPHINAIS. ADD SLOPE (P) AT STA. 34+52.59 35+50.75 RT.; 660.3 SF± REMOVE 1967 SLOPE LIMITS THAT ARE ON THE LAYOUTS. PER C.O. 9462. MADE BY: JAB APPROVED BY: RPD	06/23/06
7	47,58	PARCEL NO. 13 ALVIN. REMOVE WALK (T) FROM LAYOUT AND DETAIL SHEET. CHANGE DRIVE STATION FROM 41+17 TO 41+14.50 PER C.O. 9465. MADE BY: JAB APPROVED BY: RPD	06/14/06
8	48,58	PARCEL NO. 15 BLODGETT. CHANGE DRIVE STATION OF FROM 41+17.00 TO 41+14.50 LT. DELETE WALK (T). CHANGE THE STATIONS FOR TWO RIGHTS TO INSTALL CURB TO THE FOLLOWING: 41+40.65 LT. ~ 41+7760 LT. THE BEGINNING STA. 43+46.57 LT. TO 43+54.48 LT. PER C.O. 9466. MADE BY: JAB APPROVED BY: RPD	06/14/06
9	50,60	PARCEL NO. 26 VINCENT. CHANGE DRIVE STA. FROM 50+25.00 TO 50+37.00 PER C.O. 9467. MADE BY: JAB APPROVED BY: RPD	06/14/06
10	51,61	PARCEL NO. 36 M.T. ASSOCIATION. CHANDE DRIVE STA. FROM 57+01 TO 57+03 LT.; 40' PER C.O. 9468. MADE BY: JAB APPROVED BY: RPD	06/14/06

PLAN LEGEND

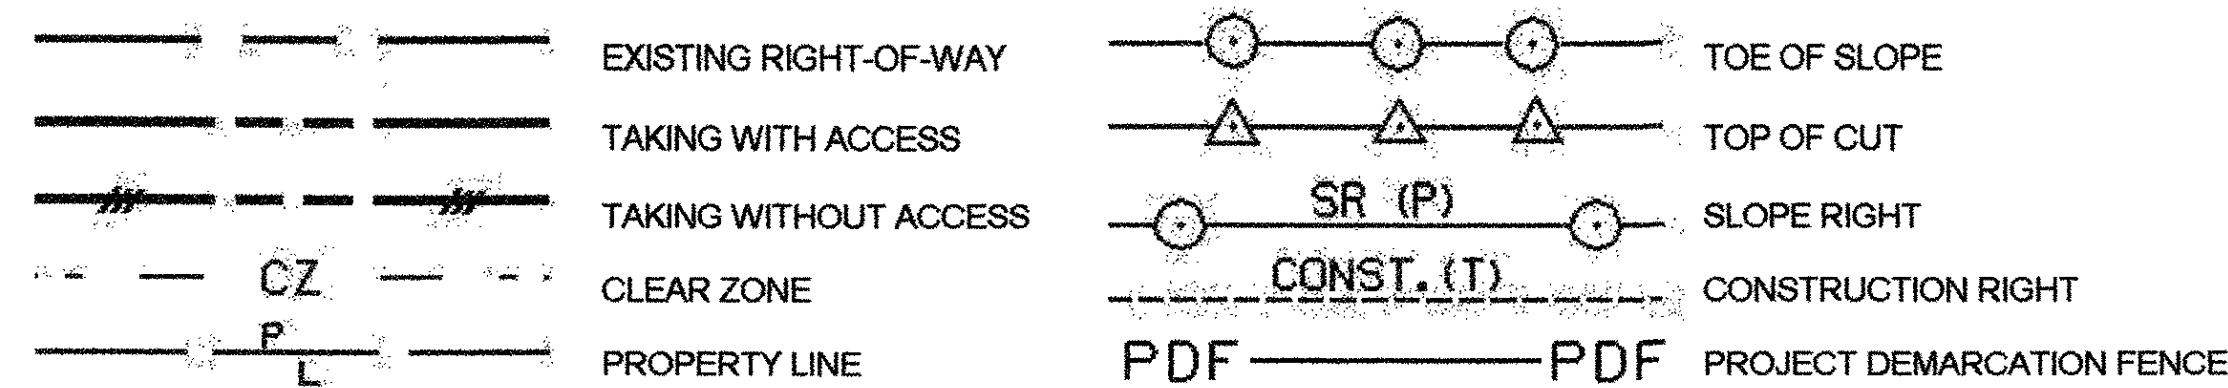

- EC - EROSION CONTROL
- (P) - PERMANENT
- (T) - TEMPORARY
- DR. - DRAINAGE RIGHT
- DIT. - DITCHING RIGHT
- CH. - CHANNEL RIGHT
- DRIVE - DRIVE RIGHT
- CUL. - CULVERT RIGHT
- C&T - CLEARING & TRIMMING RIGHT
- SR - SLOPE RIGHT
- UE - UTILITY EASEMENT

APPROVED: ROGER P. DUMAS DATE: 03-28-06
CHIEF, PLANS & TITLES

PLOT DATE 12/04/06

PROJECT NAME:	HARTFORD	PLOT DATE:	
PROJECT NUMBER:	RS 0113(40)	DRAWN BY:	MR
FILE NAME:	86C027.XLS	CHECKED BY:	FM
PROJECT LEADER:	0	SHEET	27 OF 239
DESIGNED BY:	0		
R.O.W. SHEET 46 OF 62			