





SANITARY SEWER SYSTEM

STRUCTURES

- CO9 STA. 500+00
NEW 6" ID PRECAST CLEANOUT
- CO10 STA. 503+20
NEW 6" ID PRECAST CLEANOUT
- AR3 STA. 506+50
NEW 6" ID PRECAST CLEANOUT W/ AIR RELEASE
- MH18 STA. 507+98 - STA. 600+00
NEW 4" ID PRECAST MANHOLE

PIPES

- FM19 STA. 500+00 - STA. 503+20
NEW 6" x 320' CL 52 D.I. SANITARY FORCE MAIN
- FM20 STA. 503+20 - STA. 506+50
NEW 6" x 330' CL 52 D.I. SANITARY FORCE MAIN
- FM21 STA. 506+50 - STA. 507+44
NEW 6" x 94' CL 52 D.I. SANITARY FORCE MAIN
- FM22 STA. 507+44 - STA. 507+98
NEW 6" x 54' PRE-INSULATED CL 52 D.I. SANITARY FORCE MAIN

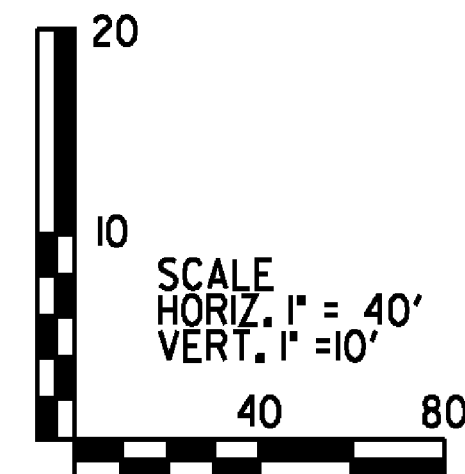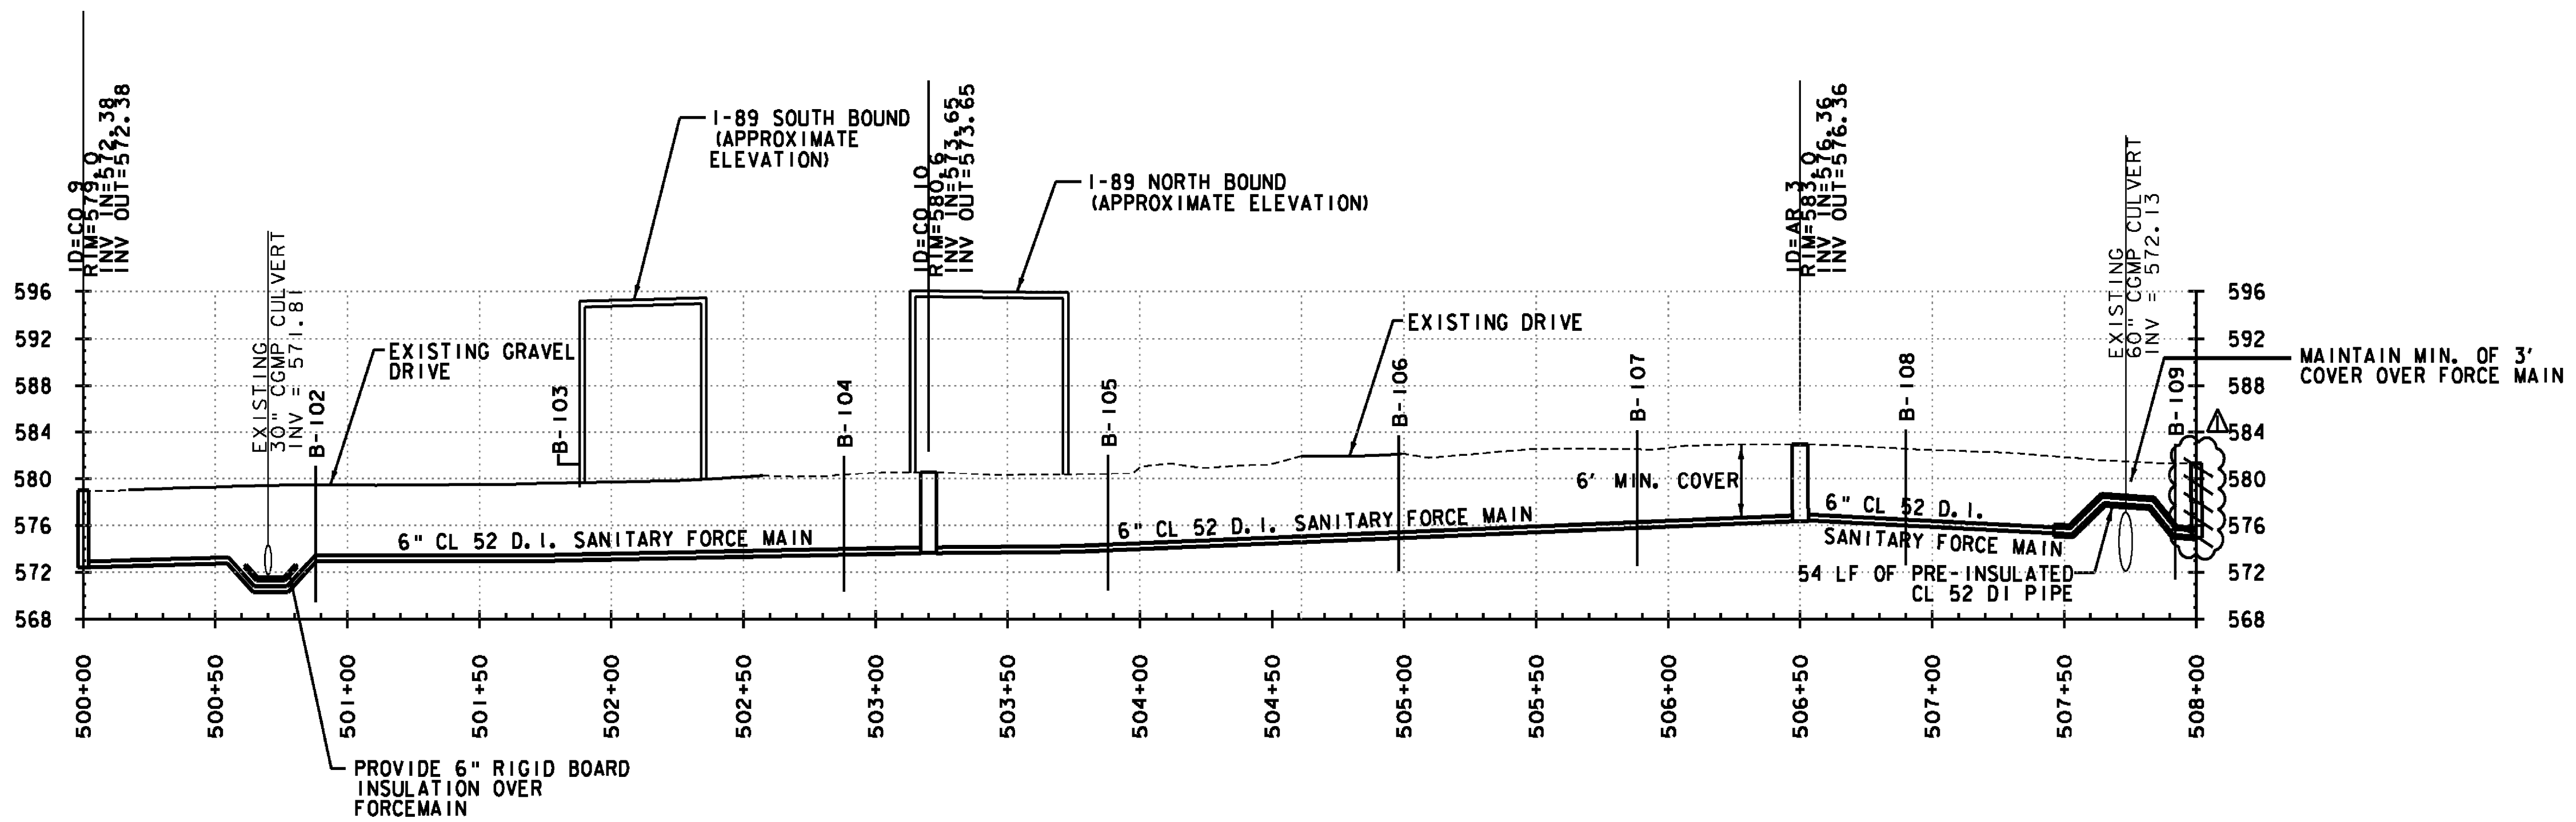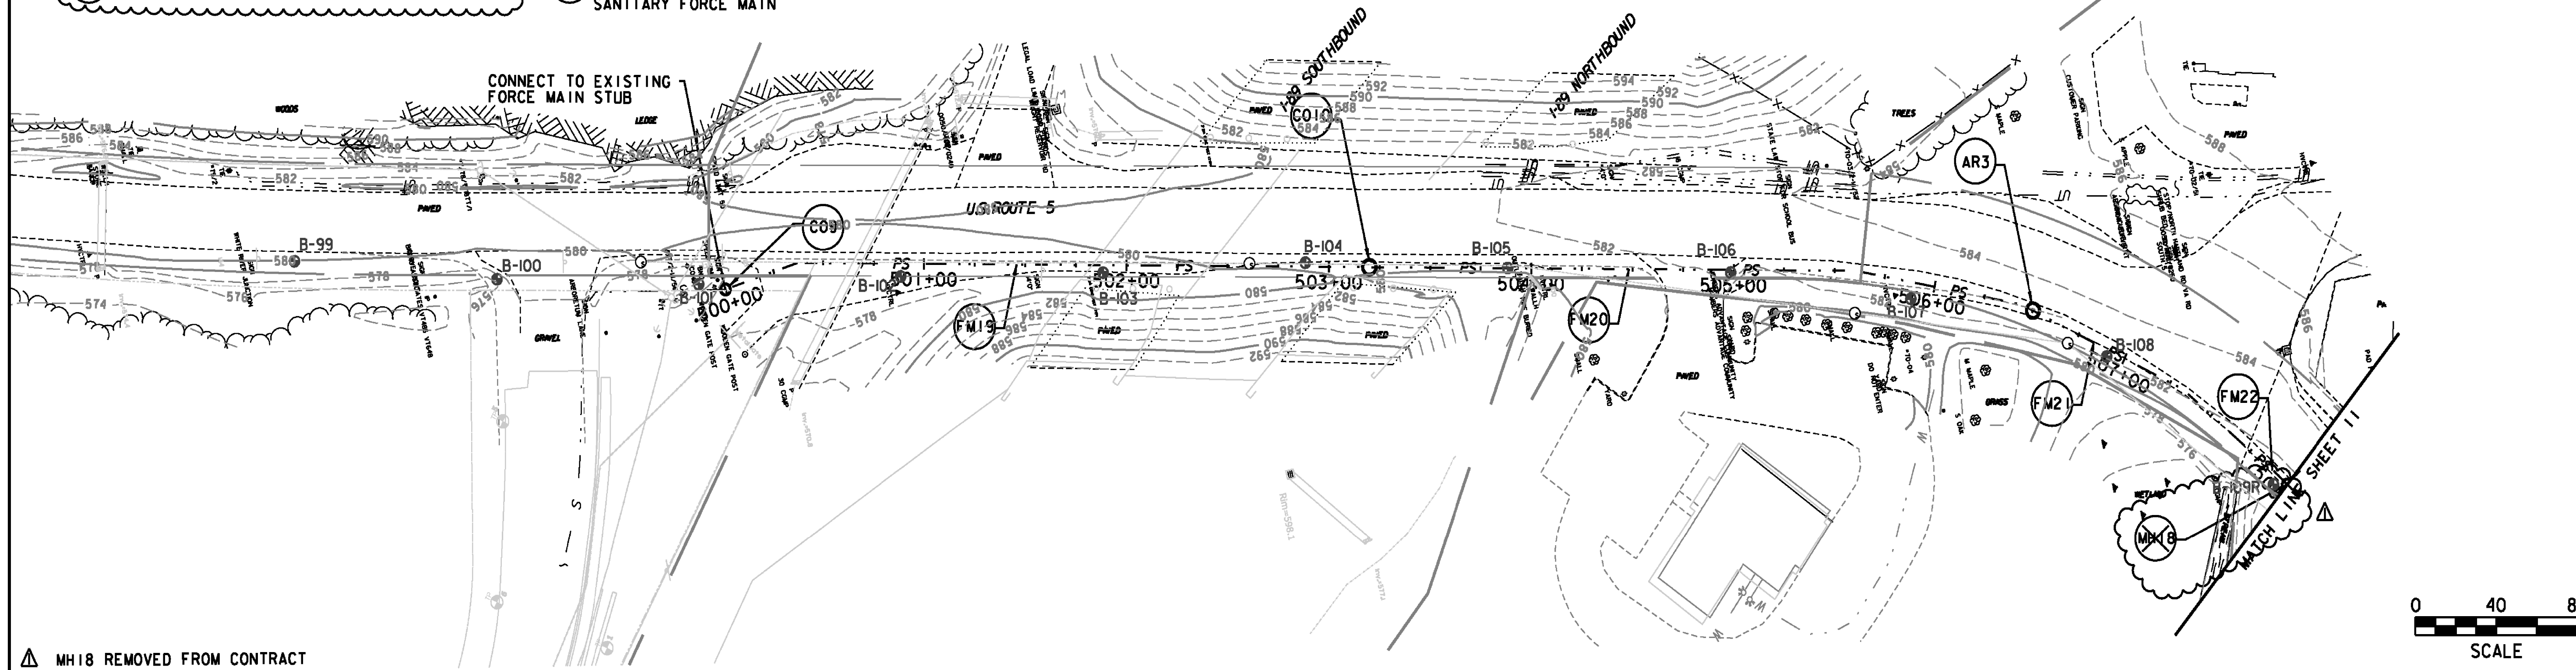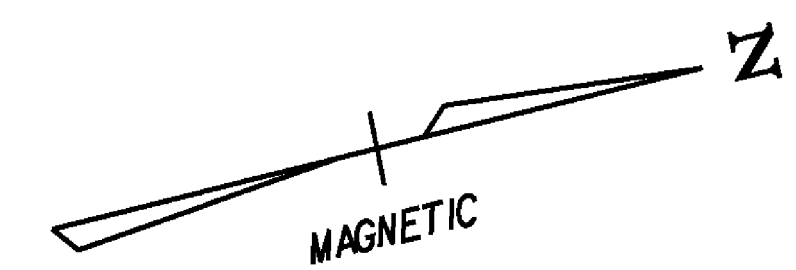

PROJECT NAME: HARTFORD REST AREAS
 PROJECT NUMBER: IM BLDG(10)
 FILE NAME: ...U04A026PLT-UTL(revised).dgn PLOT DATE: 9/16/2008
 PROJECT LEADER: JTM DRAWN BY: PZA
 DESIGNED BY: MEHP CHECKED BY: JTM
PLAN & PROFILE SHEET 10 SHEET 48R OF 70