
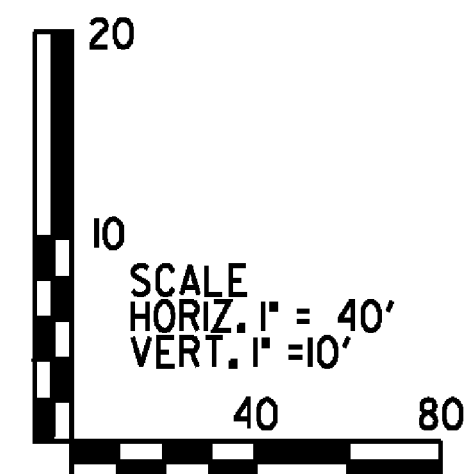
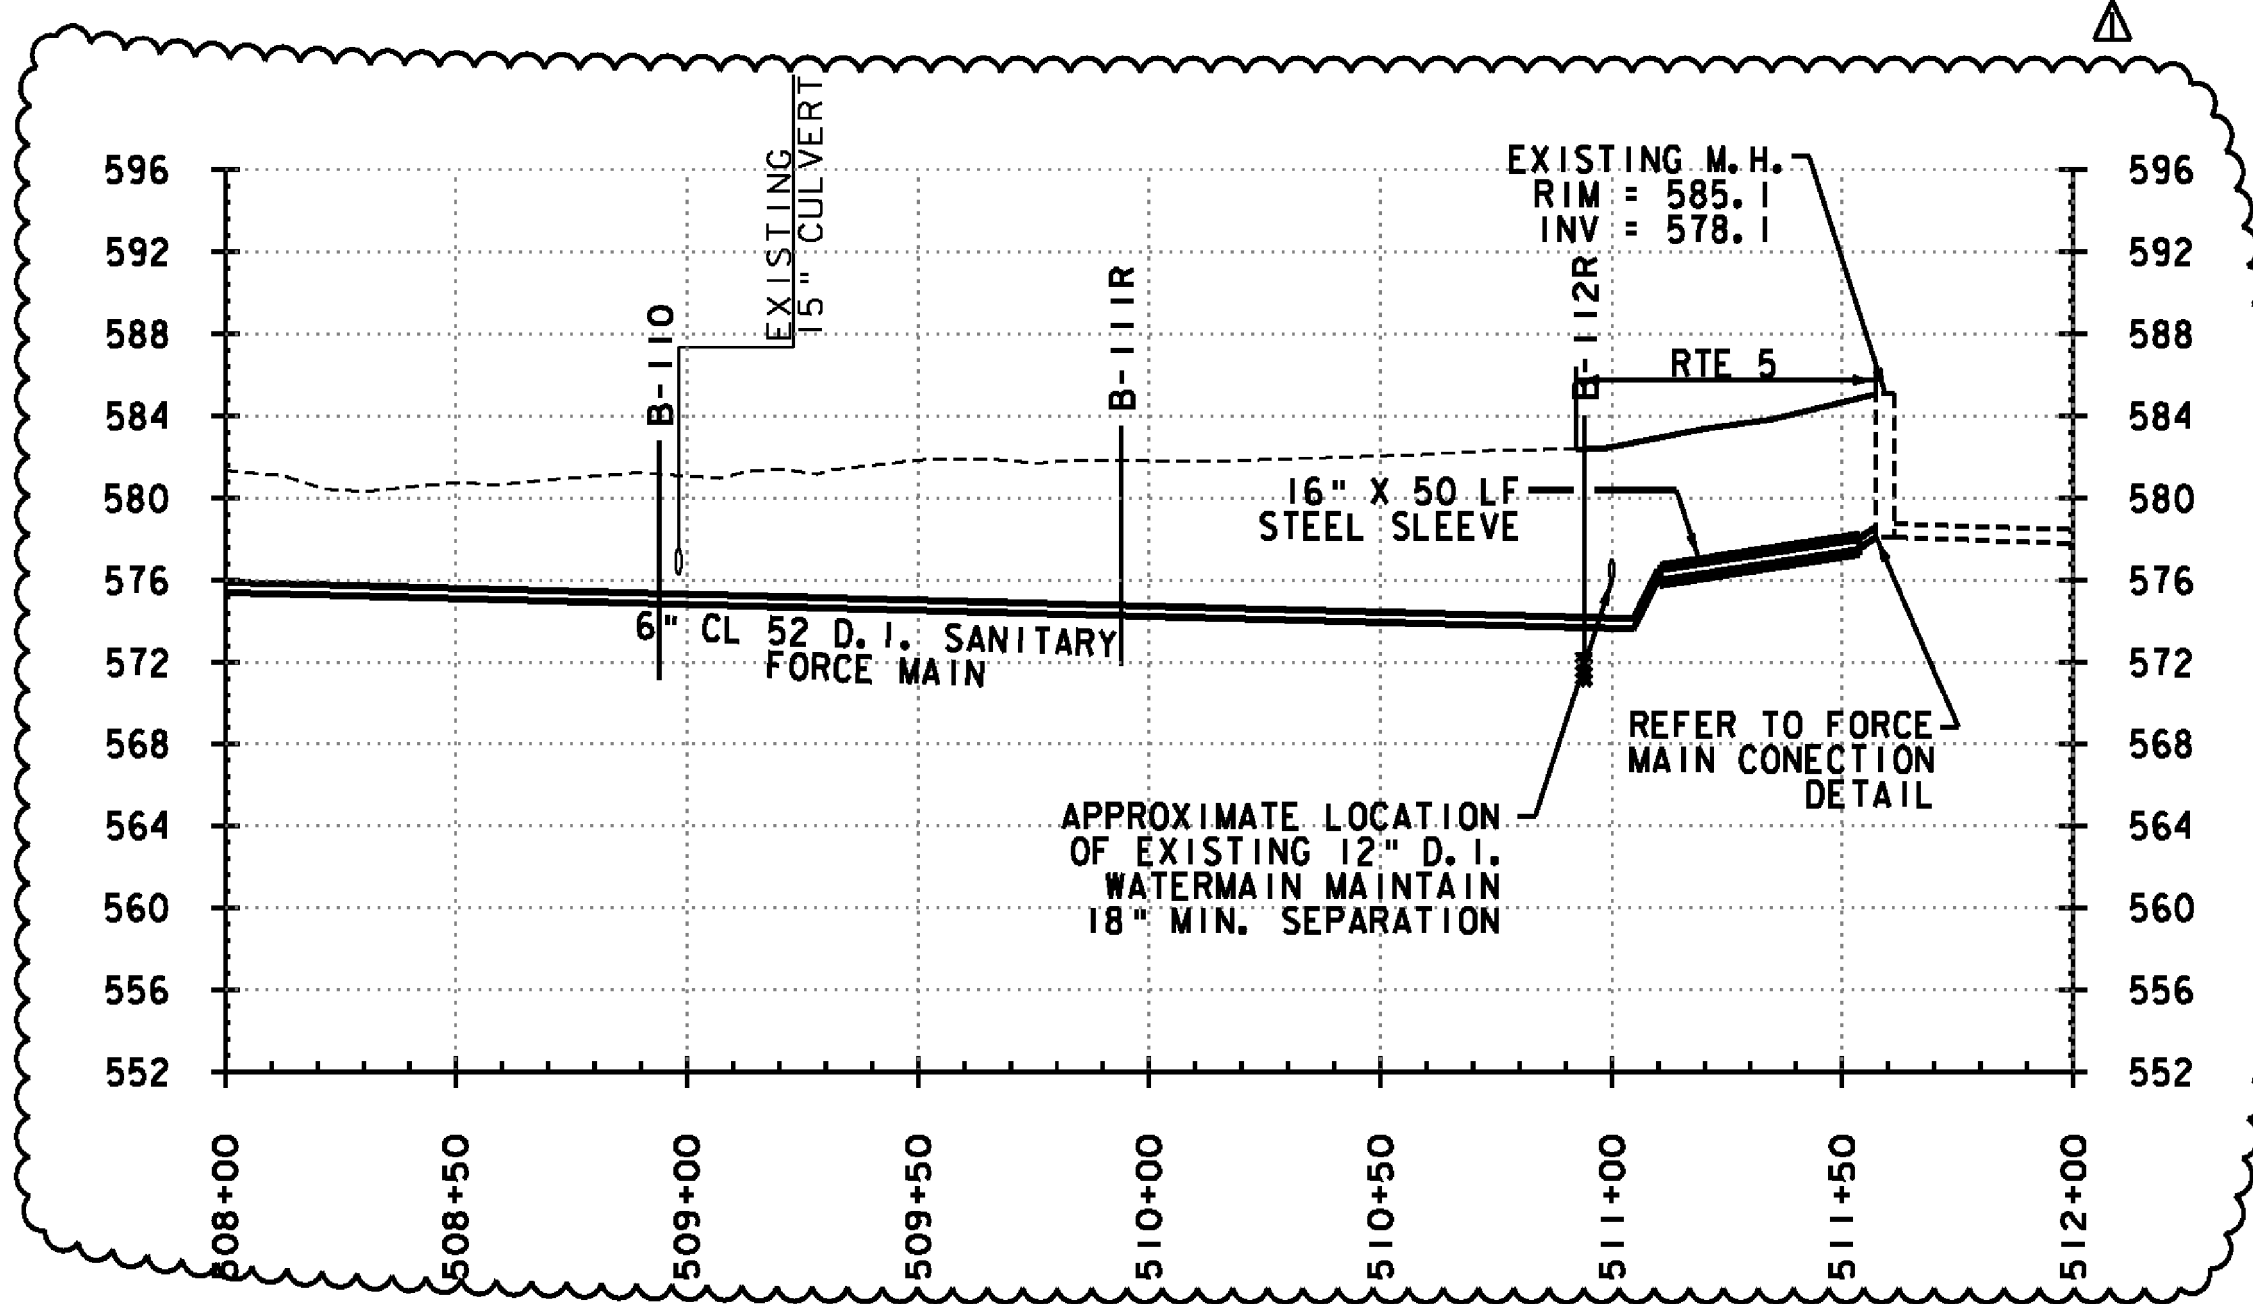


▲ DESIGN REVISIONS DUE TO UTILITY CONFLICT

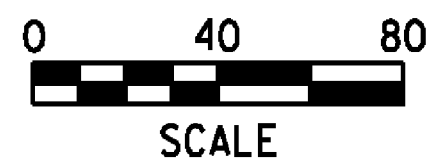

PROJECT NAME:	HARTFORD REST AREAS
PROJECT NUMBER:	IM BLDG(10)
FILE NAME:	...U04A026PLT-UTL(revised).dgn
PLOT DATE:	9/16/2008
PROJECT LEADER:	JTM
DRAWN BY:	PZA
DESIGNED BY:	MEHP
CHECKED BY:	JTM
PLAN & PROFILE SHEET 11	SHEET 49R OF 70