
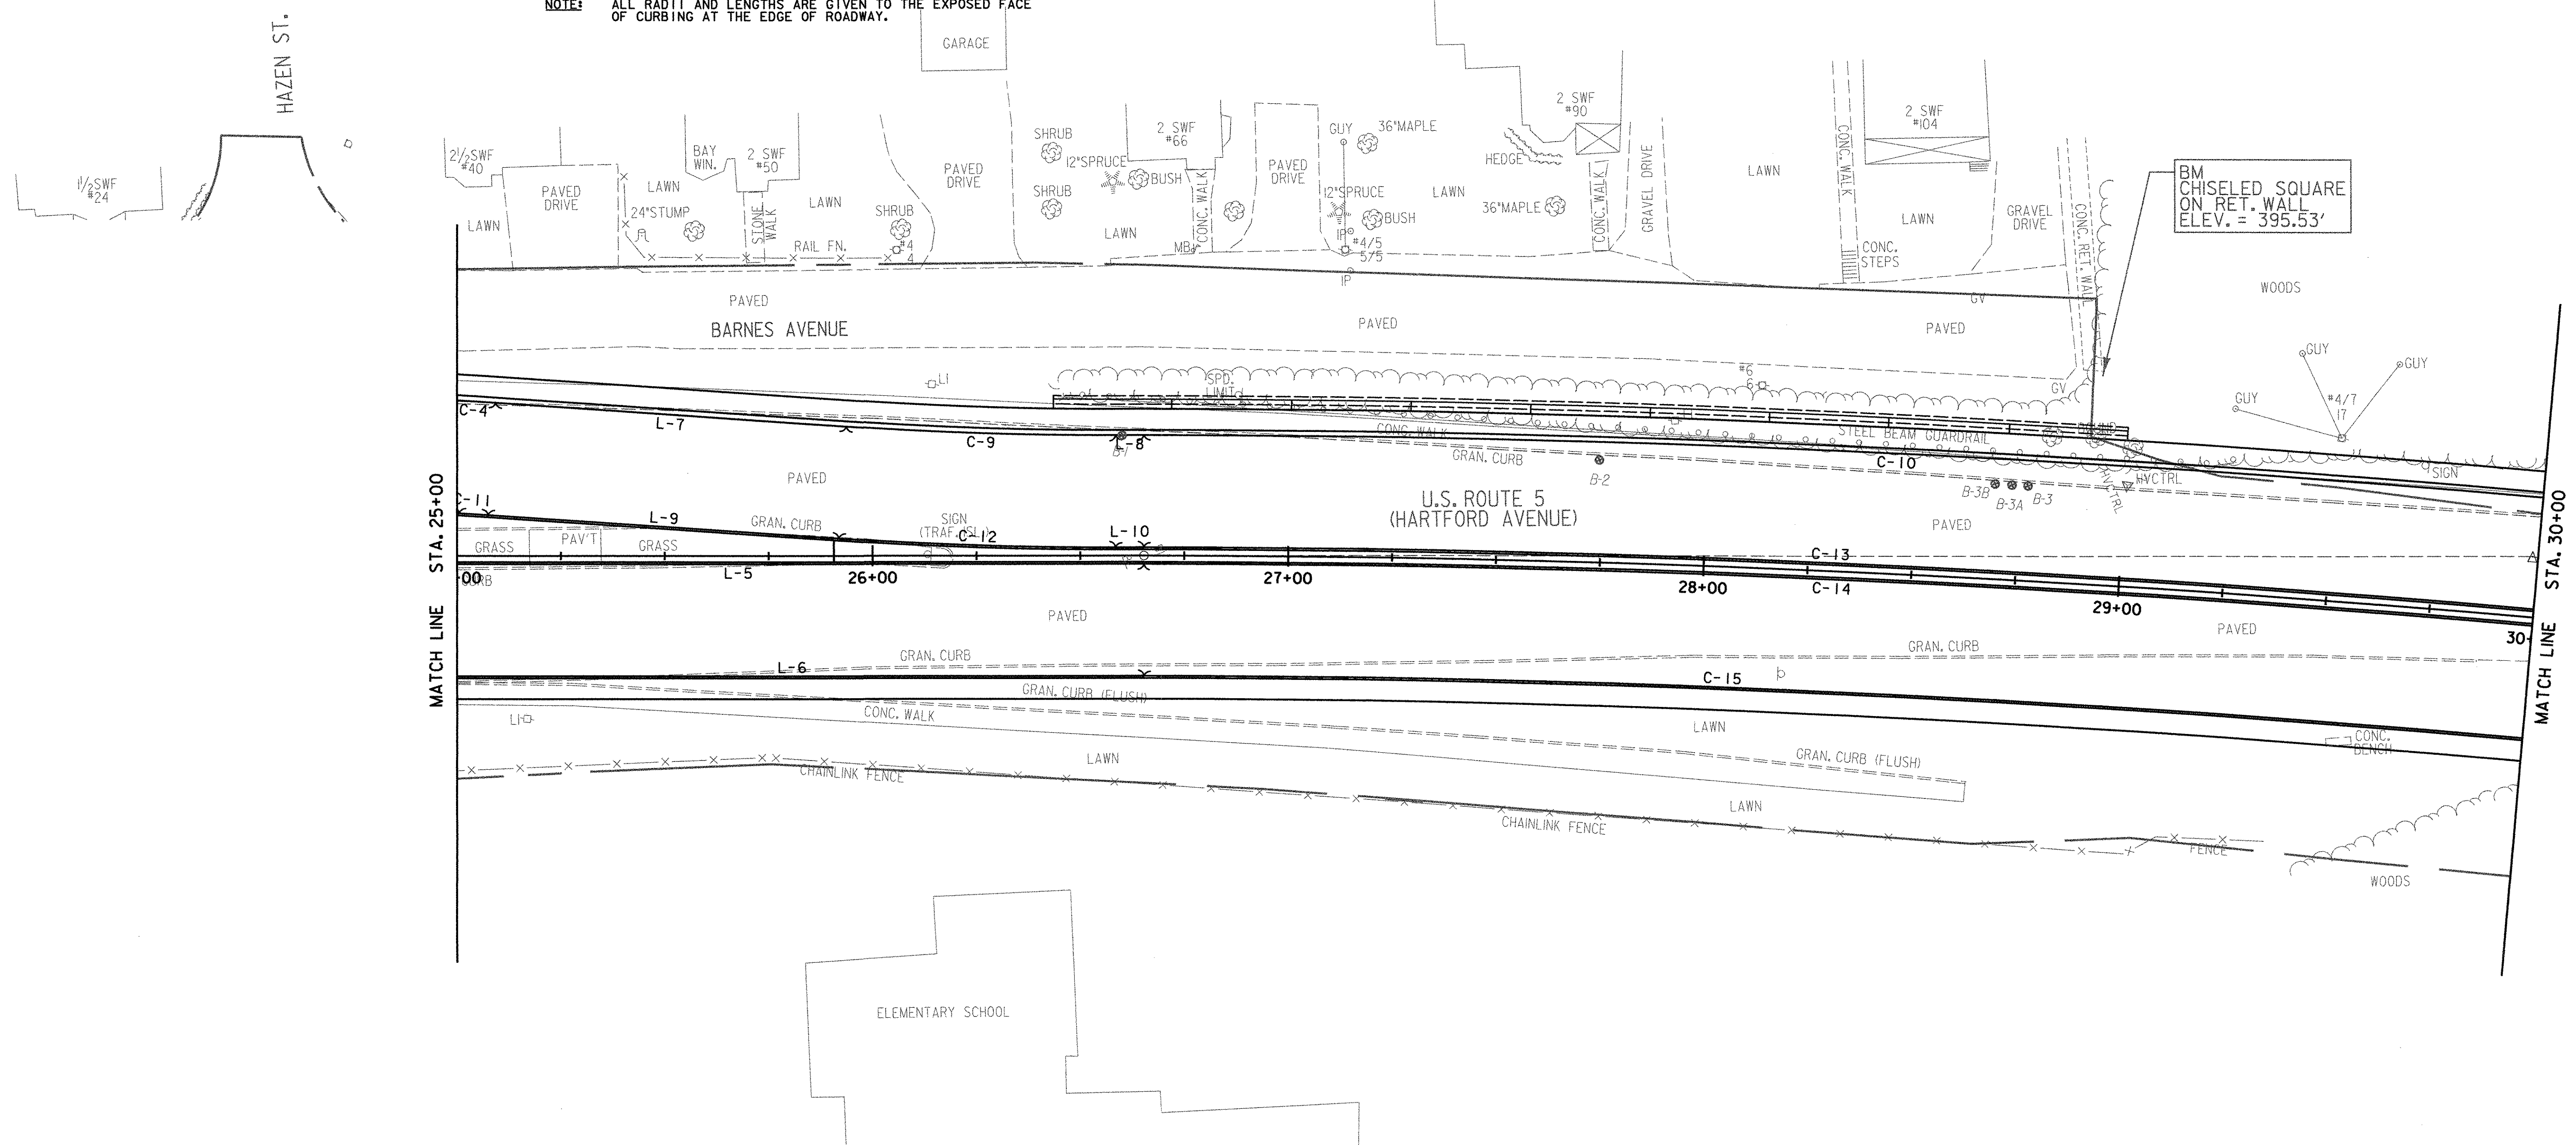


ROADWAY CURB TIES						
LABEL	BEGIN		END		RADIUS (ft)	LENGTH (ft)
	STATION	OFFSET	STATION	OFFSET		
C-4*	24+70.35	38.82 LT	25+09.27	36.79 LT	1009.91	38.97
L-7*	25+09.27	36.79 LT	25+93.69	31.16 LT	N/A	84.60
C-9*	26+93.69	31.16 LT	26+58.48	29.00 LT	974.00	64.84
L-8*	26+58.48	29.00 LT	26+65.31	29.00 LT	N/A	6.83
C-10*	26+65.31	29.00 RT	33+32.06	29.00 LT	3848.72	671.81
L-5	22+01.15	29.00 RT	26+65.31	29.00 RT	N/A	484.16
C-15	26+65.31	29.00 RT	33+32.06	29.00 RT	3780.72	661.69

MEDIAN ISLAND CURB TIES						
LABEL	BEGIN		END		RADIUS (ft)	LENGTH (ft)
	STATION	OFFSET	STATION	OFFSET		
C-11	25+00.51	10.28 LT	25+07.48	9.84 LT	978.91	6.98
L-9	25+07.48	9.84 LT	25+91.89	4.22 LT	N/A	84.60
C-12	25+91.89	4.22 LT	26+58.48	2.00 LT	1001.00	66.64
L-10	26+58.48	2.00 LT	26+65.31	2.00 LT	N/A	6.83
C-13	26+65.31	2.00 LT	33+32.06	2.00 LT	3821.72	667.10
L-6	21+60.94	2.00 RT	26+65.31	2.00 RT	N/A	504.37
C-14	26+65.31	2.00 RT	33+32.06	2.00 RT	3817.72	666.40


\* = FACE OF CONCRETE MEDIAN BARRIER (MOD.)

NOTE: ALL RADII AND LENGTHS ARE GIVEN TO THE EXPOSED FACE OF CURBING AT THE EDGE OF ROADWAY.

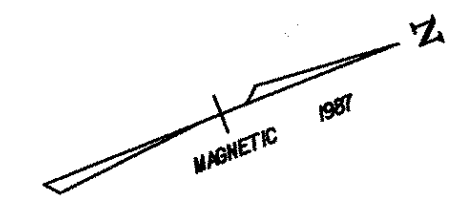

**CURB TIE LAYOUT SHEET 2**

DATUM  
 VERTICAL NGVD 1929  
 HORIZONTAL N/A

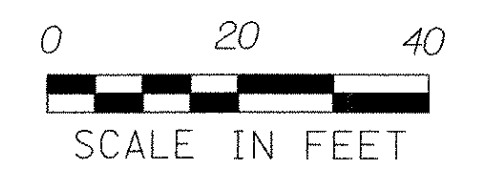

PROJECT: HARTFORD	PROJECT NO. : RS 0113(40)
DESIGN FILE NAME: z86c027curbbdr.DGN	PLOT DATE: 1/13/2007
IPARM FILE NAME:	SURVEY DATE: 1/87
SURVEYED BY: FANTONI	DRAWN BY: E. ATKINS
SQUAD LEADER: KEN UPMAL	SHEET: 69 OF 239