

EXISTING DRAINAGE

59 56+61 LT ~ 57+16 RT
EXISTING DI - ABANDON
EXISTING PIPE - REMOVE

60 57+17 RT
EXISTING DI - ABANDON

61 57+16 RT ~ 58+40 RT
EXISTING PIPE & DI - REMOVE

62 58+40 RT ~ 60+92 RT
EXISTING PIPE & DI - REMOVE

63 50+79 LT ~ 50+95 RT (HEWITT ST)
EXISTING PIPE - RETAIN

NEW DRAINAGE

82 40+36 LT (DEVIN ST) ~ 55+12.0 RT
NEW 18"x20" RCP/CPEP (SL)
W/CB @ 40+36 LT

83 55+12.0 LT ~ 55+12.0 RT
NEW 18"x32" RCP/CPEP (SL) 35'
W/CB @ 55+12.0 LT

84 55+12.0 RT ~ 56+00.0 RT
NEW 18"x64" RCP/CPEP (SL) 85'
W/MH @ 55+12.0 RT

85 56+00.0 RT ~ 56+77.7 RT
NEW 18"x74" RCP/CPEP (SL) 76'
W/CB @ 56+00.0 RT

86 56+00.0 LT ~ 56+77.7 LT
NEW 18"x74" RCP/CPEP (SL) 76'
W/CB @ 56+00.0 LT

NEW DRAINAGE (CONT.)

87 56+77.7 LT ~ 56+77.7 RT
NEW 18"x36" RCP/CPEP (SL)
W/CB @ 56+77.7 LT

88 56+77.7 RT ~ 58+40.0 RT
NEW 18"x58" RCP/CPEP (SL) 160'
W/CB @ 56+77.7 RT

89 45+35.2 RT ~ 45+37.3 LT (ADVENT LN)
NEW 18"x12" RCP/CPEP (SL)
W/CB @ 45+35.2 RT

90 45+37.3 LT (ADVENT LN) ~ 58+40.0 RT
NEW 18"x18" RCP/CPEP (SL)
W/CB @ 45+37.3 LT

91 58+65.0 LT ~ 58+40.0 RT
NEW 18"x44" RCP/CPEP (SL)
W/CB @ 58+65.0 LT

92 58+40.0 RT ~ 60+91.7 RT
NEW 24"x250" RCP/CPEP (SL)
W/CB @ 58+40.0 RT

8" UNDERDRAIN (MOD.)

56 54+00 LT ~ 56+75 LT
NEW 8"x274" UNDERDRAIN
W/F.B. @ 54+00 LT

57 55+12 RT ~ 56+77.7 RT
NEW 8"x166" UNDERDRAIN
W/F.B. @ 55+12 RT

58 56+77.7 LT ~ 57+89 RT
NEW 8"x112" UNDERDRAIN
W/F.B. @ 57+89 RT




59 58+43 RT ~ 59+50 RT
NEW 8"x106" UNDERDRAIN
W/F.B. @ 59+50 RT

8" UNDERDRAIN CARRIER PIPE (MOD.)

61 56+75 LT ~ 56+77.7 LT
NEW 8"x4" UNDERDRAIN CARRIER PIPE
W/F.B. @ 56+75 LT

62 56+77.7 RT ~ 56+77.7 RT
NEW 8"x4" UNDERDRAIN CARRIER PIPE
W/F.B. @ 56+77.7 RT

63 58+40 RT ~ 58+43 RT
NEW 8"x4" UNDERDRAIN CARRIER PIPE
W/F.B. @ 58+43 RT

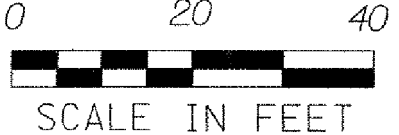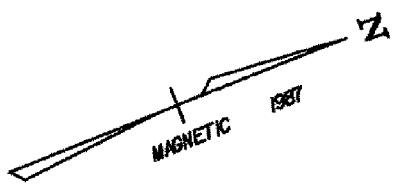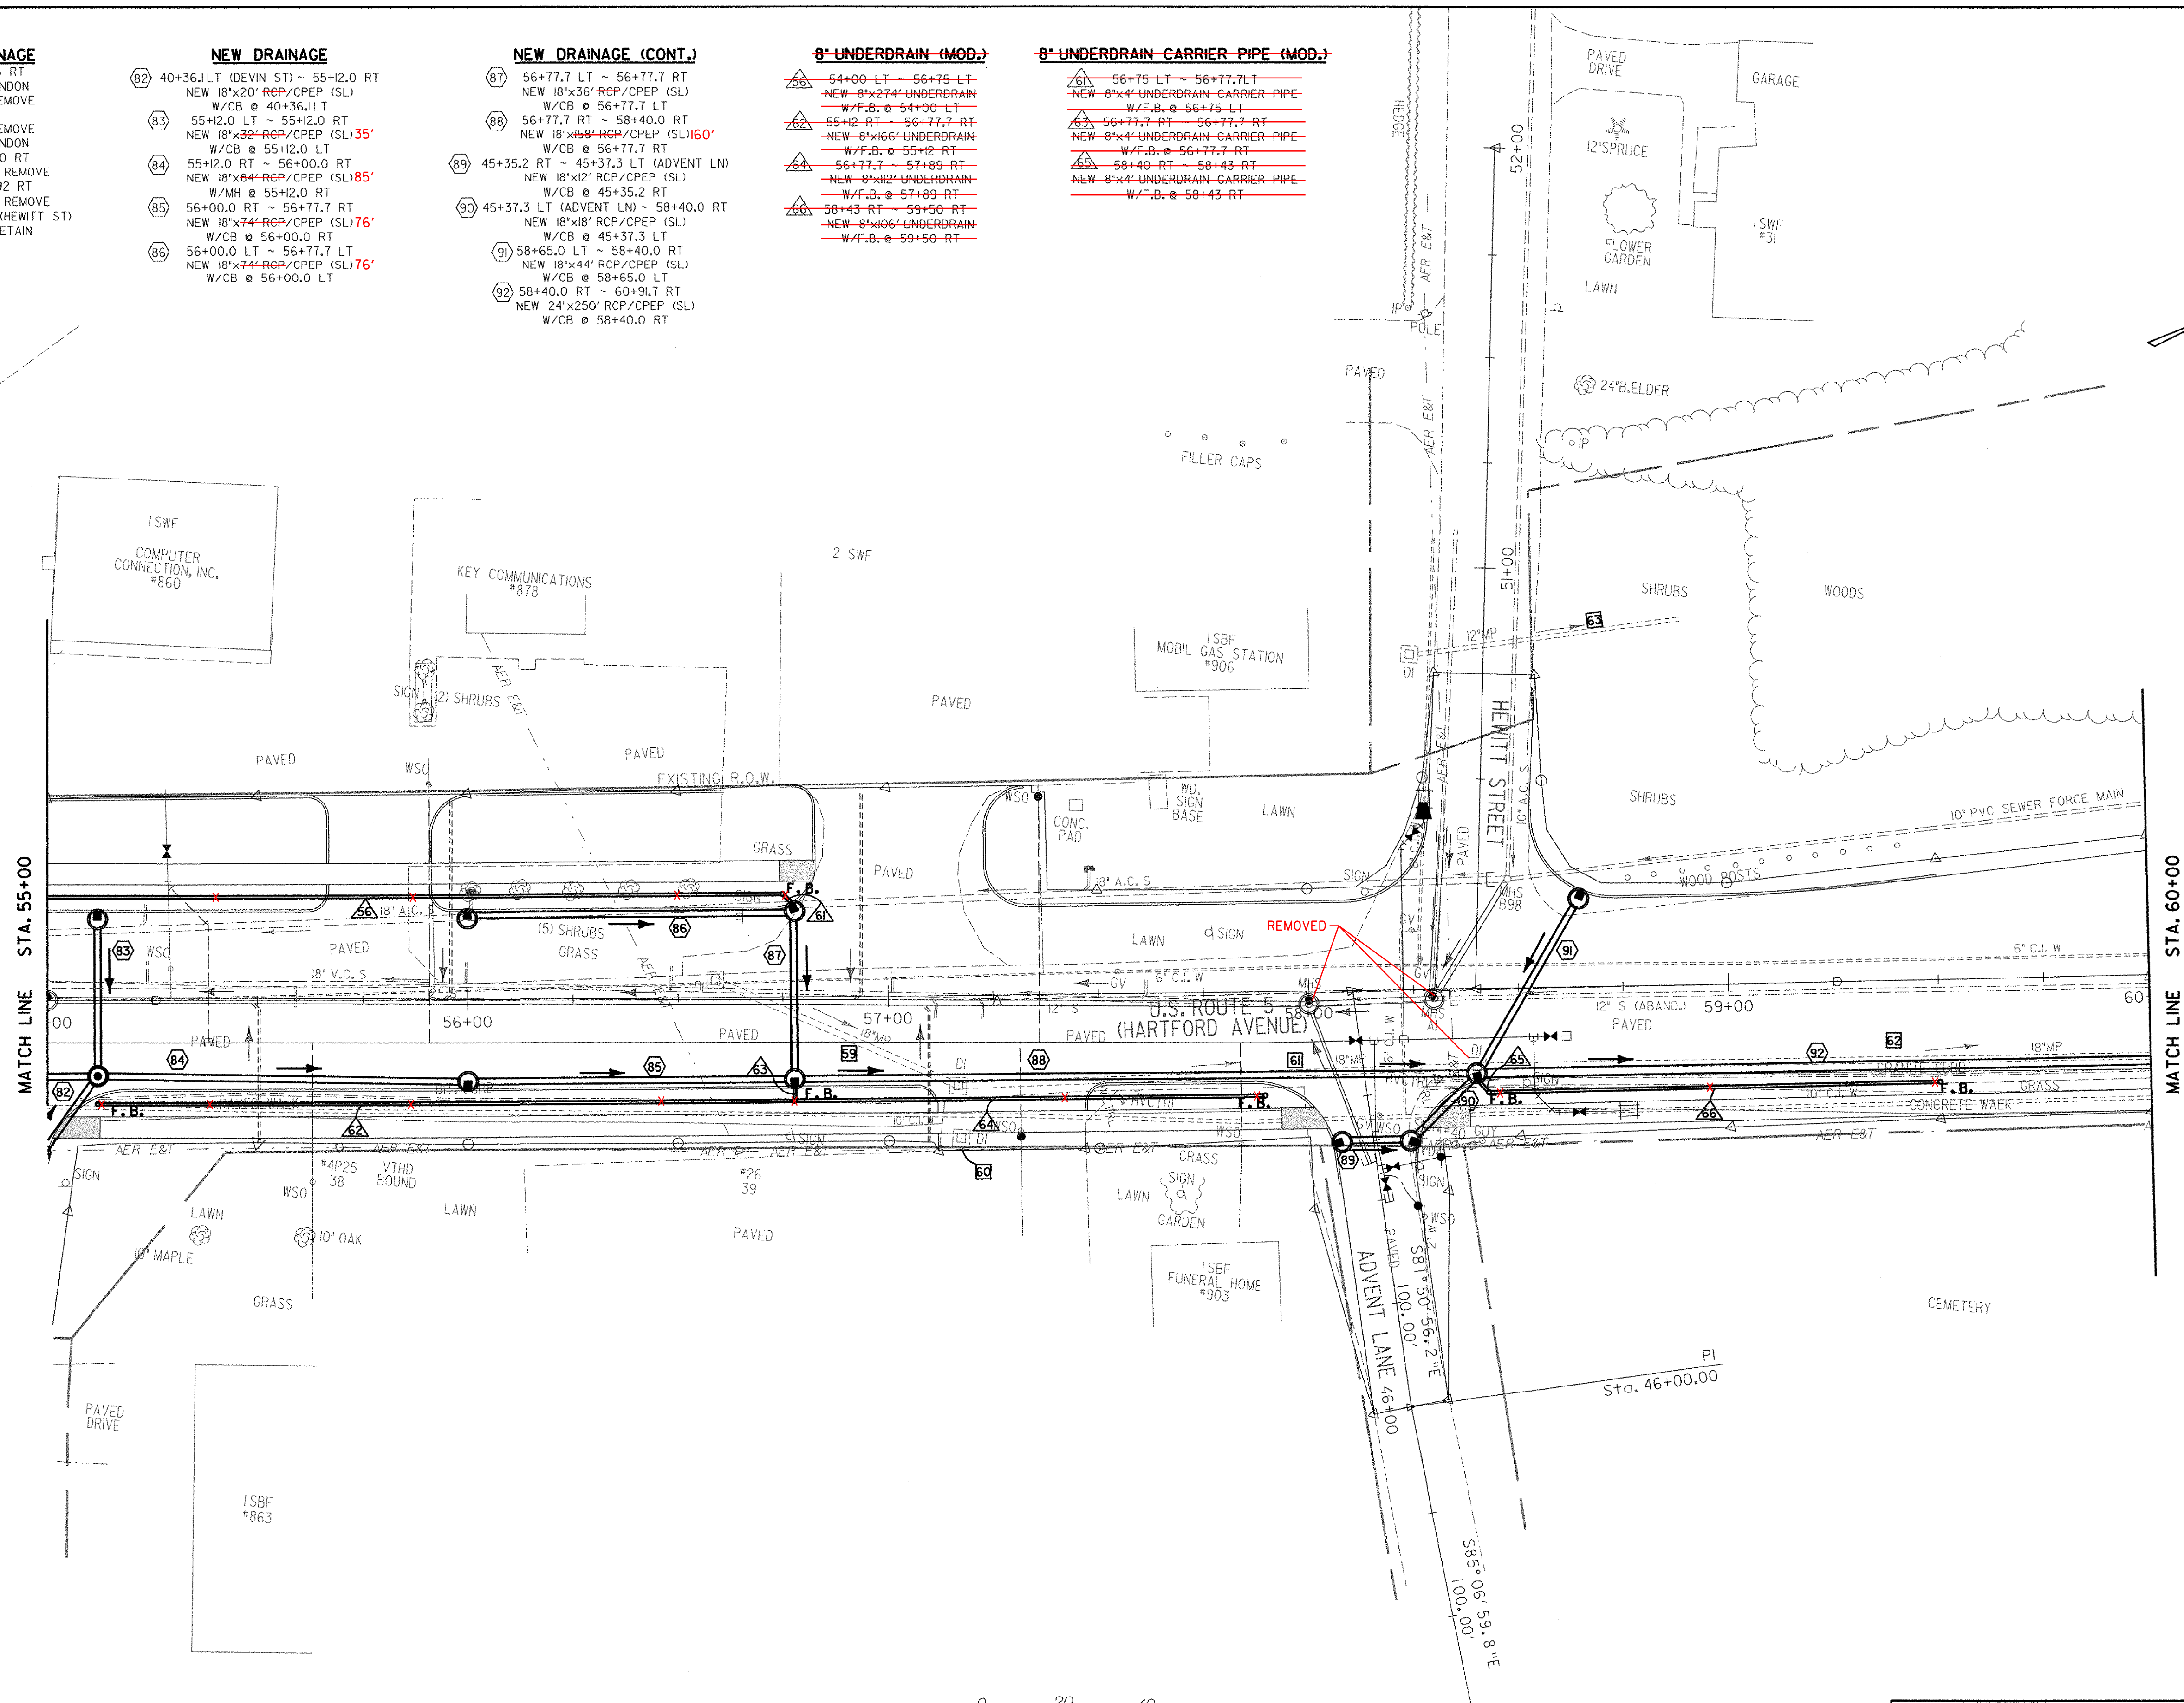

DATUM

VERTICAL NGVD 1929

HORIZONTAL N/A

- NOTES:**
- SEE UTILITY CONSTRUCTION GENERAL NOTES SHEET FOR PROPOSED STORM DRAINAGE CONSTRUCTION NOTES.
 - REFER TO WATER AND SANITARY SEWER LAYOUT SHEETS FOR PROPOSED WATER AND SEWER LAYOUT.
 - SEE ROADWAY LAYOUT SHEETS FOR PLACEMENT OF STONE FILL.

PROJECT: HARTFORD	PROJECT NO. : RS 0113(40)
DESIGN FILE NAME: z86c027drnbnr.DGN	PLOT DATE: 1/31/2007
IPARM FILE NAME:	SURVEY DATE: 1/87
SURVEYED BY: FANTONI	DRAWN BY: E. ATKINS
SQUAD LEADER: KEN UPMAL	SHEET: 87 OF 239

DRAINAGE LAYOUT SHEET 8