



# WATER DETAILS

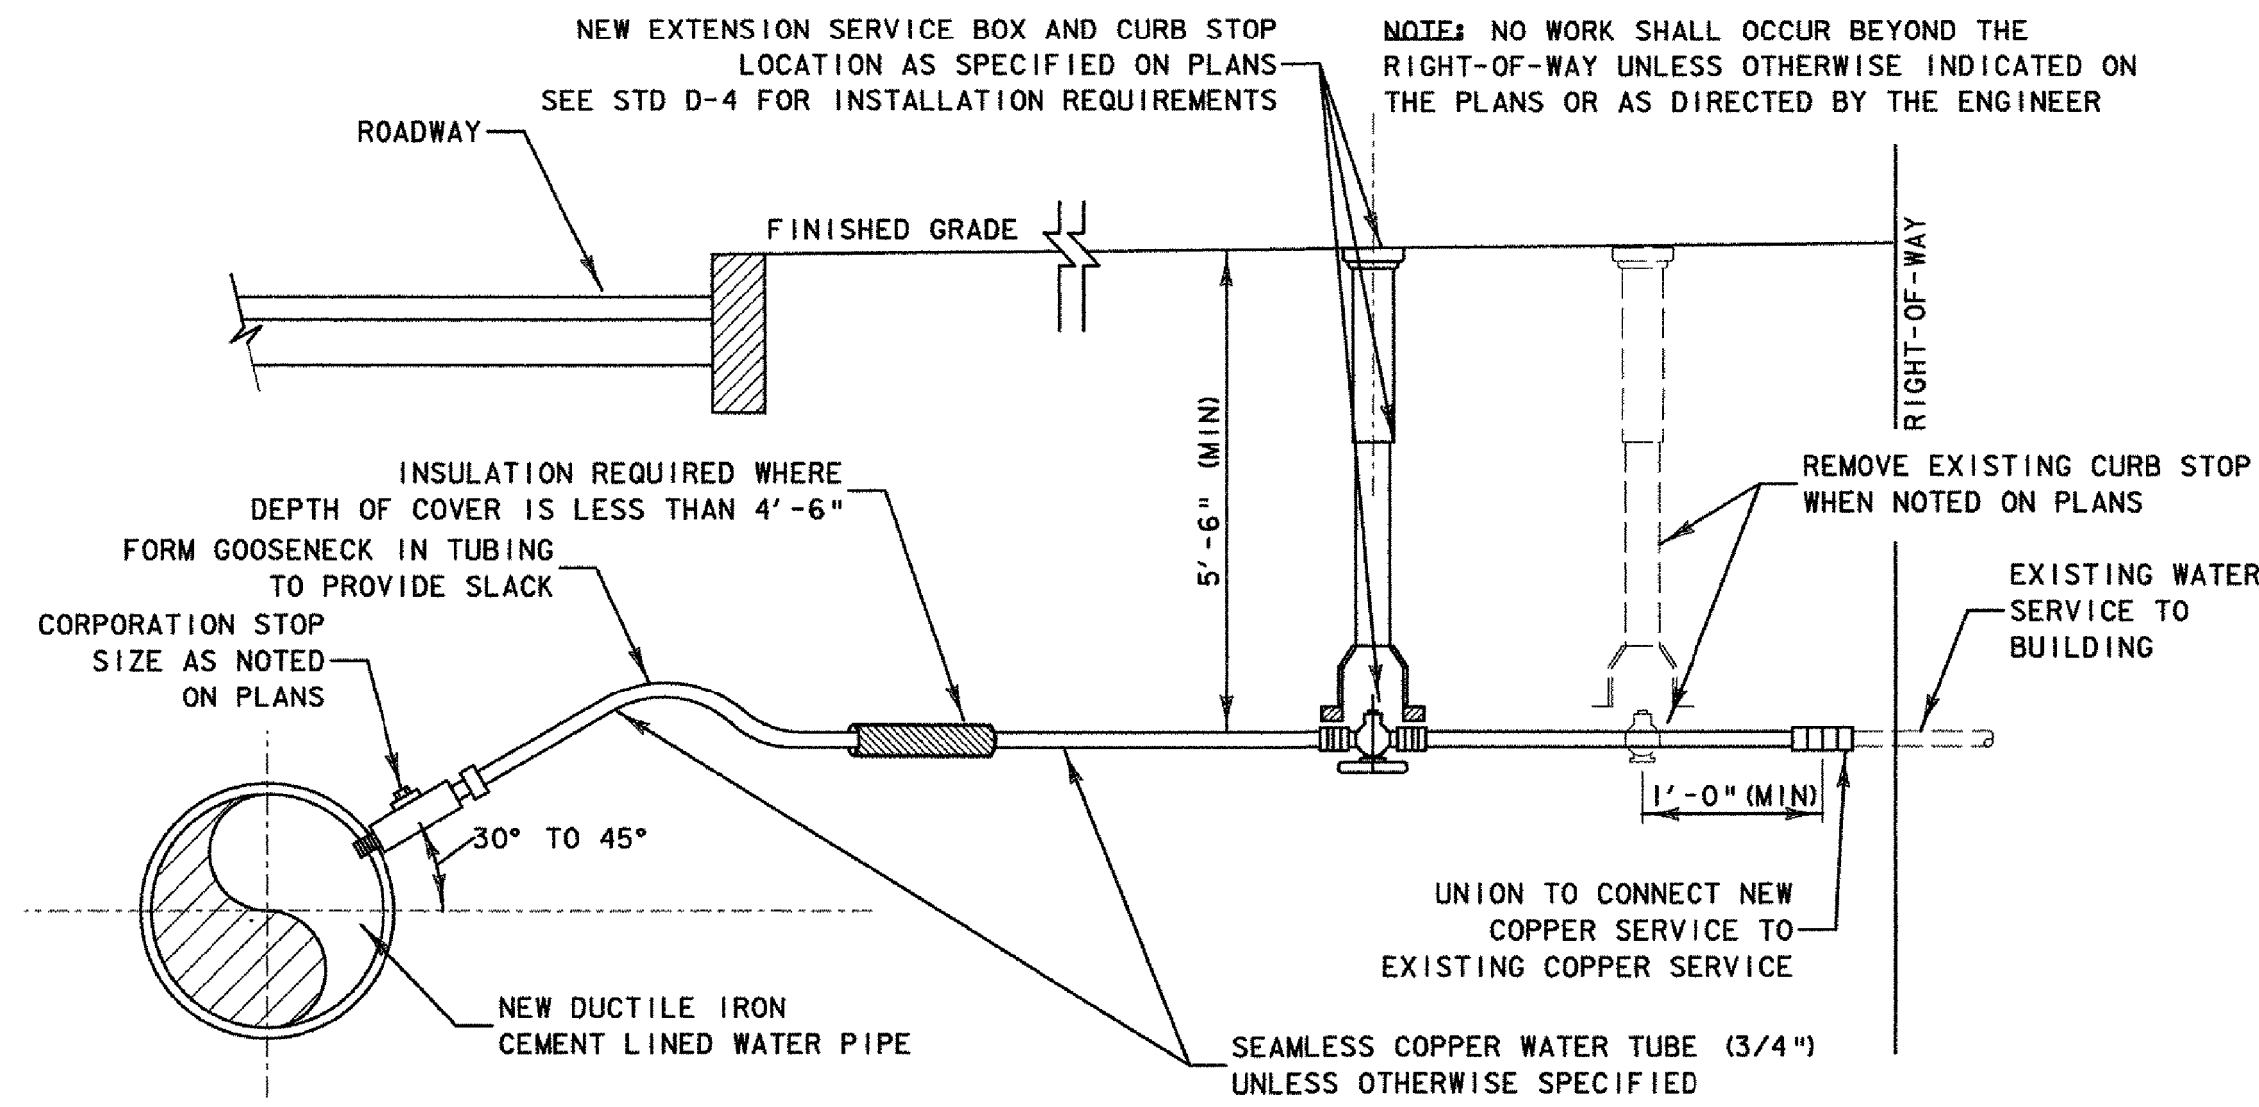

**TYPICAL SEAMLESS COPPER WATER TUBE SERVICE CONNECTION**

NOT TO SCALE

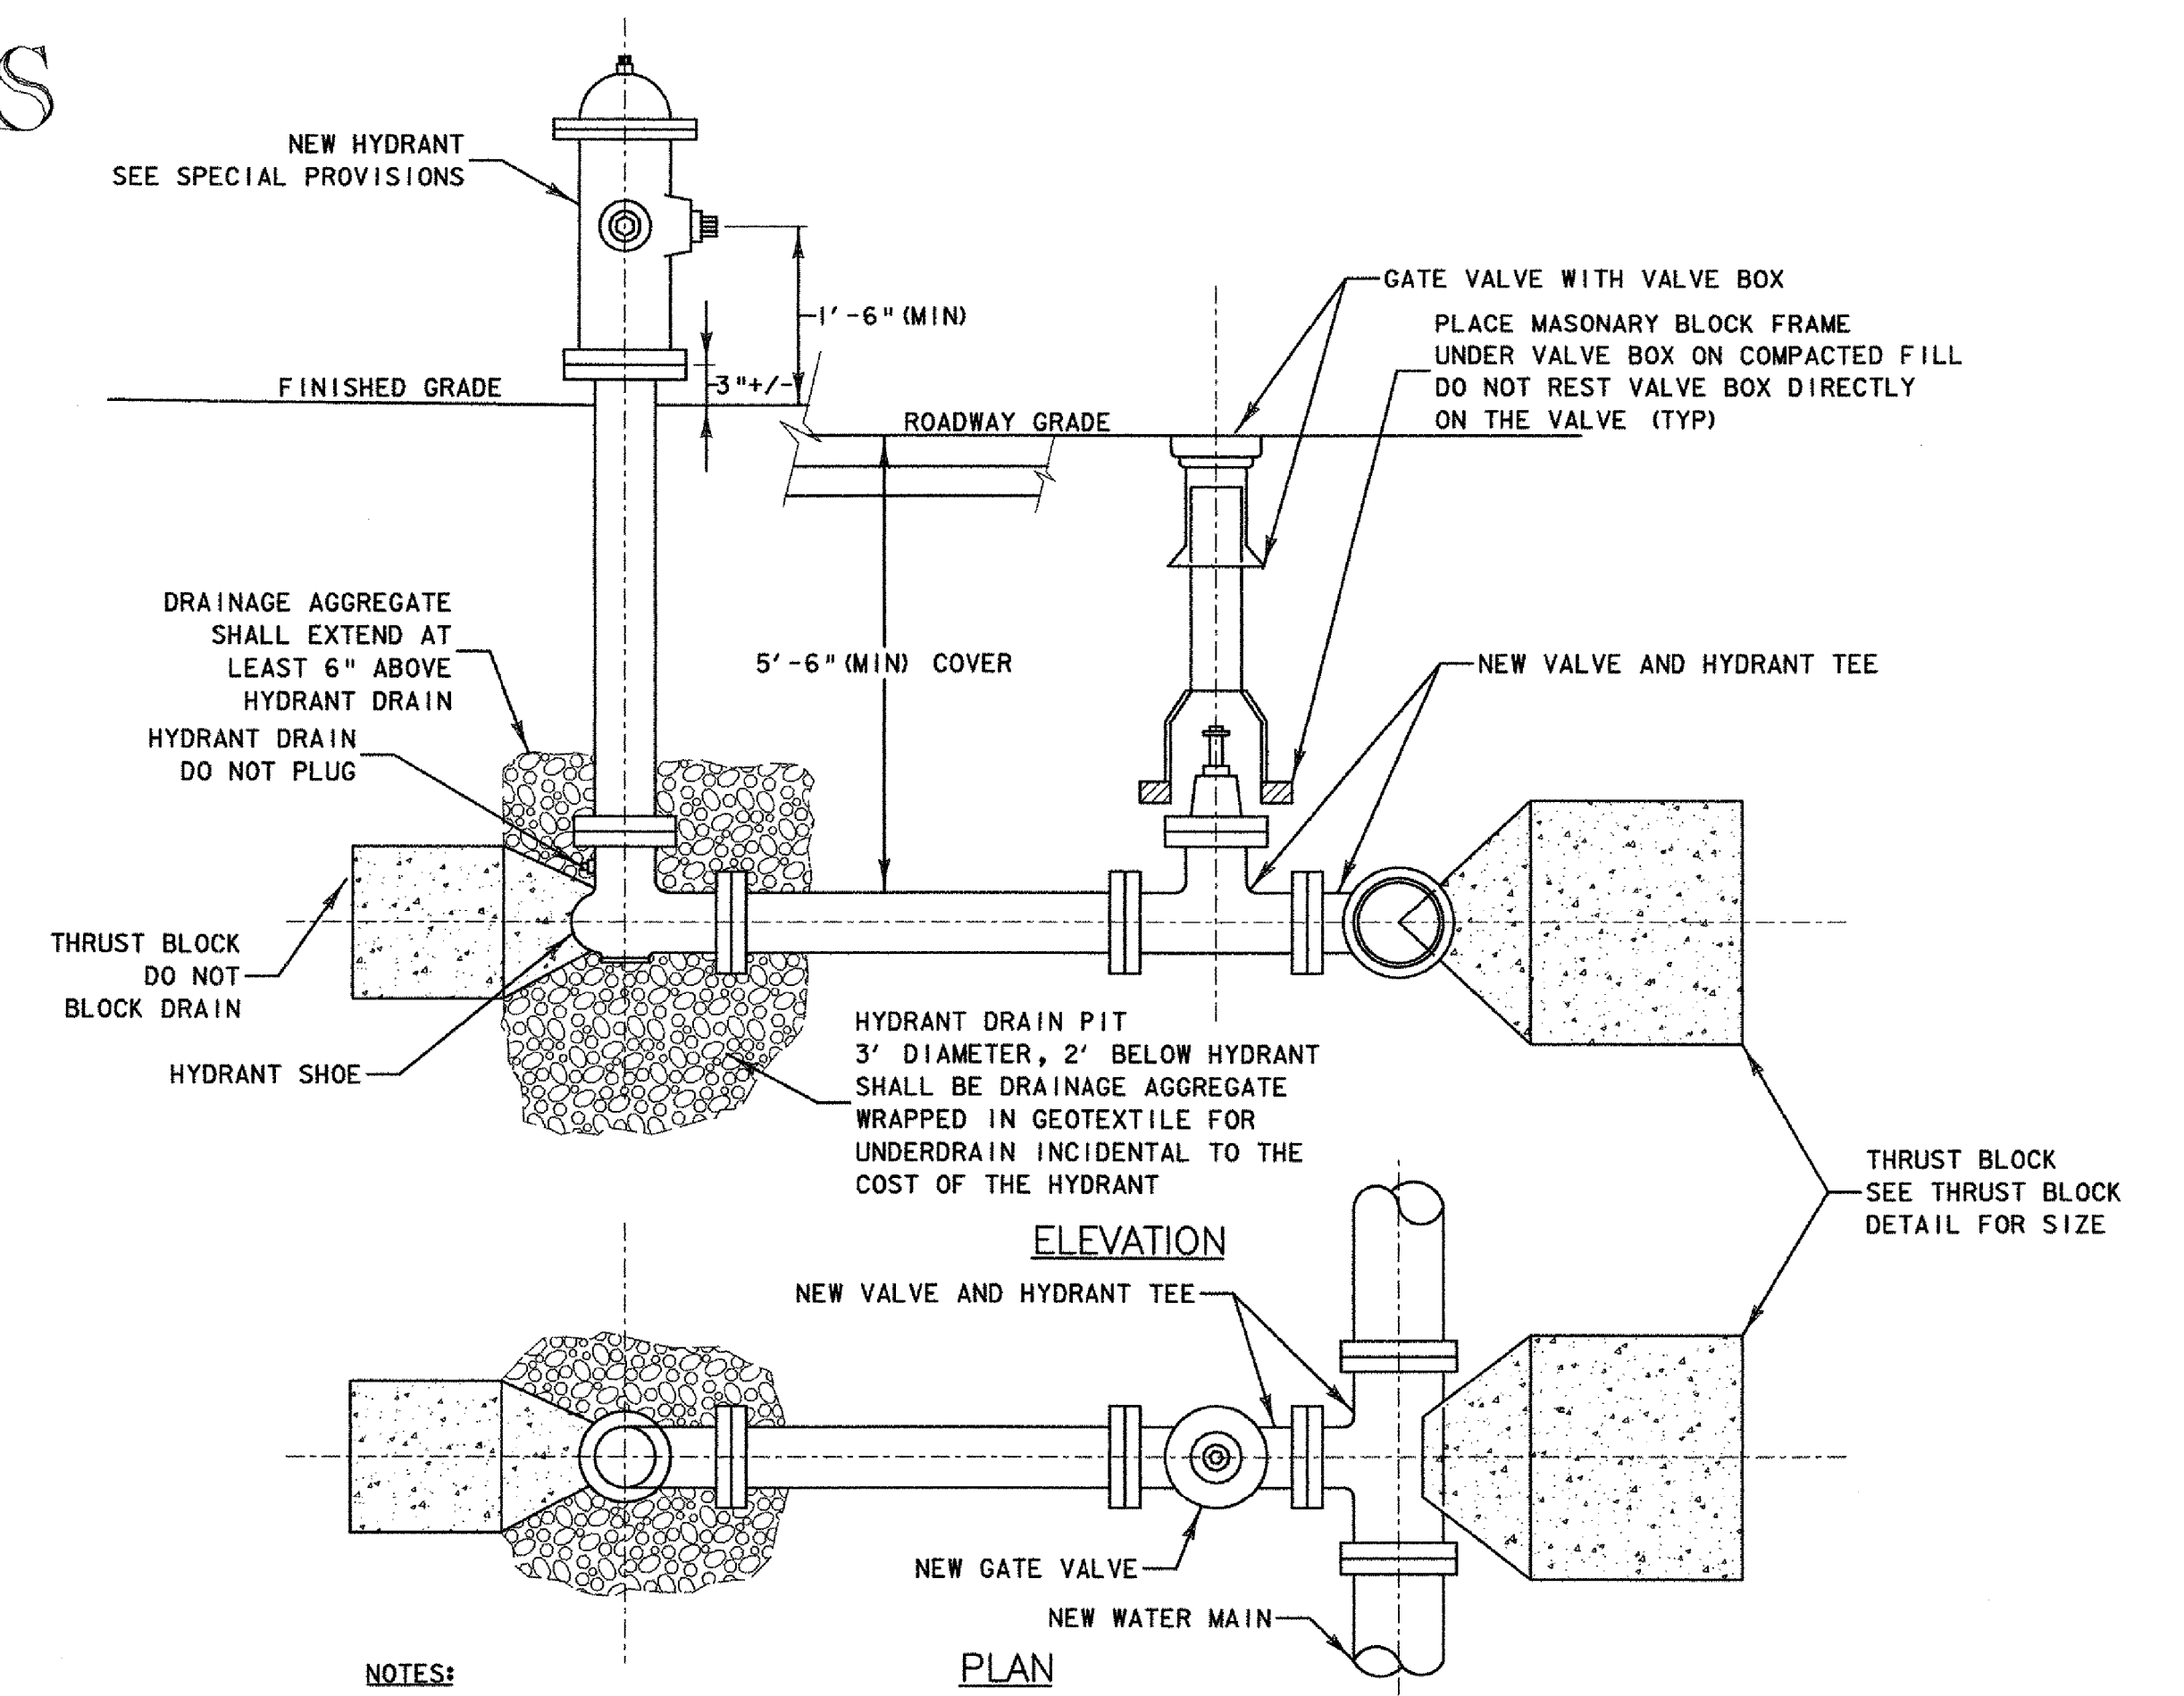


NOTES:

- 1) REFER TO THE TOWN OF HARTFORD WATER ORDINANCE "TYPICAL HYDRANT ASSEMBLY DETAIL" AND THE SPECIAL PROVISIONS FOR ADDITIONAL REQUIREMENTS.
- 2) COORDINATE ALL WATER WORK WITH THE TOWN OF HARTFORD WATER DEPARTMENT.

**TYPICAL FIRE HYDRANT CONNECTION DETAIL**


NOT TO SCALE

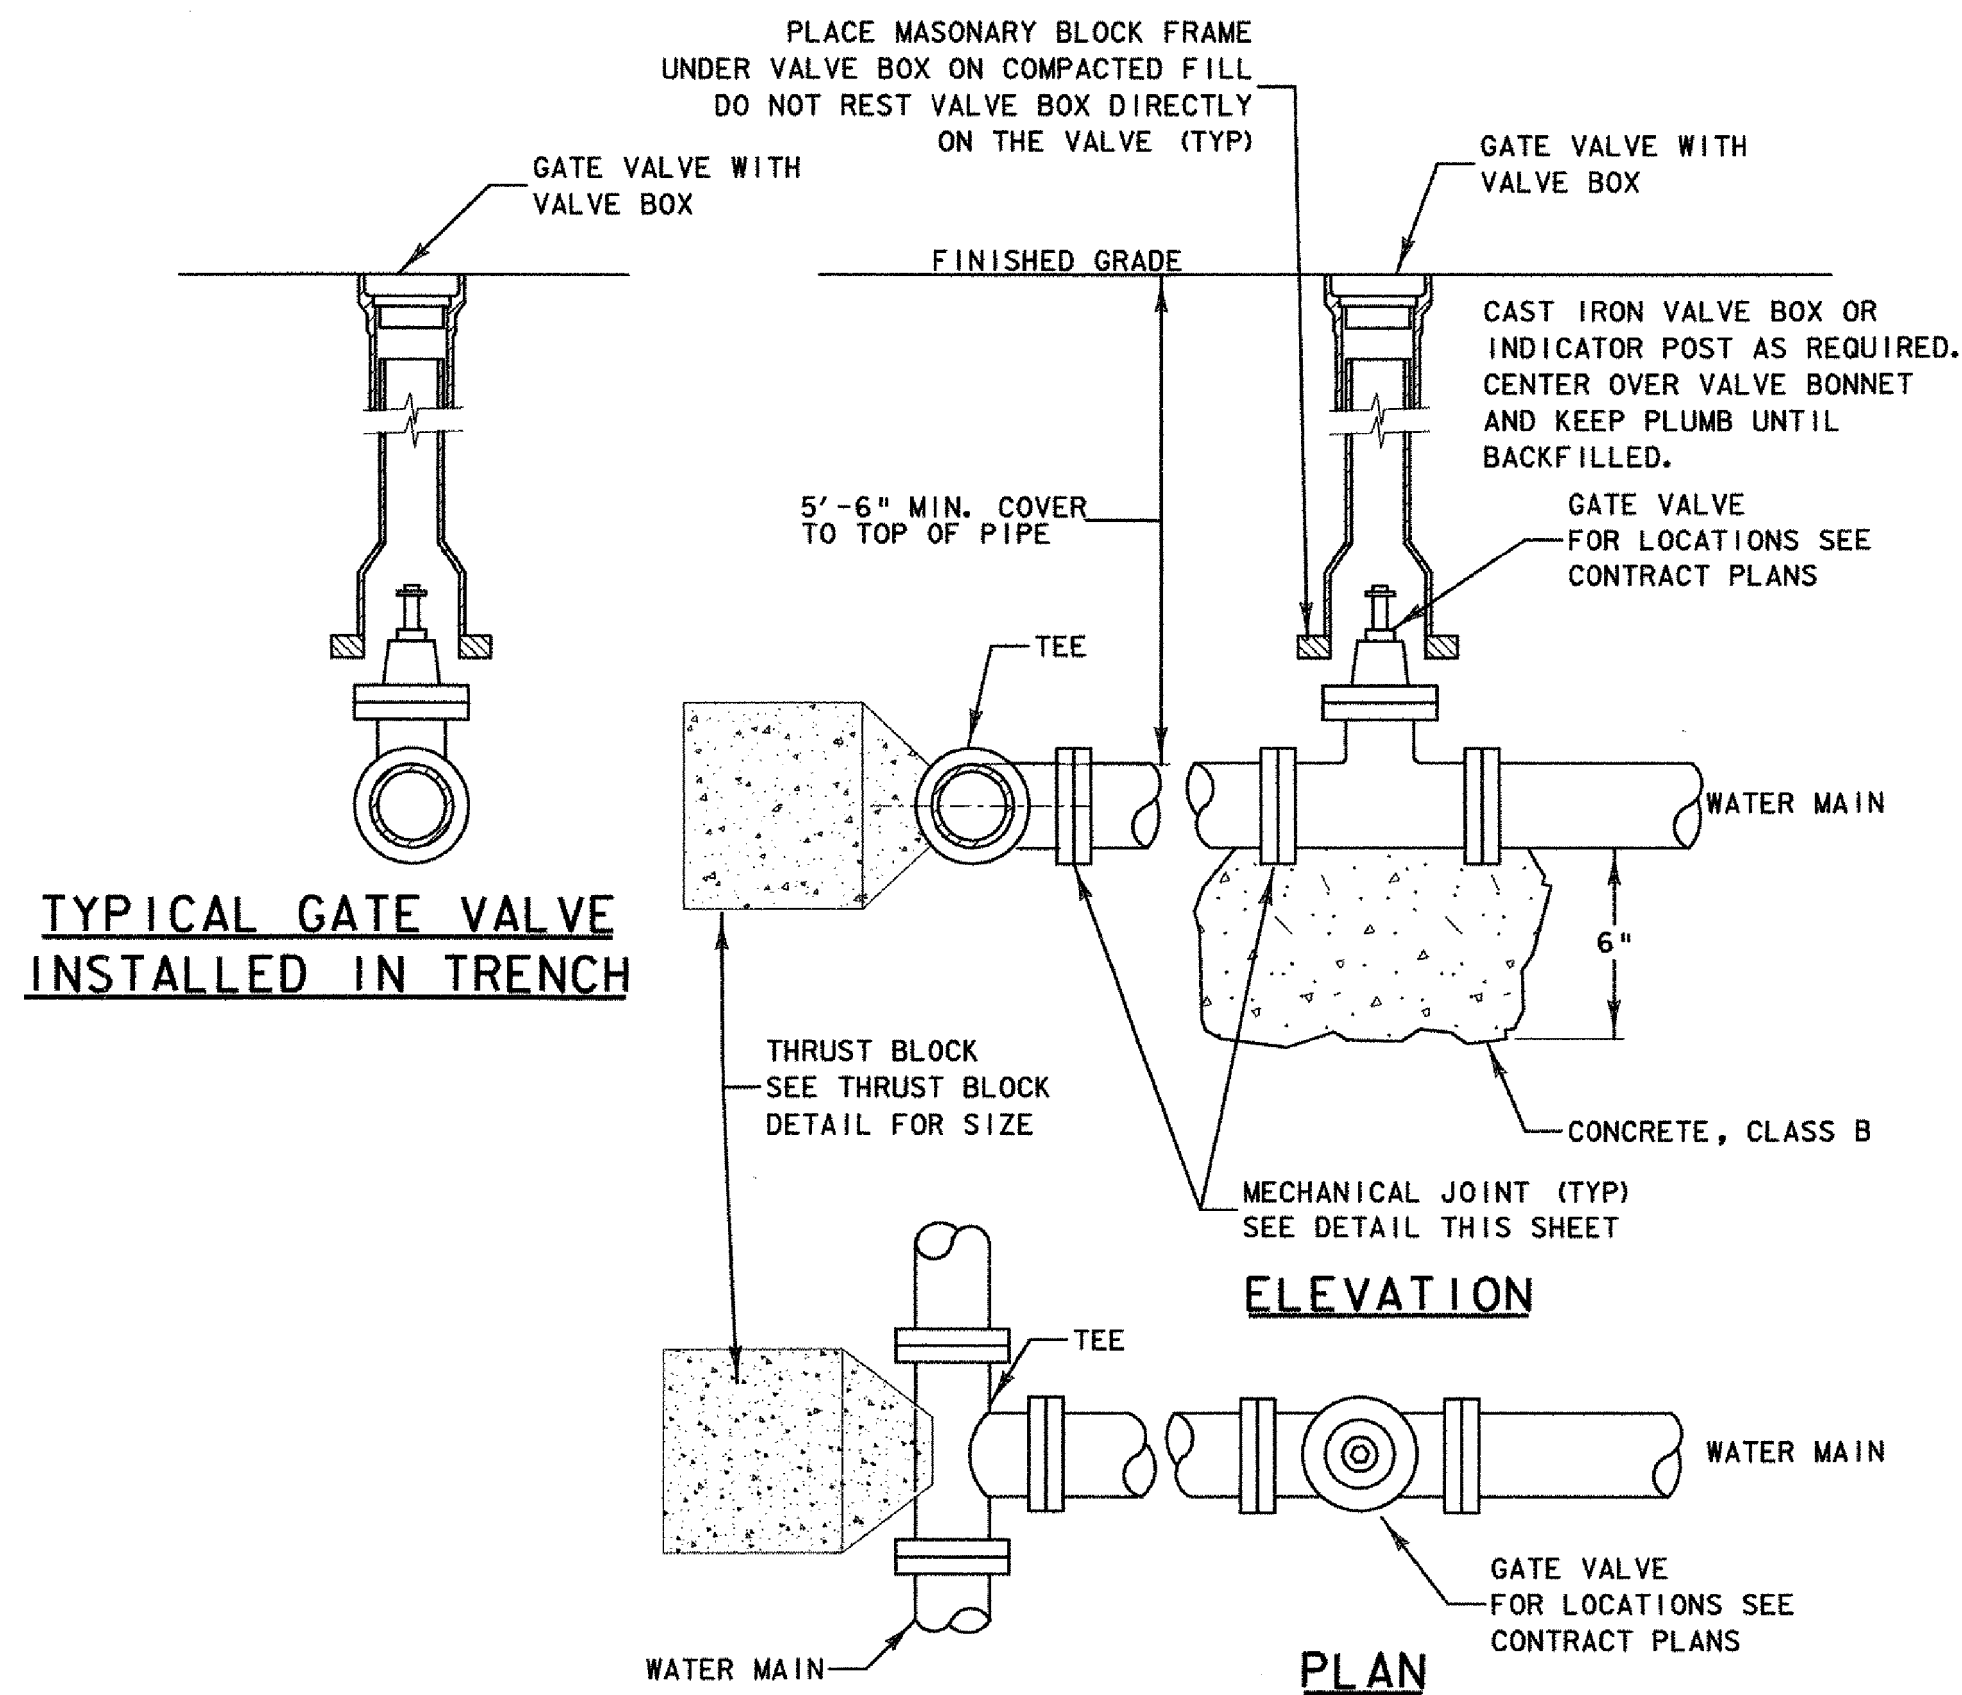

**TYPICAL GATE VALVE INSTALLED IN TRENCH**


**TYPICAL SERVICE BRANCH CONNECTION DETAIL**

NOT TO SCALE

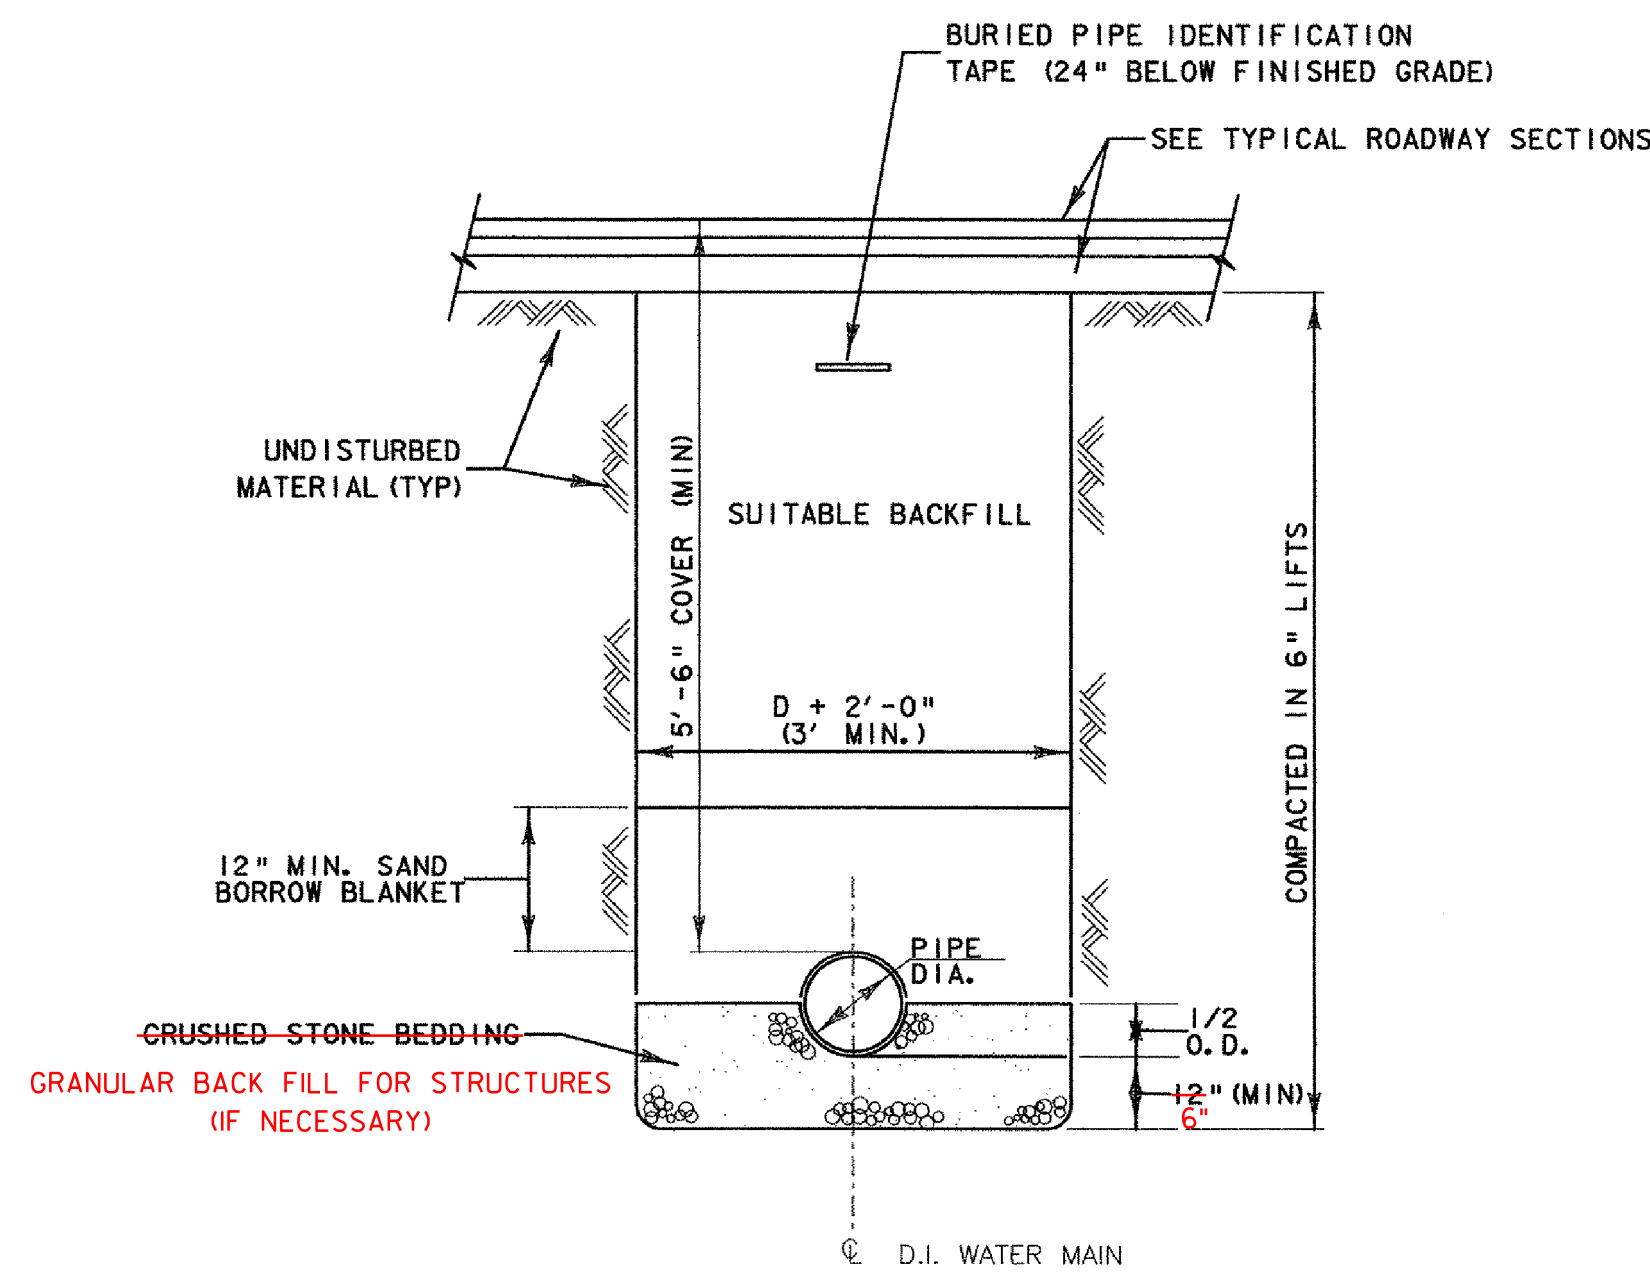

**TYPICAL WATER MAIN TRENCH DETAILS**

NOT TO SCALE

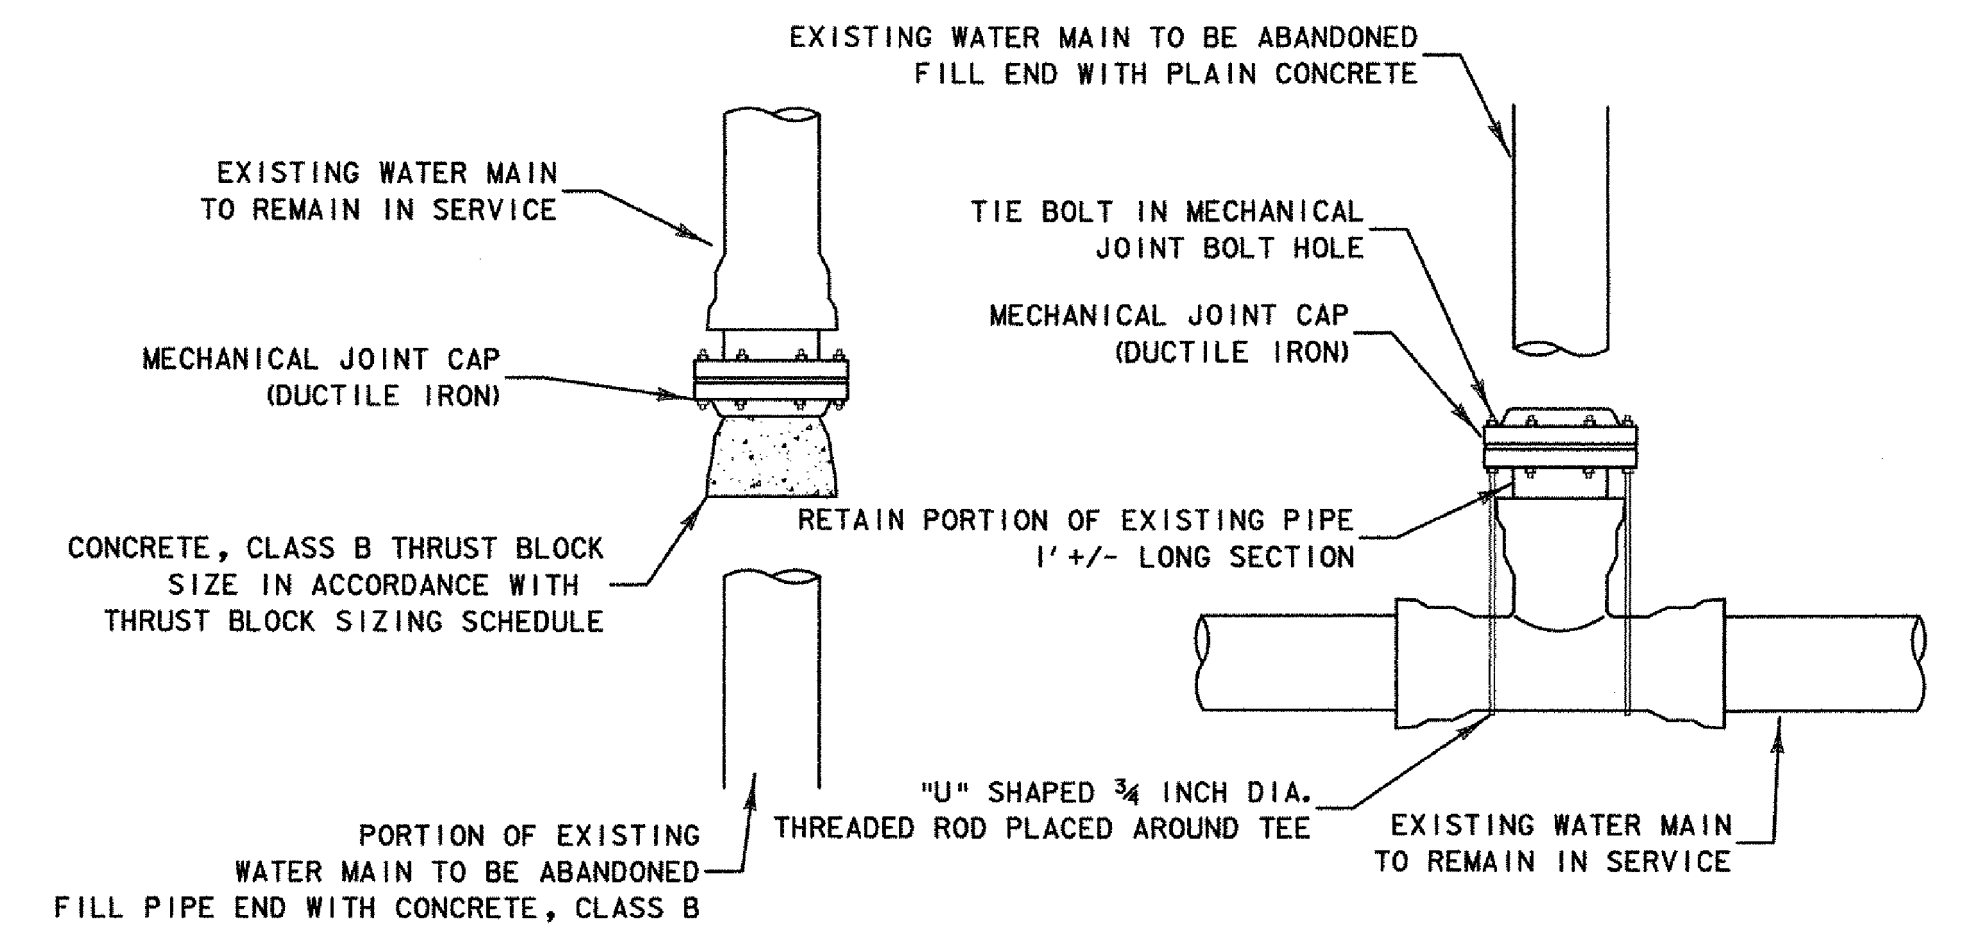

**TYPICAL WATER PIPE ABANDONMENT DETAIL**

NOT TO SCALE

<b>DATUM</b>	
VERTICAL	NGVD 1929
HORIZONTAL	N/A

PROJECT: <b>HARTFORD</b>	PROJECT NO.: <b>RS 0113(40)</b>
DESIGN FILE NAME: z86c027wtrd\ts.dgn	PLOT DATE: 1/10/2007
IPARM FILE NAME:	SURVEY DATE: 1/87
SURVEYED BY: FANTONI	DRAWN BY: E. ATKINS
SQUAD LEADER: KEN UPMAL	SHEET: 89 OF 239