


**SANITARY SEWER LAYOUT SHEET 1**

- NOTES:**
- STATION AND OFFSETS FOR ALL MANHOLES ARE GIVEN TO THE CENTER OF THE STRUCTURE. THE CONTRACTOR SHALL ROTATE THE TOP SECTIONS SUCH THAT THE FINAL LOCATION OF THE MANHOLE COVER IS NOT WITHIN THE PREDOMINANT VEHICLE WHEEL PATH.
  - SEE UTILITY CONSTRUCTION GENERAL NOTES SHEET FOR PROPOSED SEWER CONSTRUCTION NOTES.
  - REFER TO DRAINAGE AND WATER LAYOUT SHEETS FOR PROPOSED DRAINAGE AND WATER LAYOUT.
  - THE LOCATION OF EXISTING SEWER SERVICES SHOWN WERE PROVIDED BY THE TOWN OF HARTFORD BASED ON VIDEO INSPECTION. NOT ALL SERVICES SHOWN ARE ACTIVE. NEW CONNECTIONS TO INACTIVE SERVICES ARE NOT NEEDED. THE CONTRACTOR SHALL INSTALL NEW SERVICES AS DIRECTED BY THE ENGINEER.
  - THE LENGTH AND LOCATION OF THE NEW 6" PVC SEWER SERVICES SHALL BE DETERMINED IN FIELD AND/OR AS DIRECTED BY THE ENGINEER. SEE ALSO NOTE 1 OF THE PROPOSED SEWER CONSTRUCTION NOTES ON SHEET 77 OF 239.
  - ALL EXISTING INVERTS SHOWN ON THIS PLAN WERE PROVIDED BY VTRANS BASED ON FIELD MEASUREMENTS.
  - THE CONTRACTOR SHALL PROVIDE THE NECESSARY LATERAL SUPPORT FOR THE STRUCTURE (MHS A13) DURING EXCAVATION AND THE INSTALLATION OF THE NEW 8" SEWER PIPE.

**DATUM**

VERTICAL	NGVD 1929
HORIZONTAL	N/A

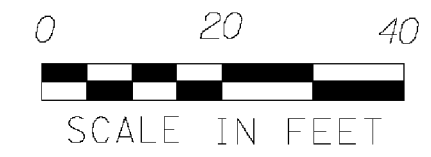

ADDENDUM #2: REVISED JUNE 5, 2008

PROJECT: <b>HARTFORD</b>	PROJECT NO. : <b>RS 0113(40)</b>
DESIGN FILE NAME: z86c027sewldr.DGN	PLOT DATE: 4/17/2012
IPARM FILE NAME:	SURVEY DATE: 1/87
SURVEYED BY: FANTONI	DRAWN BY: E. ATKINS
SQUAD LEADER: KEN UPMAL	SHEET: 101 OF 239