

STONE FILL, TYPE I (MOD. - INLET PROTECTION)

EXIST. DI @ 41+16.4 RT
 EXIST. DI @ 41+20.3 RT
 EXIST. DI @ 41+68.0 RT
 PROP. CB @ 43+50.0 RT

GEOTEXTILE FABRIC FOR FILTERS

PROP. CB @ 40+10.0 RT (9 S.F. INLET PROTECTION)
 PROP. CB @ 40+10.0 LT (9 S.F. INLET PROTECTION)
 EXIST. DI @ 40+13.0 LT (9 S.F. INLET PROTECTION)
 EXIST. DI @ 42+05.7 LT (9 S.F. INLET PROTECTION)
 EXIST. DI @ 42+57.8 LT (9 S.F. INLET PROTECTION)
 PROP. CB @ 43+50.0 RT (9 S.F. INLET PROTECTION)
 PROP. CB @ 43+50.0 LT (9 S.F. INLET PROTECTION)
 PROP. CB @ 43+55.0 LT (9 S.F. INLET PROTECTION)
 EXIST. DI @ 43+56.0 LT (9 S.F. INLET PROTECTION)
 PROP. CB @ 44+00.0 RT (9 S.F. INLET PROTECTION)
 PROP. CB @ 44+00.0 LT (9 S.F. INLET PROTECTION)
 EXIST. DI @ 44+67.7 LT (9 S.F. INLET PROTECTION)
 EXIST. DI @ 44+79.0 LT (9 S.F. INLET PROTECTION)
 PROP. CB @ 25+44.1 LT (SAUNDERS AVE) (9 S.F. INLET PROTECTION)
 PROP. CB @ 25+45.7 LT (SAUNDERS AVE) (9 S.F. INLET PROTECTION)

GEOTEXTILE FOR SILT FENCE

40+00 ~ 40+67 LT
 41+62 ~ 43+25 RT
 44+54 ~ 45+00 RT

SEED

40+00 ~ 45+00 RT
 40+00 ~ 45+00 LT

SEED ~ WINTER RYE



40+00 ~ 45+00 RT
 40+00 ~ 45+00 LT

HAY MULCH

40+00 ~ 45+00 RT
 40+00 ~ 45+00 LT


EROSION MATTING

40+00 ~ 40+25 RT
 40+00 ~ 41+00 LT

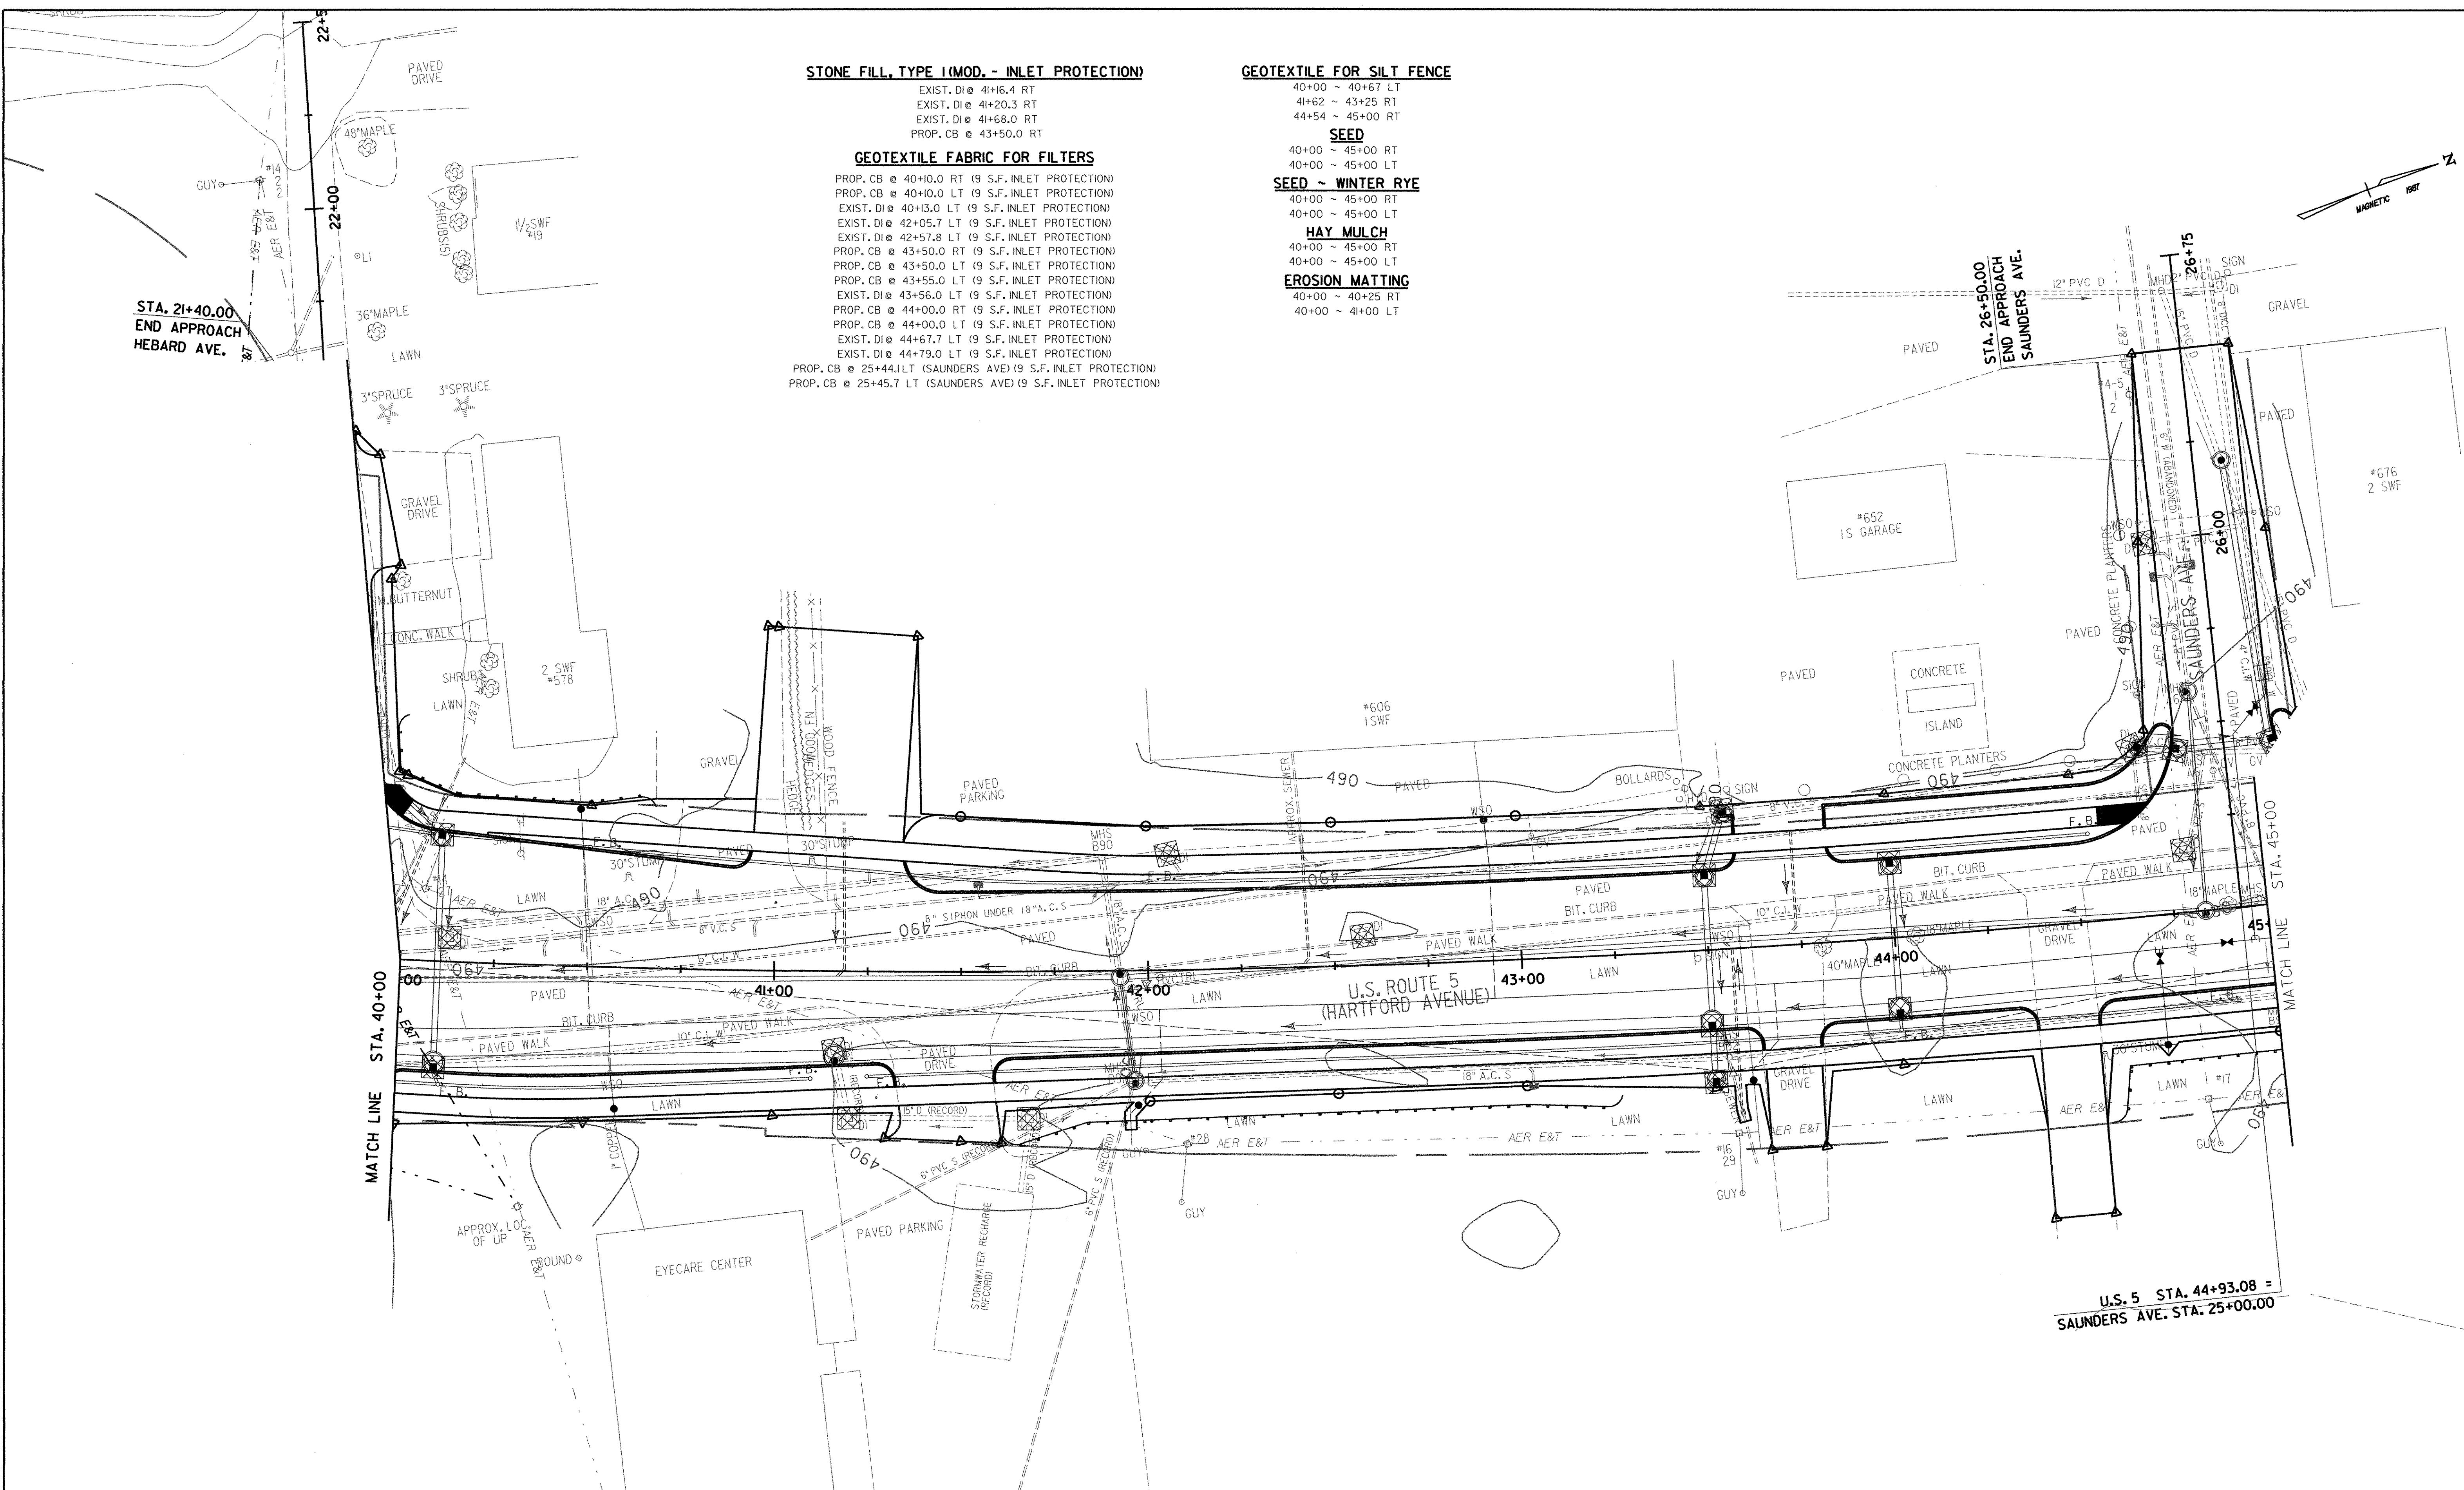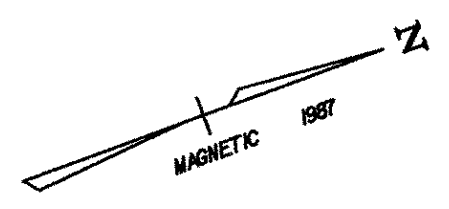

EROSION CONTROL LEGEND			
	INLET PROTECTION (SEE DETAIL SHEETS FOR APPROPRIATE METHOD)		STABILIZED CONST. ENTRANCE
	TEMPORARY STONE CHECK DAM		SILT FENCE
	STONE DITCH		PROJECT DEMARCATION FENCING (LIMIT OF DISTURBANCE)
			FILTER CURTAIN

DATUM
 VERTICAL NGVD 1929
 HORIZONTAL N/A

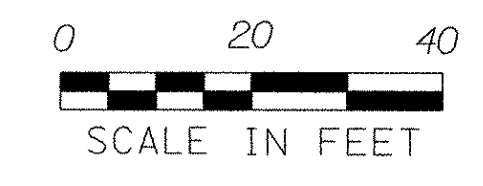

PROJECT: HARTFORD	PROJECT NO. : RS 0113(40)
DESIGN FILE NAME: z86c027erosbdr.DGN	PLOT DATE: 1/31/2007
IPARM FILE NAME:	SURVEY DATE: 1/87
SURVEYED BY: FANTONI	DRAWN BY: E. ATKINS
SQUAD LEADER: KEN UPMAL	SHEET: 138 OF 239