


**PLAN VIEW - GROUND ANCHORED SOLDIER PILE WALL**

NOTE: PROPOSED WATER AND SEWER LAYOUT NOT SHOWN.



SEE VALUE ENGINEERING RETAINING WALL

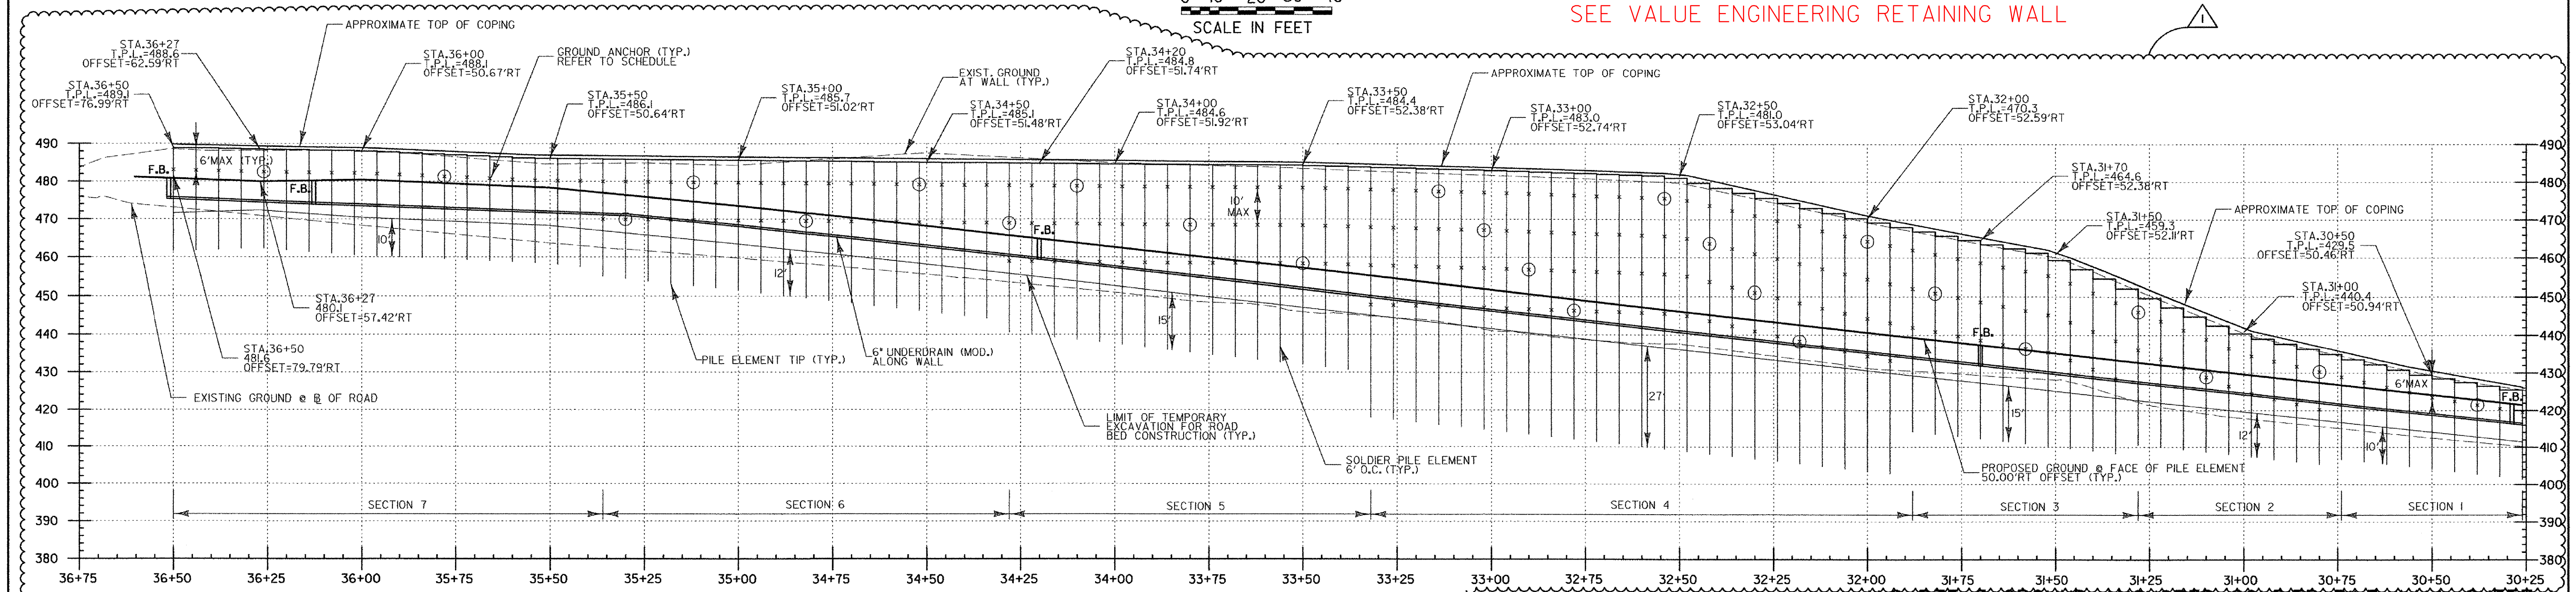

**WALL PROFILE**

SCALE: 1"=20' HORIZ.  
1"=20' VERT.

**DATUM**  
VERTICAL NGVD 1929  
HORIZONTAL N/A

- LEGEND:**
- ⊙ - INDICATES LOCATION OF PERFORMANCE ANCHOR TEST
  - ⊕ - PREPRODUCTION ANCHOR TESTING LOCATION
  - T.P.L. - TOP OF PILE/LAGGING
  - NOTE: ALL WALL OFFSETS ARE MEASURED FROM ROADWAY CENTERLINE TO FACE OF PILE ELEMENT.

U.S. RTE. 5 GROUND ANCHORED SOLDIER PILE WALL SHEET 1

PROJECT: <b>HARTFORD</b>	PROJECT NO.: <b>RS 0113(40)</b>
DESIGN FILE NAME: z86c027walldef.dgn	PLOT DATE: 4/18/2007
IPARM FILE NAME:	SURVEY DATE: 1/87
SURVEYED BY: FANTONI	DRAWN BY: E. ATKINS
SQUAD LEADER: KEN UPMAL	SHEET: 143 OF 239

ADDENDUM #1 REVISED APRIL 18, 2007