


WALL PLAN

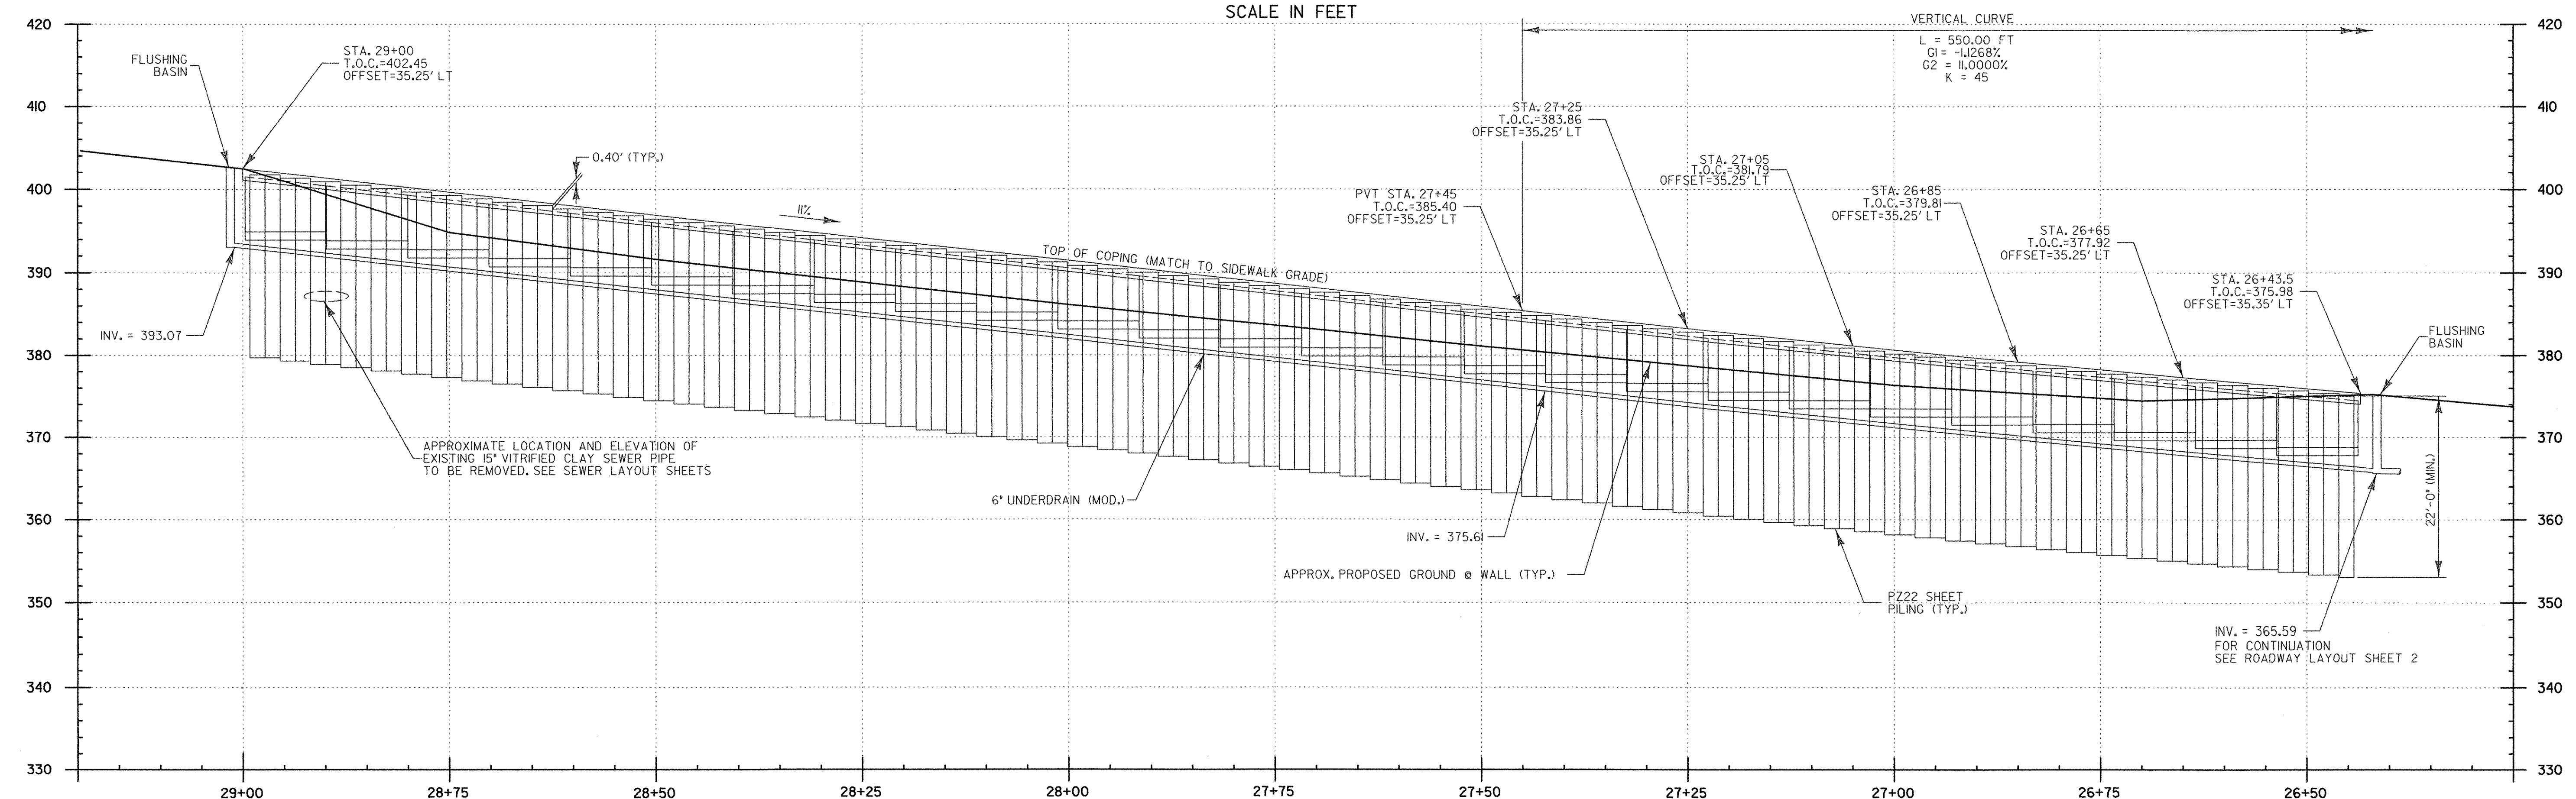

WALL PROFILE

SCALE: 1"=10' HORIZ.
1"=10' VERT.

BARNES AVENUE SHEET PILE RETAINING WALL SHEET 1

DATUM

VERTICAL	NGVD 1929
HORIZONTAL	N/A

SEE BARNES AVENUE SHEET PILE RETAINING WALL SHEET 2
SEE ROADWAY LAYOUT SHEETS
SEE CROSS SECTIONS

PROJECT: HARTFORD	PROJECT NO. : RS 0113(40)
DESIGN FILE NAME: z86c027walldet.dgn	PLOT DATE: 2/27/2007
IPARM FILE NAME:	SURVEY DATE: 1/87
SURVEYED BY: FANTONI	DRAWN BY: E. ATKINS
SQUAD LEADER: KEN UPMAL	SHEET: 146 OF 239