

DURABLE 4" WHITE LINE
 30+00 ~ 35+00 EDGE LINE SOLID (25' LT)
 30+00 ~ 35+00 LANE LINE DASHED (14' LT)
 30+00 ~ 35+00 LANE LINE DASHED (14' RT)
 30+00 ~ 35+00 EDGE LINE SOLID (25' RT)

TEMPORARY 4" WHITE LINE
 (SAME AS DURABLE)

REMOVING SIGNS
 4 EACH



TEMPORARY 4" YELLOW LINE
 (SAME AS DURABLE)

ERECTING SALVAGED SIGNS
 1 EACH

DURABLE 4" YELLOW LINE
 30+00 ~ 35+00 EDGE LINE SOLID (3' LT)
 30+00 ~ 35+00 EDGE LINE SOLID (3' RT)

TEMPORARY LETTER OR SYMBOL
 (SAME AS DURABLE)


DURABLE LETTER OR SYMBOL
 34+95 ~ 35+00 RT SCHOOL 16 EACH

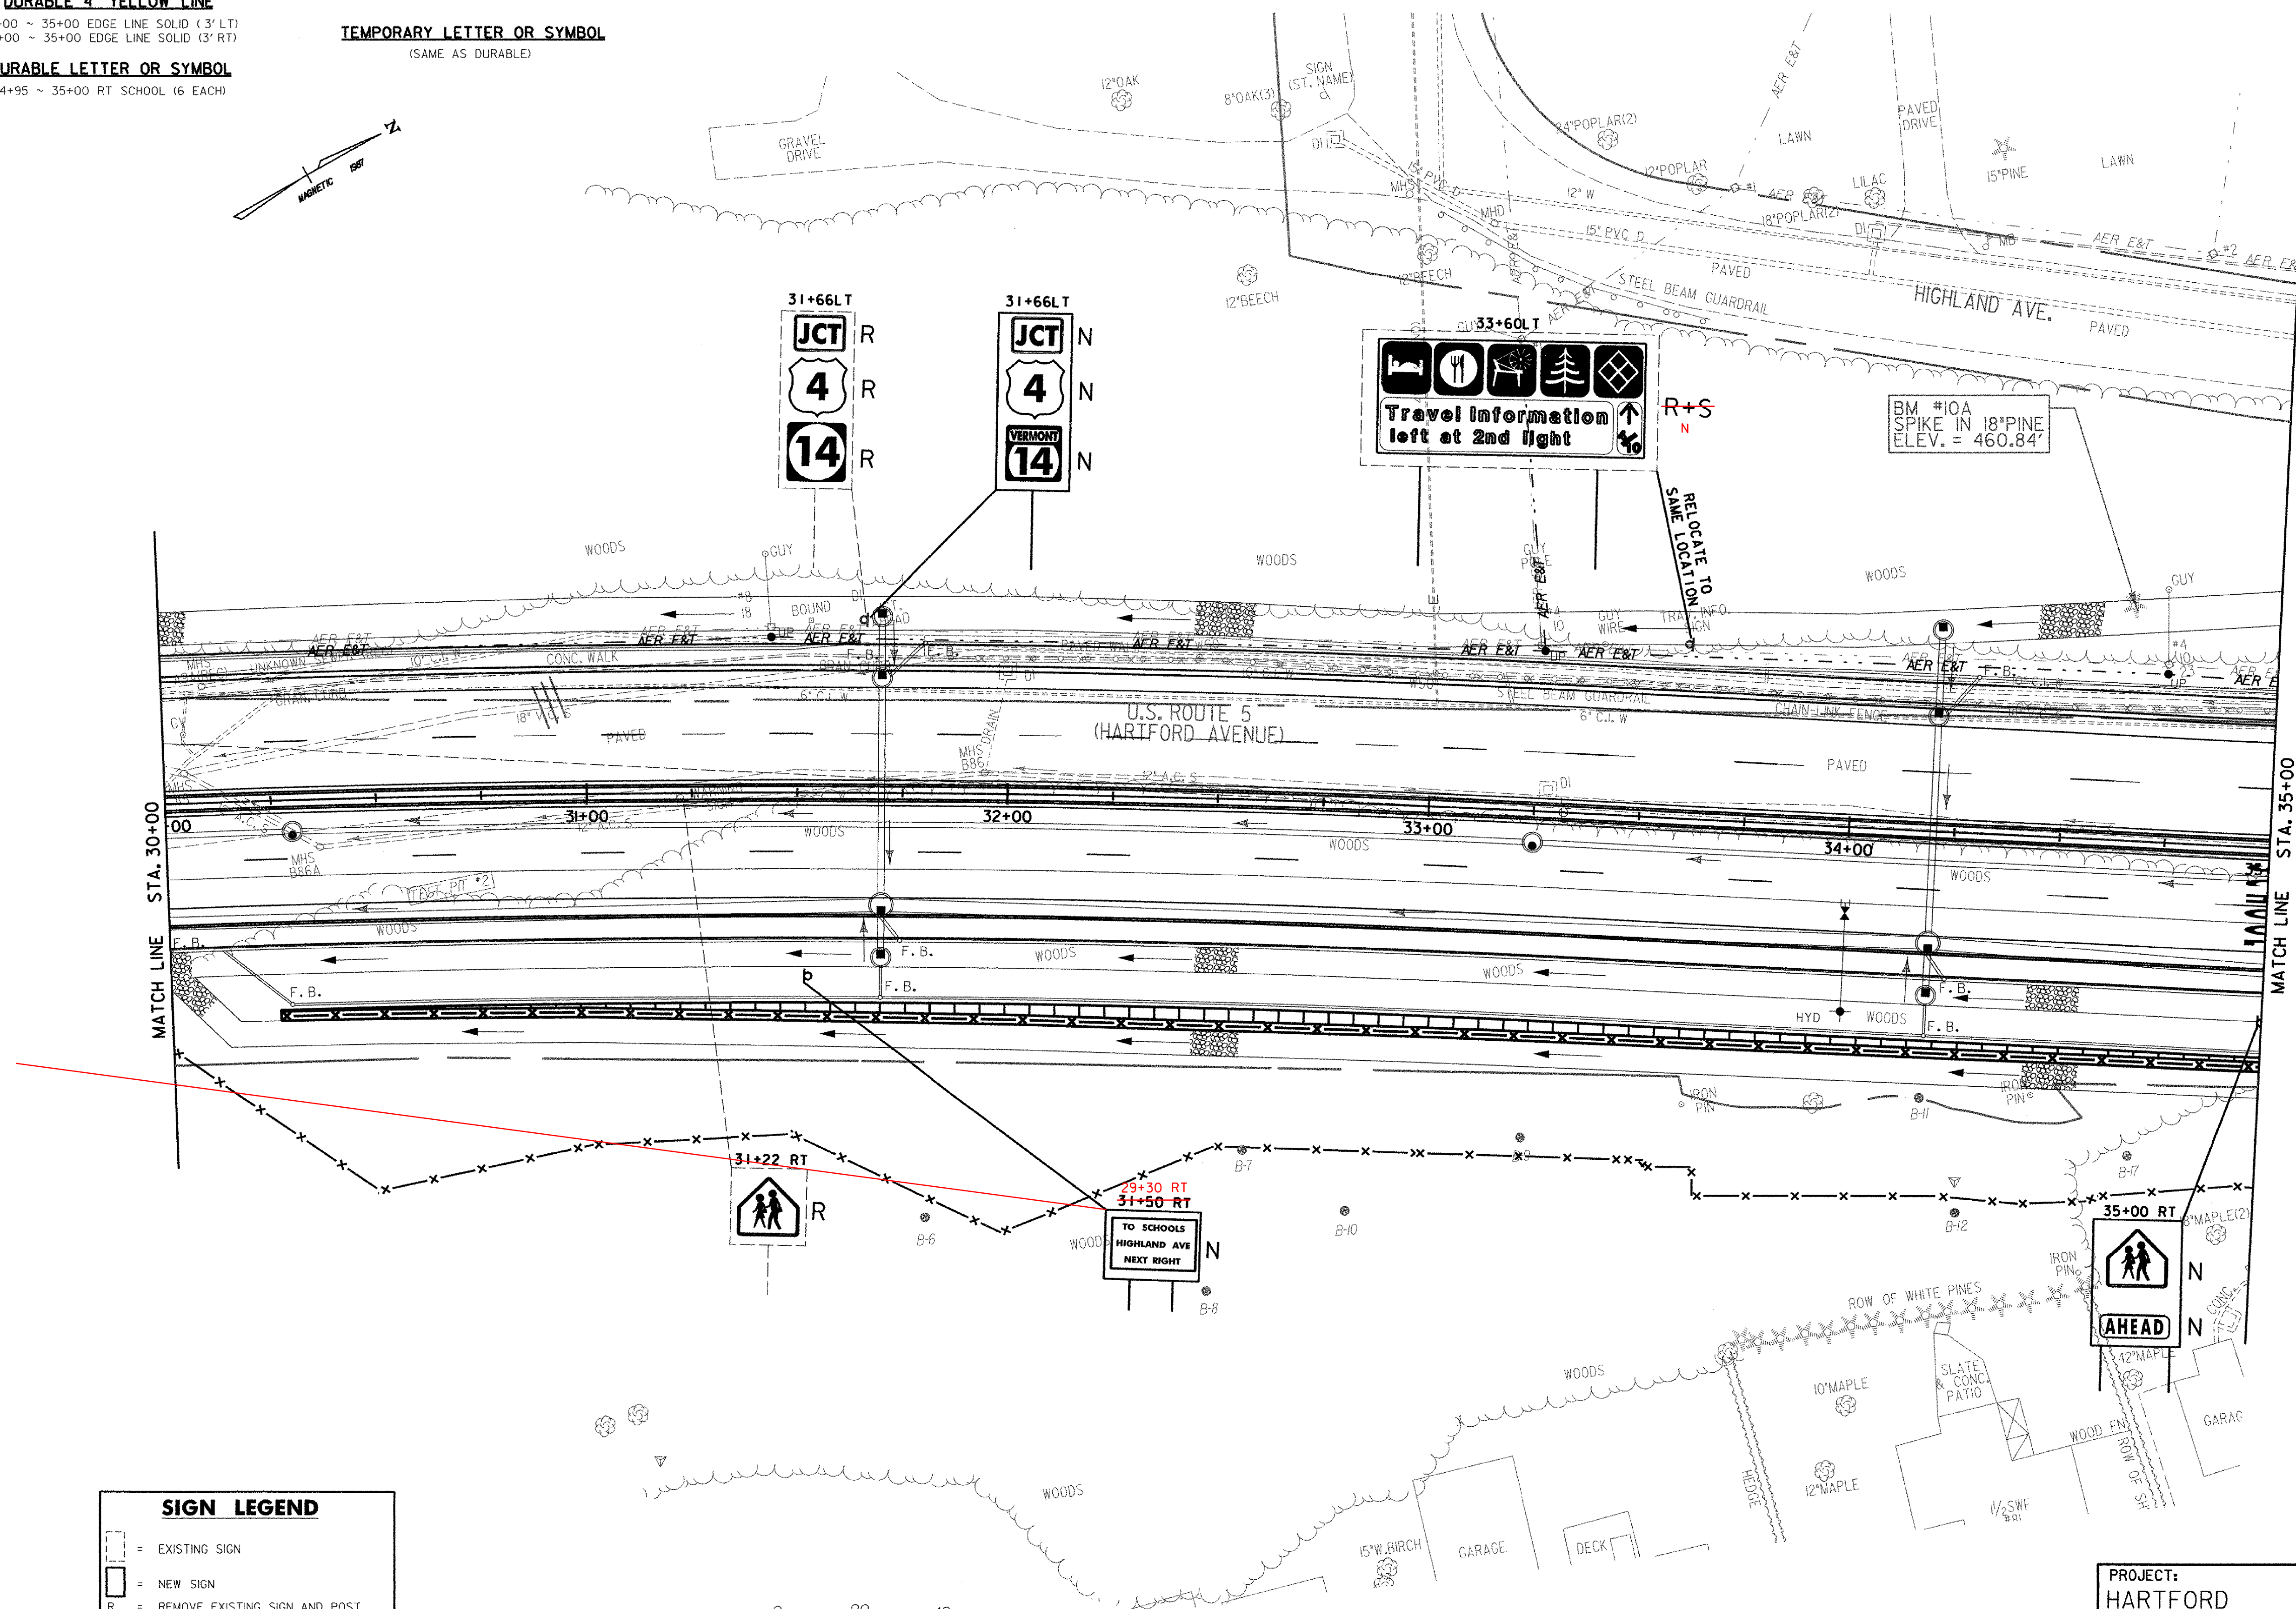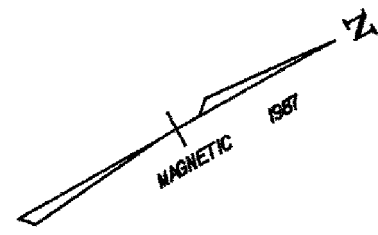

MATCH LINE STA. 30+00

MATCH LINE STA. 35+00

SIGN LEGEND	
	= EXISTING SIGN
	= NEW SIGN
R	= REMOVE EXISTING SIGN AND POST
R+S	= SALVAGE SIGN AND RELOCATE TO NOTED LOCATION WITH NEW SIGN POST. REMOVE AND DISPOSE EXISTING SIGN POST
N	= NEW
RET	= RETAIN AT EXISTING LOCATION
B-B	= BACK TO BACK

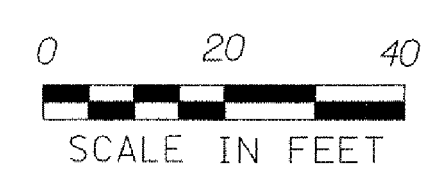

NOTE: ALL NEW SIGNS SHALL USE TYPE III HIGH INTENSITY REFLECTIVE SHEETING

DATUM
 VERTICAL NGVD 1929
 HORIZONTAL N/A

PROJECT: HARTFORD	PROJECT NO.: RS 0113(40)
DESIGN FILE NAME: z027bdr.dgn	PLOT DATE: 2/27/2007
IPARM FILE NAME:	SURVEY DATE: 1/87
SURVEYED BY: FANTONI	DRAWN BY: E. ATKINS
SQUAD LEADER: KEN UPMAL	SHEET: 159 OF 239

**PVMT MARKINGS AND SIGNS
LAYOUT SHEET 3**