

DURABLE 4" WHITE LINE
 55+00 ~ 58+10 EDGE LINE SOLID (17' LT)
 58+10 ~ 58+30 LT EDGE LINE SOLID (RADIUS)
 58+52 ~ 58+75 LT EDGE LINE SOLID (RADIUS)
 58+75 ~ 60+00 EDGE LINE SOLID (17' LT)
 58+59 ~ 59+20 LANE LINE SOLID (6' LT)
 55+04 ~ 55+20 RT EDGE LINE SOLID (RADIUS)
 55+20 ~ 57+80 EDGE LINE SOLID (17' RT)
 57+15 ~ 57+98 LANE LINE SOLID (16' RT)
 57+80 ~ 57+99 RT EDGE LINE SOLID (RADIUS)
 58+26 ~ 58+44 RT EDGE LINE SOLID (RADIUS)
 58+44 ~ 60+00 EDGE LINE SOLID (17' RT)

DURABLE 4" YELLOW LINE
 55+08 ~ 57+15 LANE LINES SOLID & DASHED (6' LT)
 57+15 ~ 57+98 DOUBLE LINE SOLID (6' LT)
 55+08 ~ 56+55 LANE LINES SOLID & DASHED (6' RT)
 58+60 ~ 60+00 DOUBLE LINE SOLID (6' RT)

DURABLE 24" STOP BAR
 45+38 LT - 9' (ADVENT LN)
 50+35 LT - 13' (HEWITT ST)

DURABLE LETTER OR SYMBOL
 55+00 ~ 56+00 ARROWS (2 EACH)
 57+15 ~ 57+23 LT&RT ARROW (1 EACH)
 57+50 ~ 57+58 LT&RT ONLY (4 EACH)
 57+85 ~ 57+93 LT&RT ARROWS (1 EACH)
 58+63 ~ 58+71 LT&RT ARROWS (1 EACH)
 58+88 ~ 58+94 LT&RT ONLY (4 EACH)
 59+12 ~ 59+20 LT&RT ARROWS (1 EACH)
 45+43 ~ 45+51 LT STOP (4 EACH) (ADVENT LN)
 50+40 ~ 50+48 LT STOP (4 EACH) (HEWITT ST)

DURABLE CROSSWALK W/ DIAGONAL LINES (MOD. - BLOCK TYPE)
 45+30 LT ~ 45+35 RT - 26 LF (ADVENT LN)

TEMPORARY 4" WHITE LINE
 (SAME AS DURABLE)

TEMPORARY 4" YELLOW LINE
 (SAME AS DURABLE)



TEMPORARY 24" STOP BAR
 (SAME AS DURABLE)

TEMPORARY LETTERS OR SYMBOLS
 (SAME AS DURABLE)

TEMPORARY CROSSWALK W/ DIAGONAL LINES (MOD. - BLOCK TYPE)
 (SAME AS DURABLE)

REMOVING SIGNS
 8 EACH

ERECTING SALVAGED SIGNS
 3 EACH

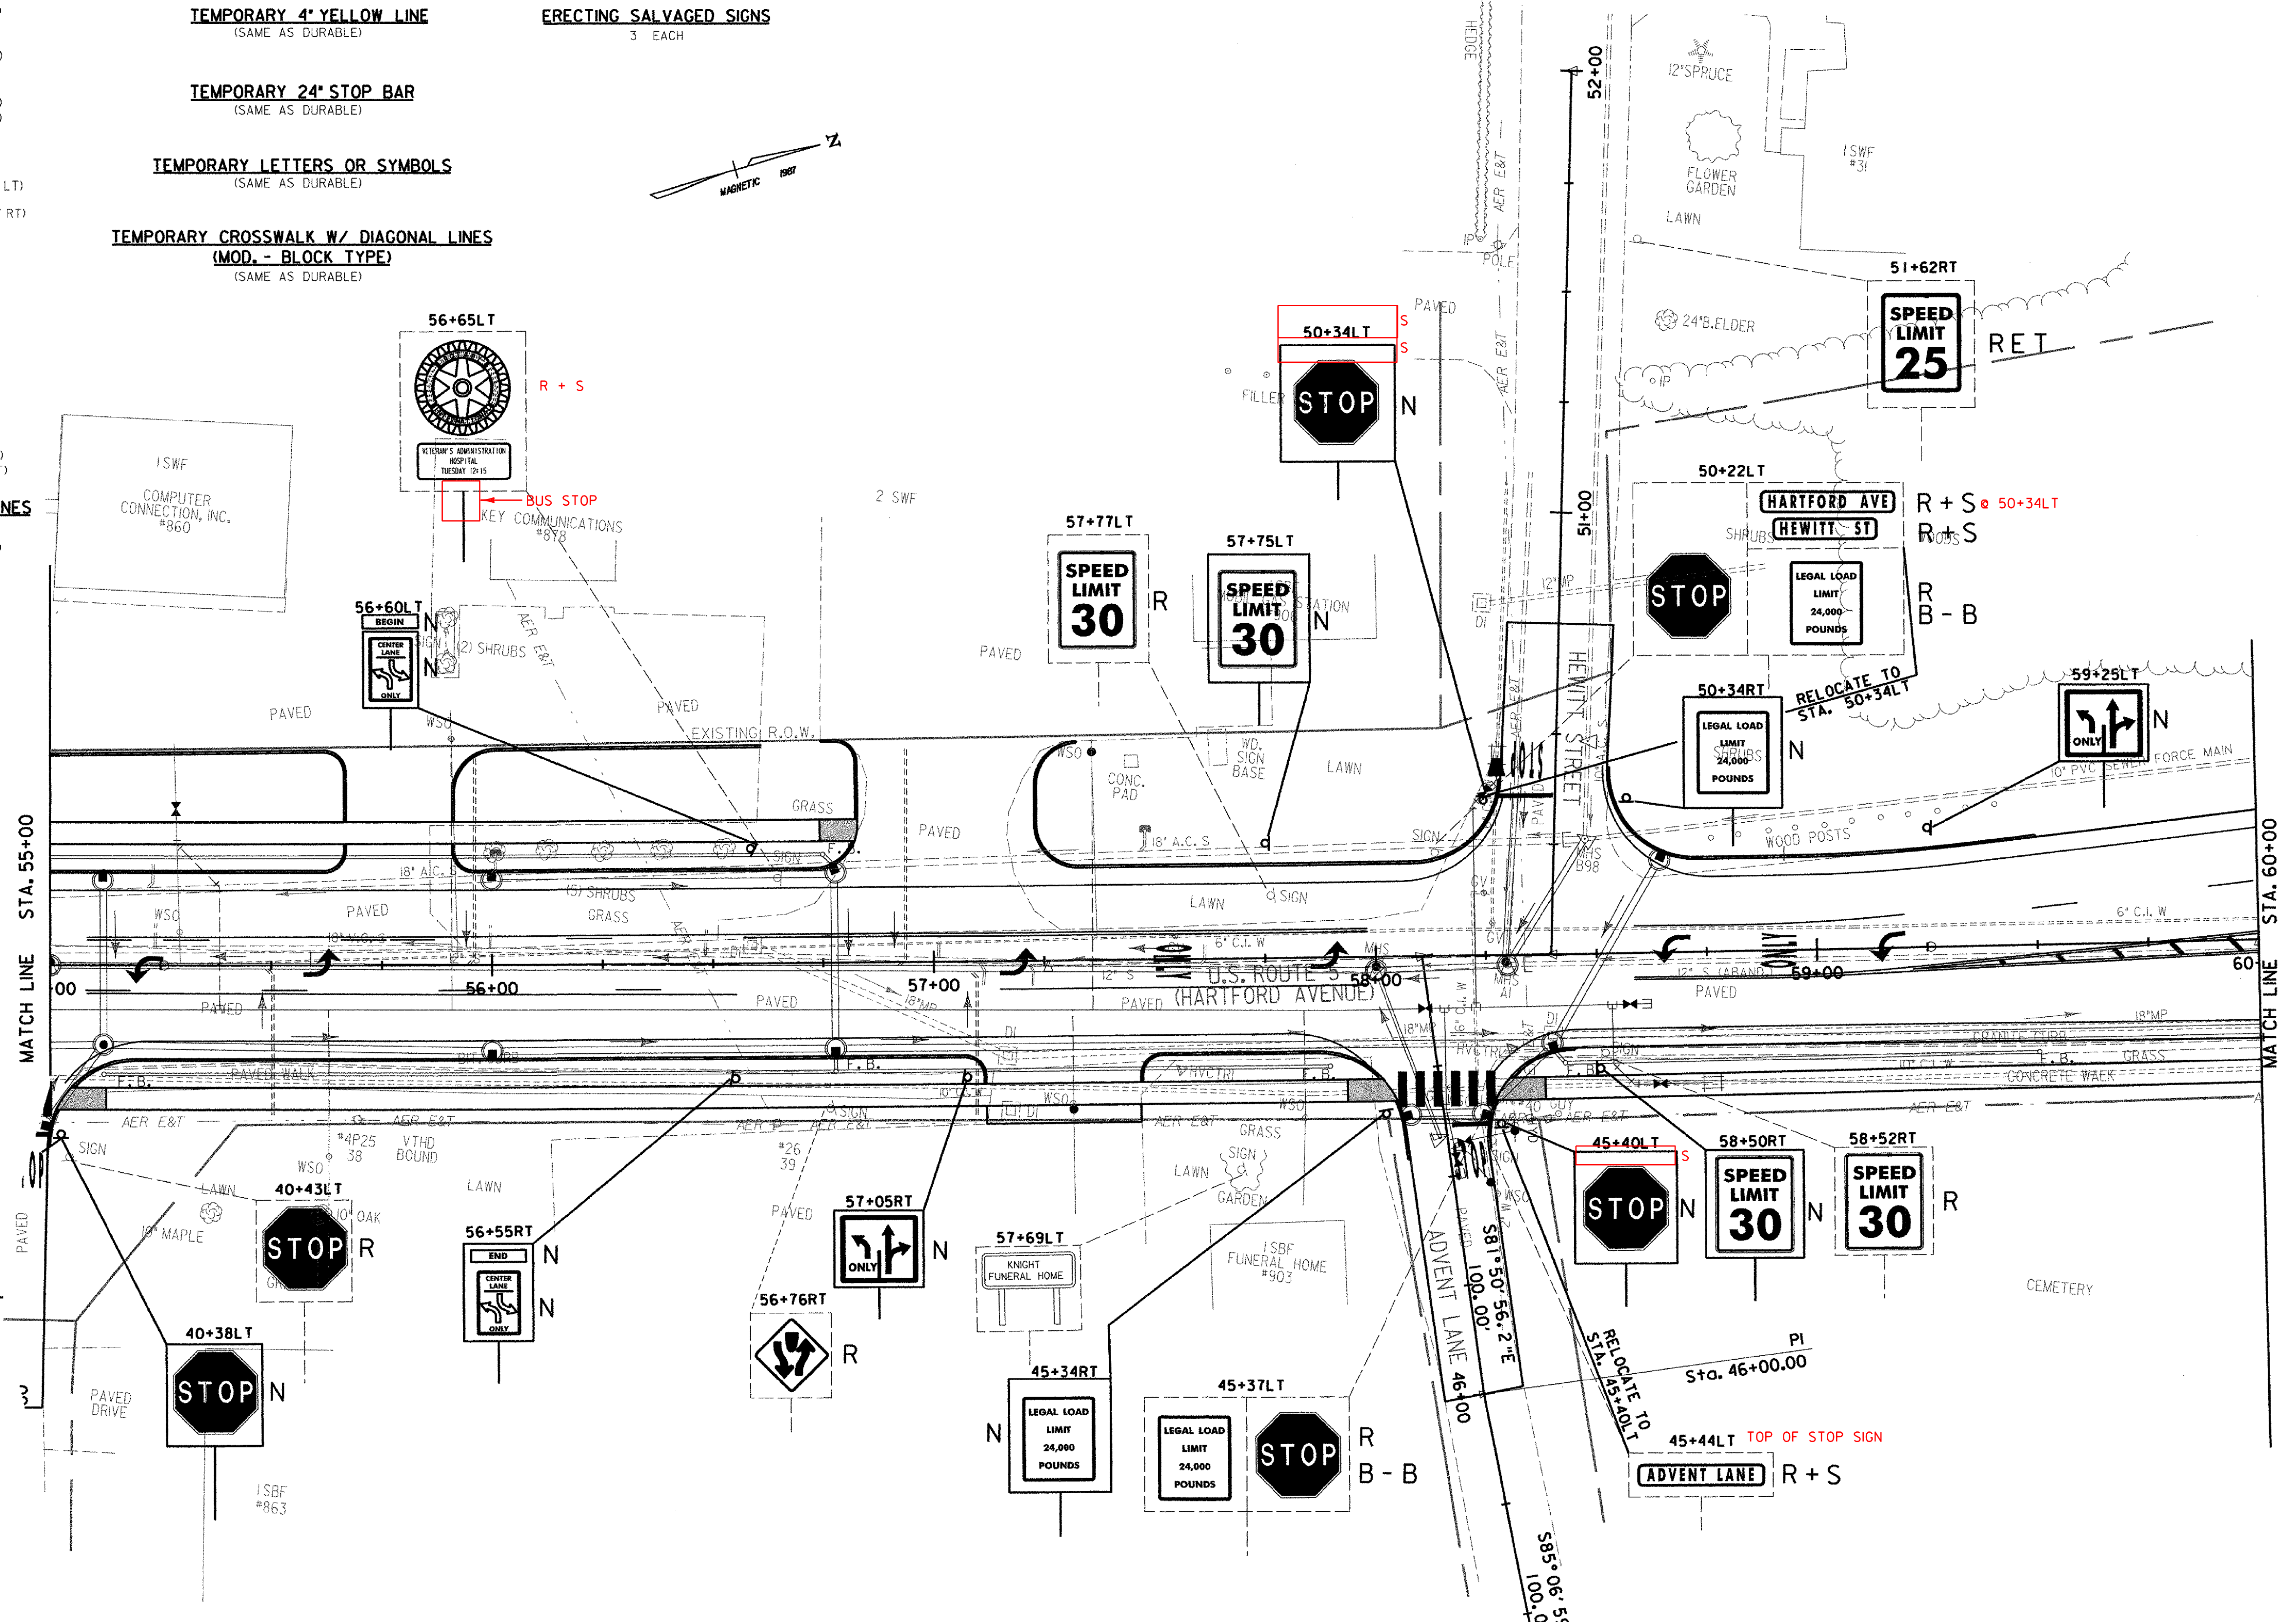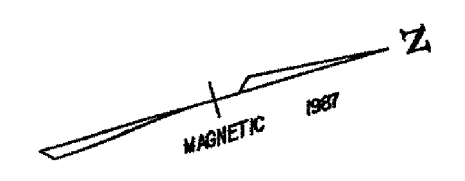

SIGN LEGEND

	= EXISTING SIGN
	= NEW SIGN
R	= REMOVE EXISTING SIGN AND POST
R+S	= SALVAGE SIGN AND RELOCATE TO NOTED LOCATION WITH NEW SIGN POST, REMOVE AND DISPOSE EXISTING SIGN POST
N	= NEW
RET	= RETAIN AT EXISTING LOCATION
B-B	= BACK TO BACK



NOTE: ALL NEW SIGNS SHALL USE TYPE III HIGH INTENSITY REFLECTIVE SHEETING

DATUM
 VERTICAL NGVD 1929
 HORIZONTAL N/A

PROJECT: HARTFORD	PROJECT NO.: RS 0113(40)
DESIGN FILE NAME: z027bdr.dgn	PLOT DATE: 1/10/2007
IPARM FILE NAME:	SURVEY DATE: 1/87
SURVEYED BY: FANTONI	DRAWN BY: E. ATKINS
SQUAD LEADER: KEN UPMAL	SHEET: 164 OF 239

PVMT MARKINGS AND SIGNS LAYOUT SHEET 8