

DURABLE 4" WHITE LINE
 60+00 ~ 61+00 EDGE LINE SOLID (17' - 32' LT) - MATCH TO EXISTING
 60+00 ~ 61+00 LANE LINE DASHED (10' - 20' LT) - MATCH TO EXISTING
 60+00 ~ 61+00 EDGE LINE SOLID (17' - 22' RT) - MATCH TO EXISTING

DURABLE 4" YELLOW LINE
 60+00 RT ~ 61+00 LT DOUBLE LINE SOLID - MATCH TO EXISTING
 60+00 ~ 61+00 RT DOUBLE LINE SOLID - MATCH TO EXISTING


DURABLE 8" YELLOW LINE
 60+00 ~ 61+00 (GORE MARKINGS) - MATCH TO EXISTING

TEMPORARY 4" WHITE LINE
 (SAME AS DURABLE)

TEMPORARY 4" YELLOW LINE
 (SAME AS DURABLE)

TEMPORARY 8" YELLOW LINE
 (SAME AS DURABLE)


TEMPORARY LETTERS OR SYMBOLS
 (SAME AS DURABLE)

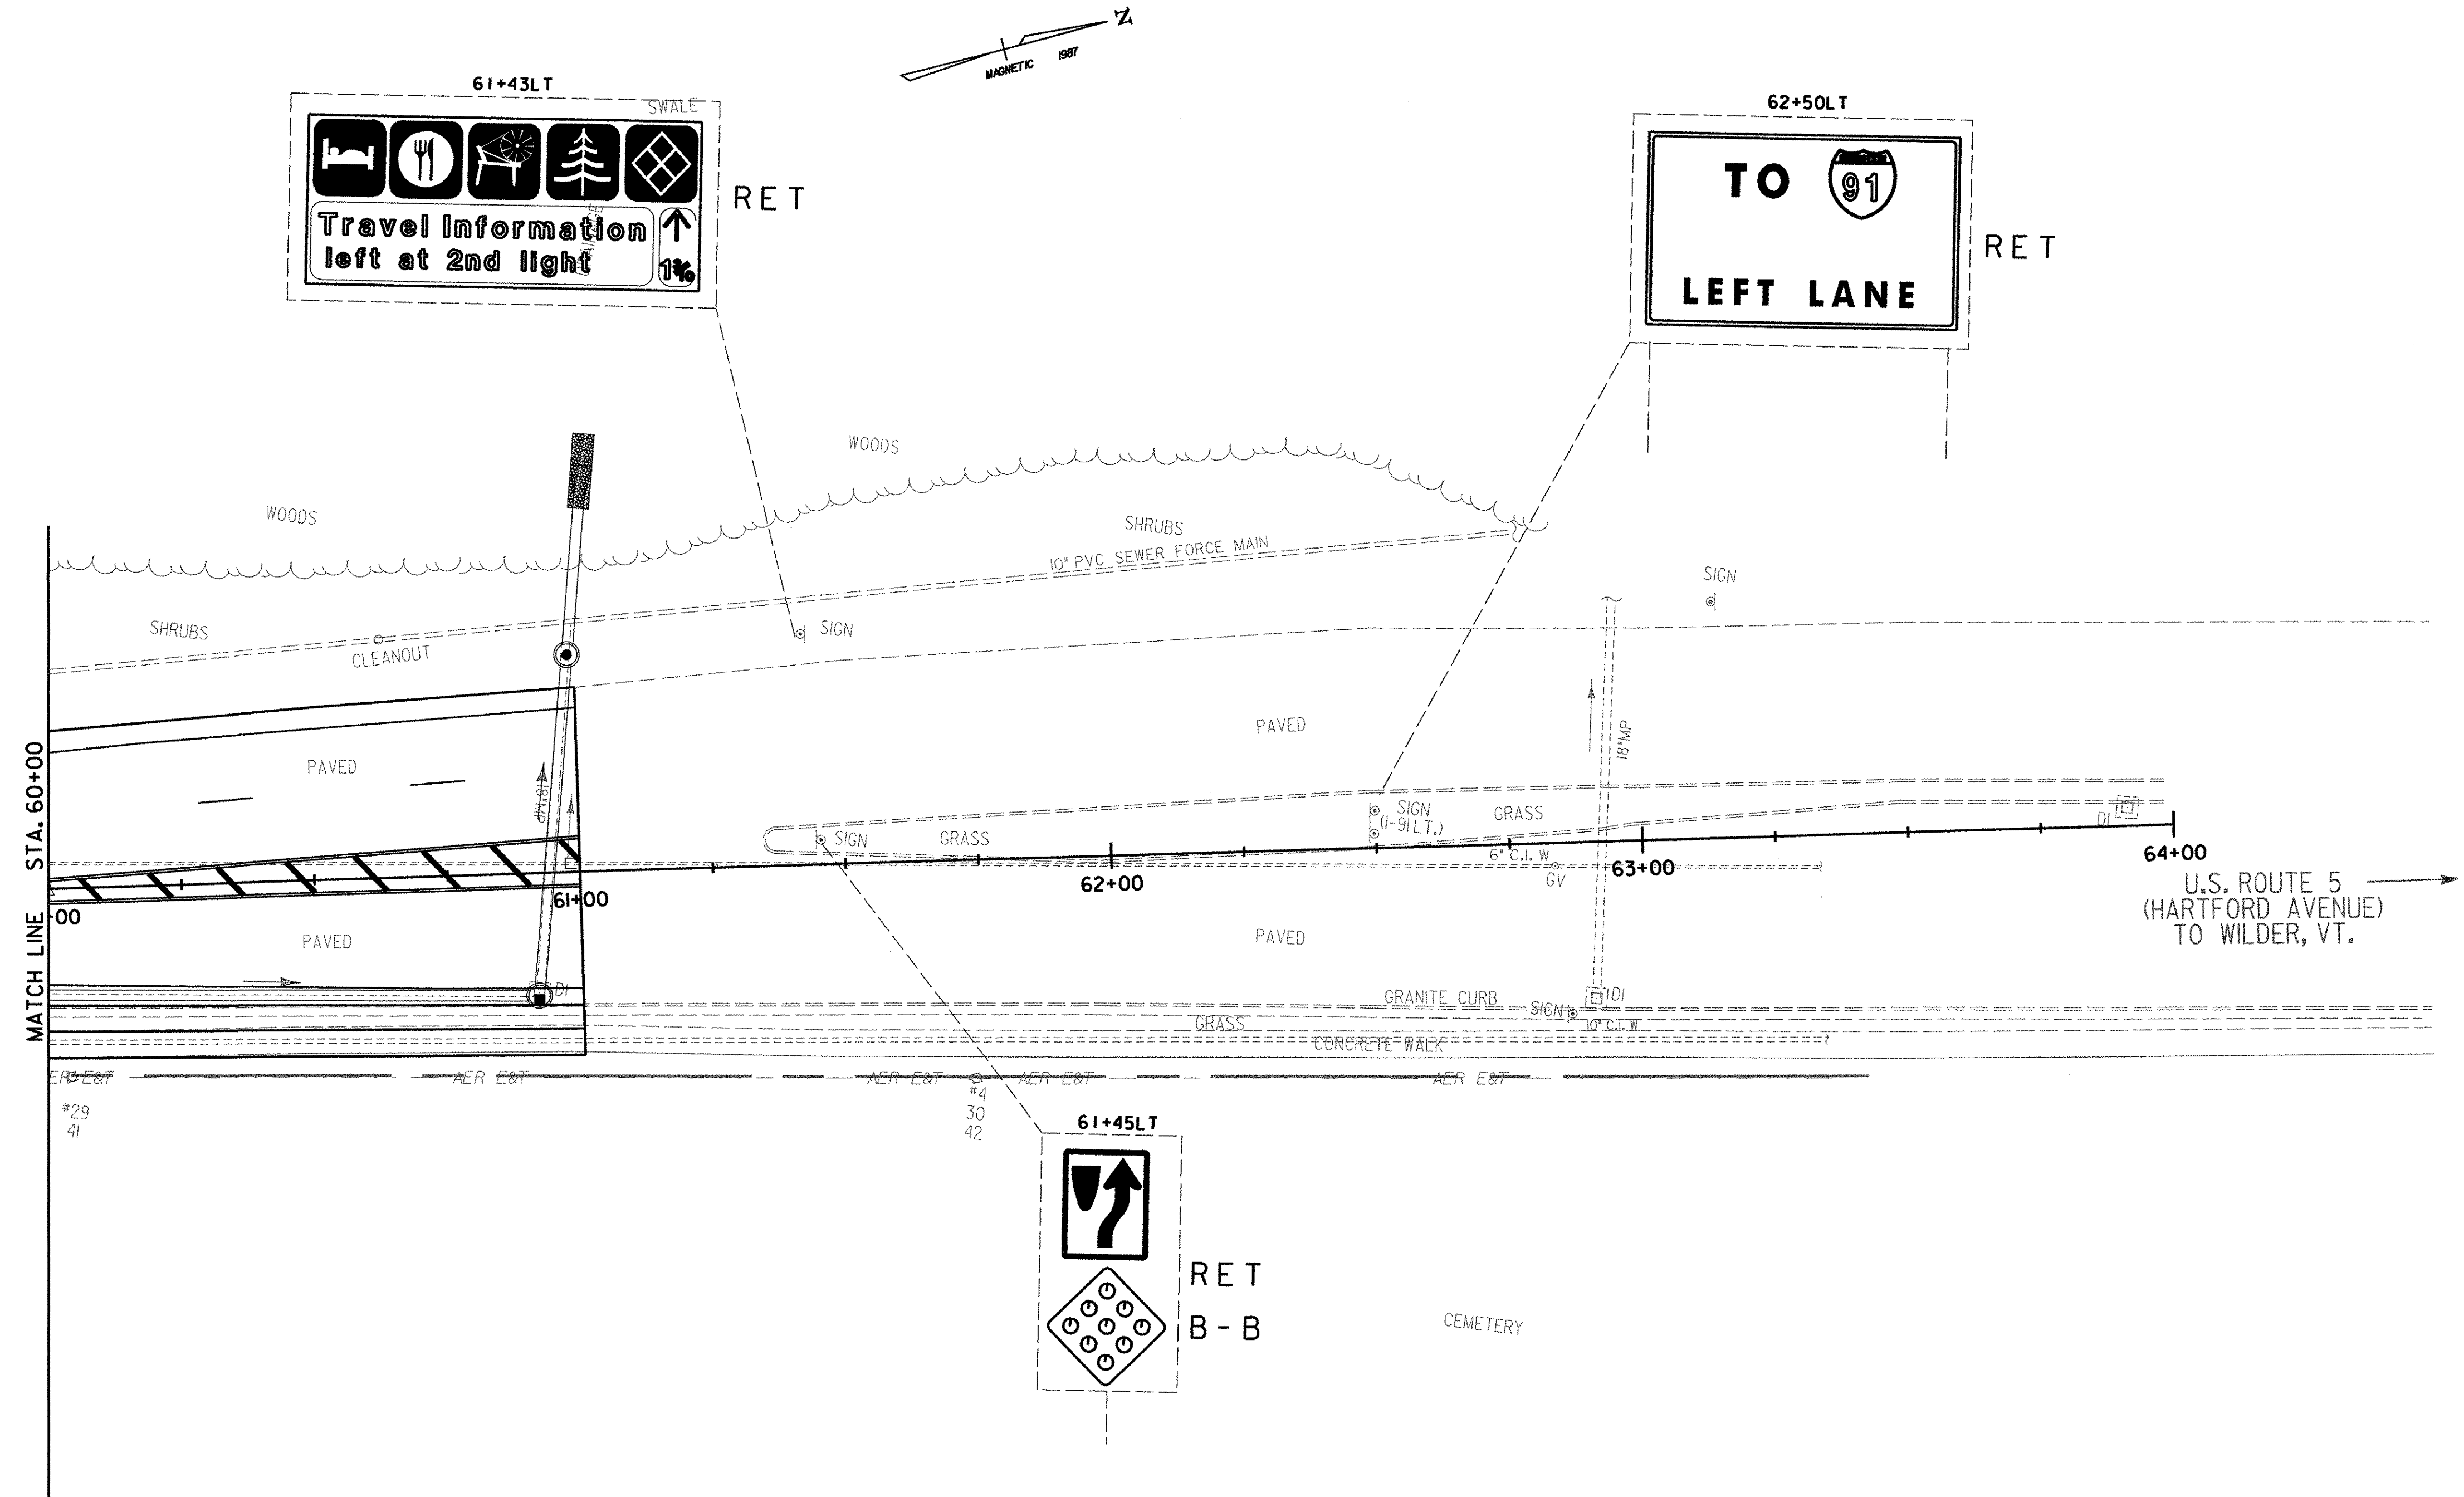

**PVMT MARKINGS AND SIGNS
 LAYOUT SHEET 9**

SIGN LEGEND	
	= EXISTING SIGN
	= NEW SIGN
R	= REMOVE EXISTING SIGN AND POST
R+S	= SALVAGE SIGN AND RELOCATE TO NOTED LOCATION WITH NEW SIGN POST. REMOVE AND DISPOSE EXISTING SIGN POST
N	= NEW
RET	= RETAIN AT EXISTING LOCATION
B-B	= BACK TO BACK

DATUM
 VERTICAL NGVD 1929
 HORIZONTAL N/A

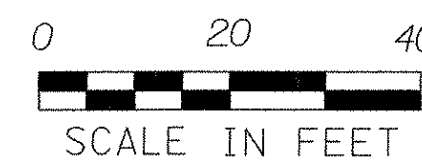

NOTE: ALL NEW SIGNS SHALL USE TYPE III HIGH INTENSITY REFLECTIVE SHEETING

PROJECT: HARTFORD	PROJECT NO. : RS 0113(40)
DESIGN FILE NAME: z027bdr.dgn	PLOT DATE: 1/10/2007
IPARM FILE NAME:	SURVEY DATE: 1/87
SURVEYED BY: FANTONI	DRAWN BY: E. ATKINS
SQUAD LEADER: KEN UPMAL	SHEET: 165 OF 239