


LANDSCAPING LAYOUT SHEET 1

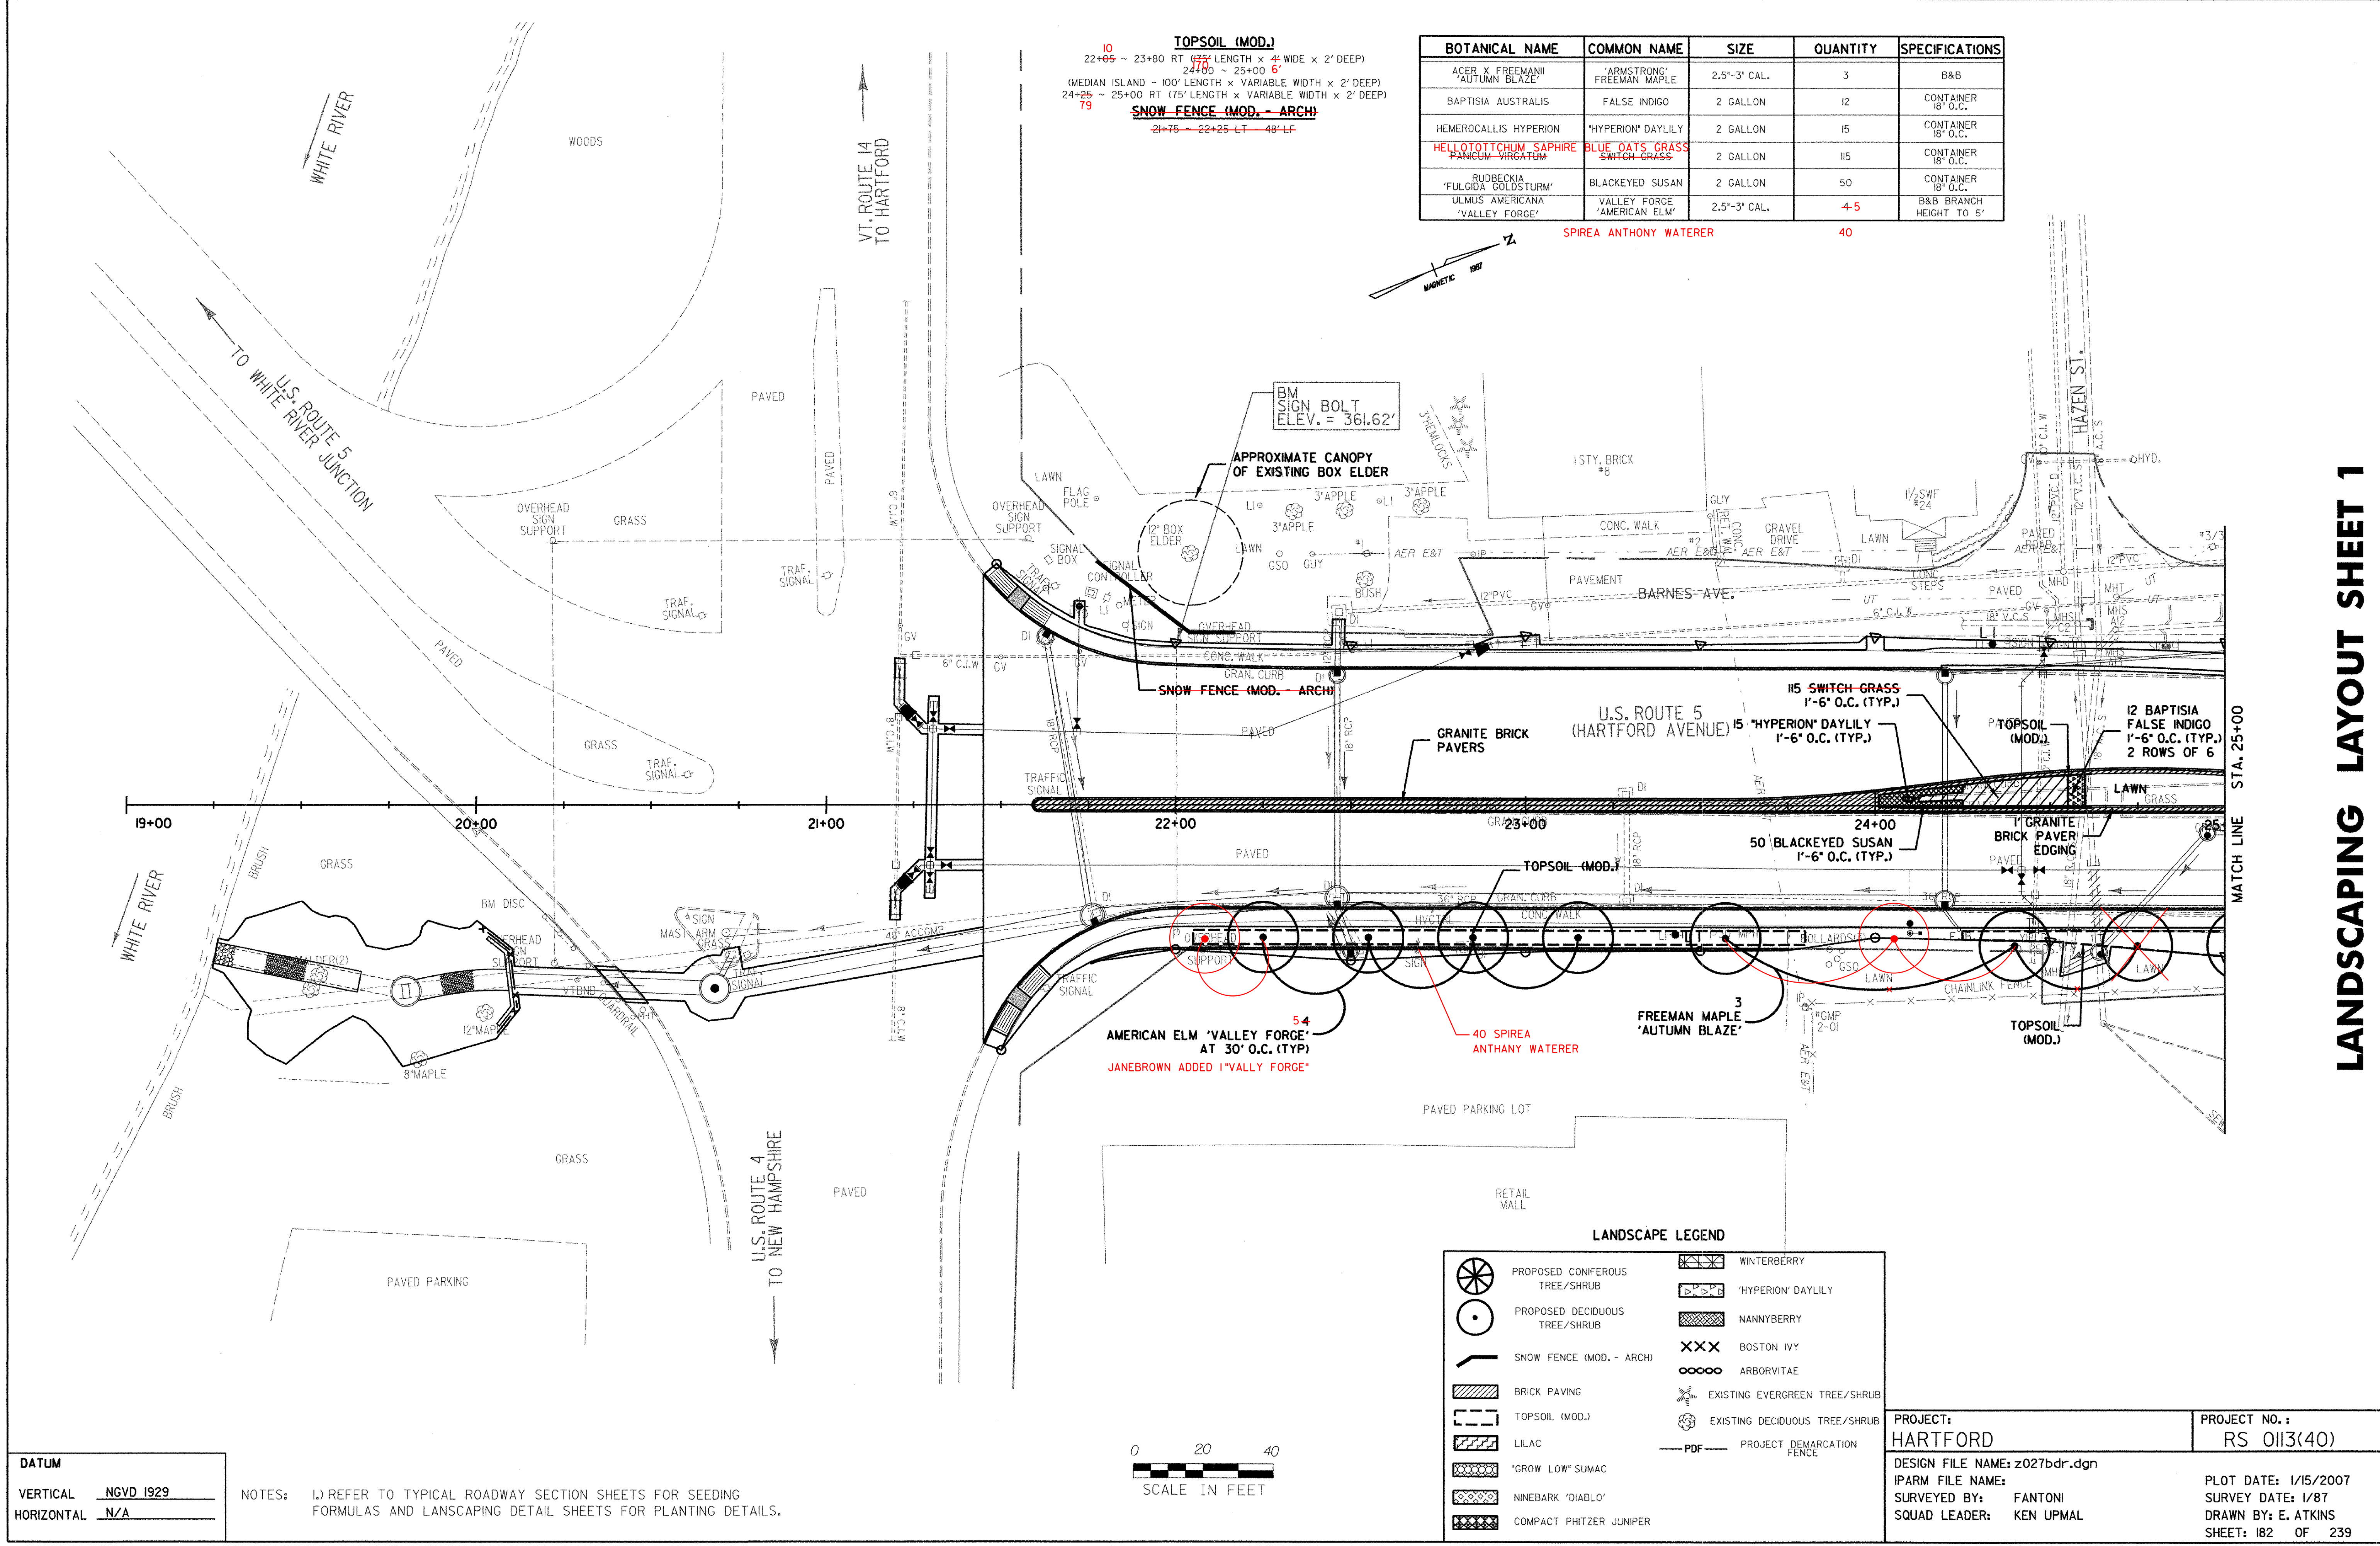

DATUM

VERTICAL	NGVD 1929
HORIZONTAL	N/A

NOTES: 1.) REFER TO TYPICAL ROADWAY SECTION SHEETS FOR SEEDING FORMULAS AND LANDSCAPING DETAIL SHEETS FOR PLANTING DETAILS.

TOPSOIL (MOD.)
 22+05 ~ 23+80 RT (75' LENGTH x 4' WIDE x 2' DEEP)
 24+00 ~ 25+00 6'
 (MEDIAN ISLAND - 100' LENGTH x VARIABLE WIDTH x 2' DEEP)
 24+25 ~ 25+00 RT (75' LENGTH x VARIABLE WIDTH x 2' DEEP)
SNOW FENCE (MOD. - ARCH)
 21+75 ~ 22+25 LT 48' LF

BOTANICAL NAME	COMMON NAME	SIZE	QUANTITY	SPECIFICATIONS
ACER X FREEMANI 'AUTUMN BLAZE'	'ARMSTRONG' FREEMAN MAPLE	2.5'-3' CAL.	3	B&B
BAPTISIA AUSTRALIS	FALSE INDIGO	2 GALLON	12	CONTAINER 18" O.C.
HEMEROCALLIS HYPERION	'HYPERION' DAYLILY	2 GALLON	15	CONTAINER 18" O.C.
HELLOTTOTTHUM SAPHIRE 'PANGUM-VIRGATUM'	BLUE OATS GRASS SWITCH GRASS	2 GALLON	115	CONTAINER 18" O.C.
RUDBECKIA 'FULGIDA GOLDSTURM'	BLACKEYED SUSAN	2 GALLON	50	CONTAINER 18" O.C.
ULMUS AMERICANA 'VALLEY FORGE'	VALLEY FORGE 'AMERICAN ELM'	2.5'-3' CAL.	4-5	B&B BRANCH HEIGHT TO 5'
	PIREIA ANTHONY WATERER		40	

LANDSCAPE LEGEND

	PROPOSED CONIFEROUS TREE/SHRUB		WINTERBERRY
	PROPOSED DECIDUOUS TREE/SHRUB		'HYPERION' DAYLILY
	SNOW FENCE (MOD. - ARCH)		NANNYBERRY
	BRICK PAVING		BOSTON IVY
	TOPSOIL (MOD.)		ARBORVITAE
	LILAC		EXISTING EVERGREEN TREE/SHRUB
	'GROW LOW' SUMAC		EXISTING DECIDUOUS TREE/SHRUB
	NINEBARK 'DIABLO'		PROJECT DEMARCATION FENCE
	COMPACT PHYTIS JUNIPER		



PROJECT: HARTFORD	PROJECT NO.: RS 0113(40)
DESIGN FILE NAME: z027bdr.dgn	PLOT DATE: 1/15/2007
IPARM FILE NAME:	SURVEY DATE: 1/87
SURVEYED BY: FANTONI	DRAWN BY: E. ATKINS
SQUAD LEADER: KEN UPMAL	SHEET: 182 OF 239