
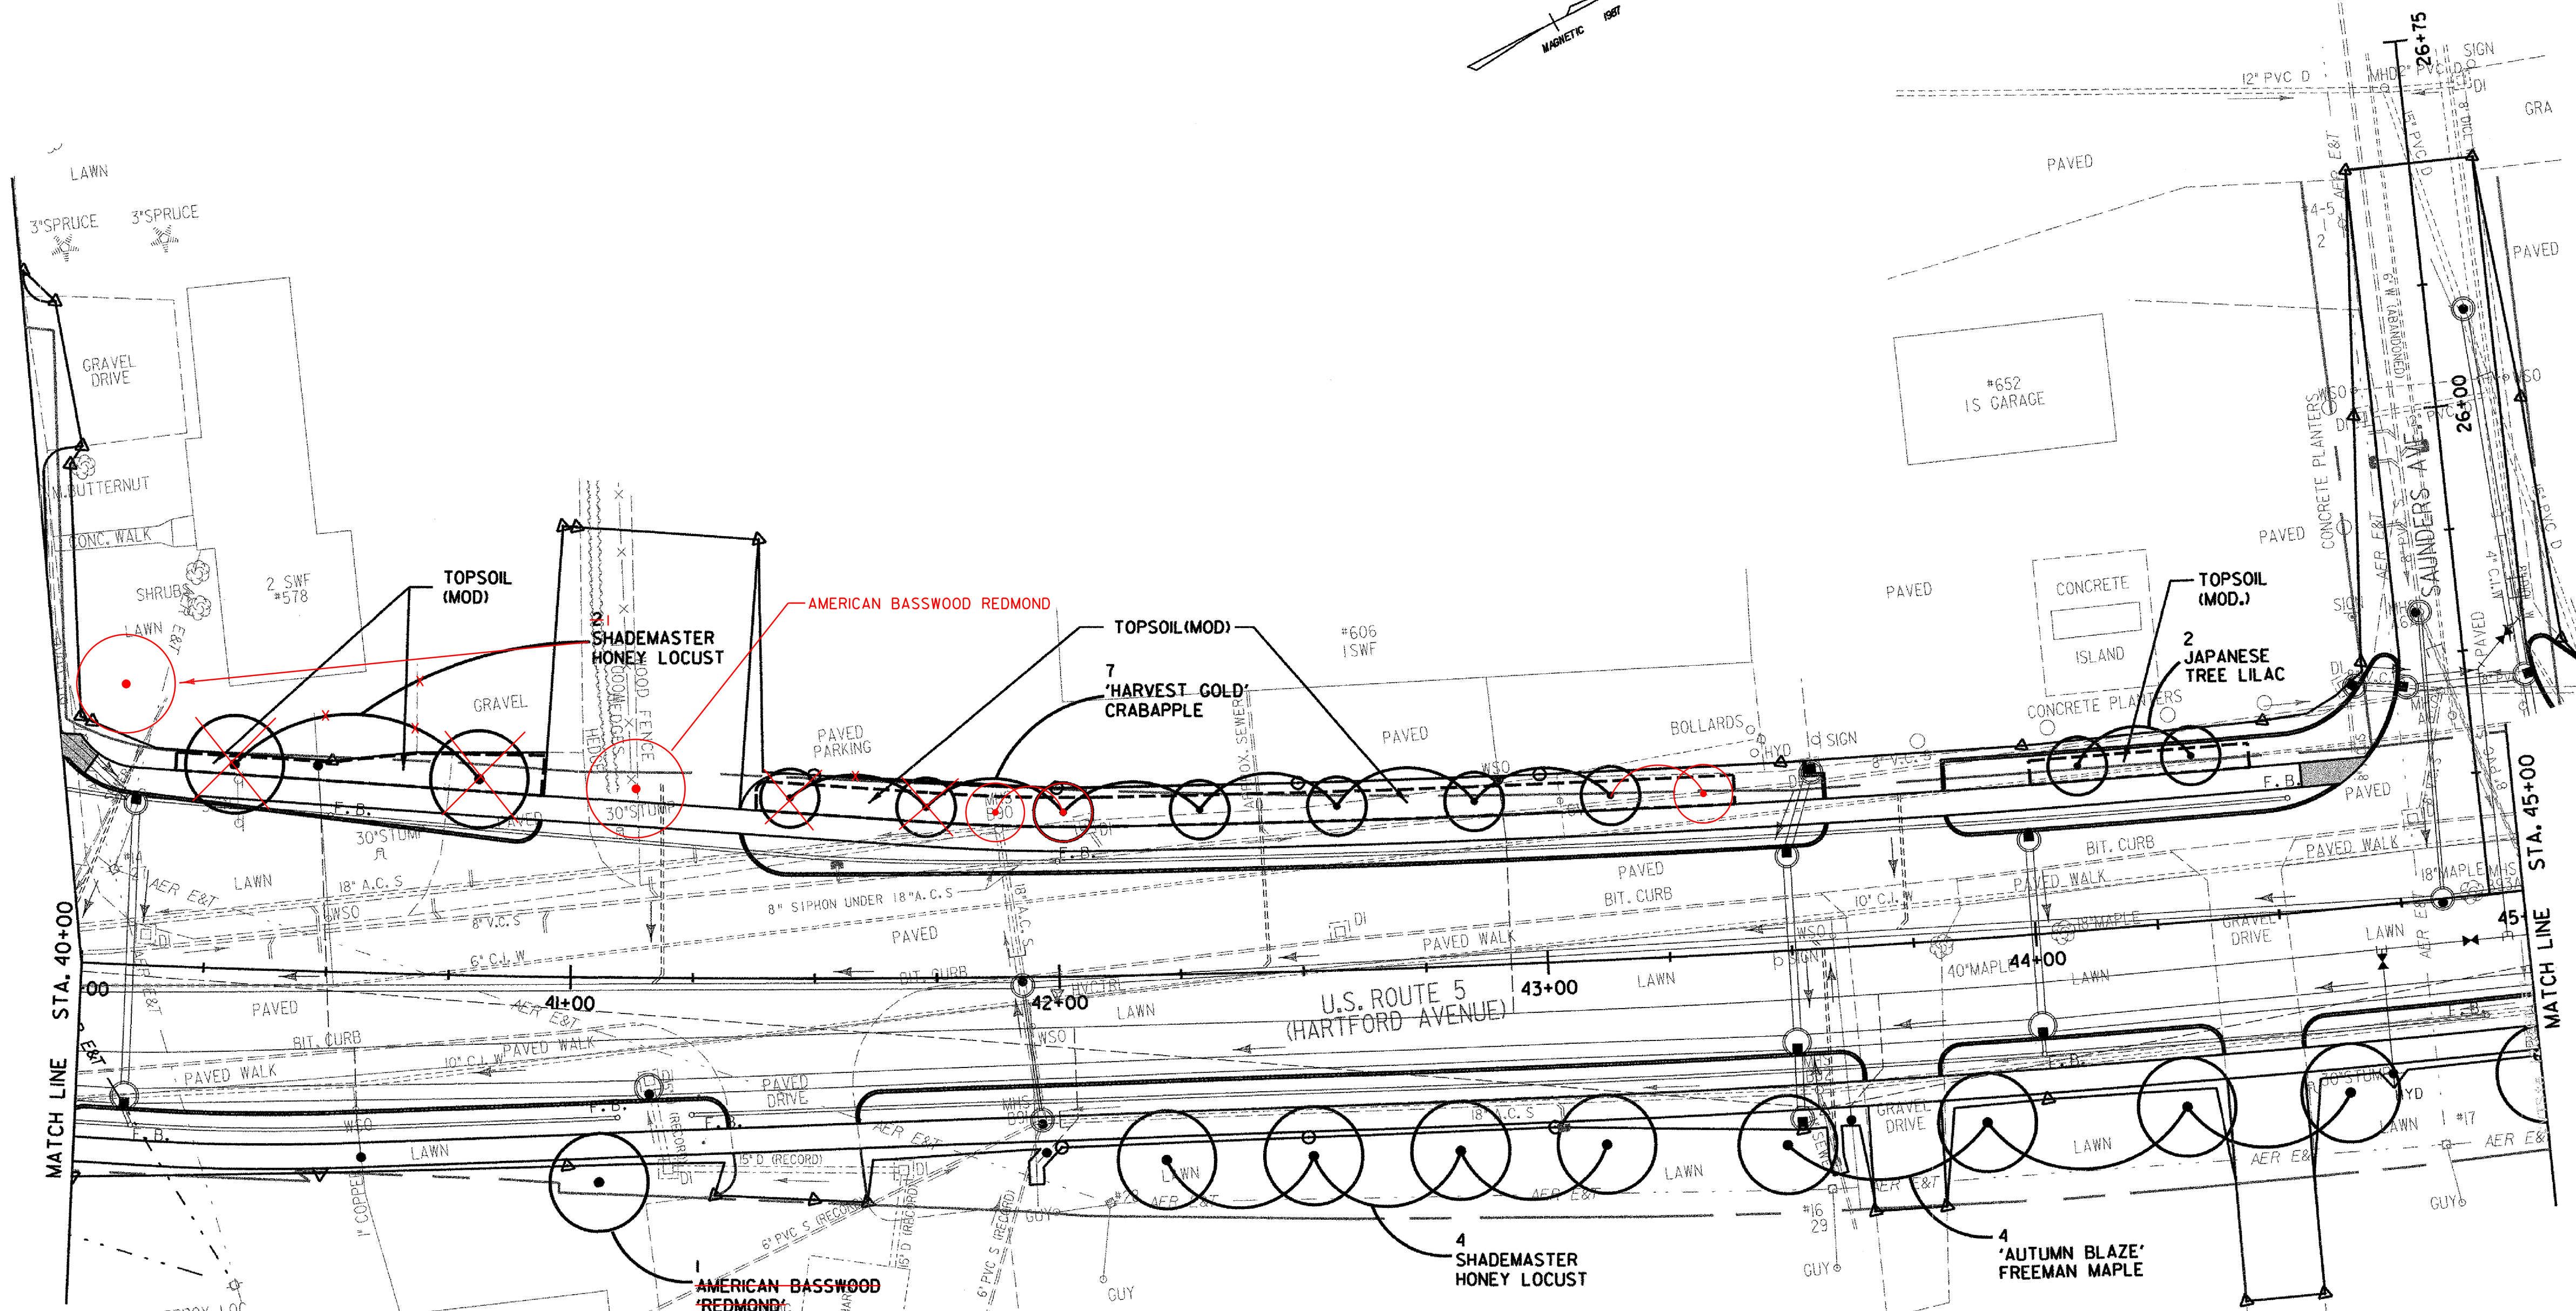



BOTANICAL NAME	COMMON NAME	SIZE	QUANTITY	SPECIFICATIONS
ACER X FREEMANI 'AUTUMN BLAZE'	'ARMSTRONG' FREEMAN MAPLE	2.5'-3' CAL.	4	B&B
GLEDITSIA TRIACANTHOS 'SHADEMASTER'	'SHADEMASTER' HONEY LOCUST	2.5'-3' CAL.	6-5	B&B
MALUS 'HARVEST GOLD'	'HARVEST GOLD' CRABAPPLE	1.5' CAL.	7	B&B
SYRINGA RETICULATA 'IVORY SILK'	'IVORY SILK' JAPANESE TREE LILAC	1.5'-2' CAL.	2-3	B&B
TILIA AMERICANA 'REDMOND'	REDMOND AMERICAN BASSWOOD	2.5'-3' CAL.	1	B&B

84
 41+38 ~ 43+40 LT (25' LENGTH x 5'6" WIDE X 2' DEEP)
 44+01 ~ 44+47 LT (46' LENGTH x 8'5" WIDE X 2' DEEP)
 40+18 ~ 40+33 LT (15' LENGTH x VARIABLE WIDTH X 2' DEEP)
 40+94 41+31

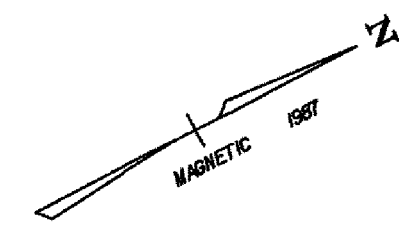

LANDSCAPE LEGEND

	PROPOSED CONIFEROUS TREE/SHRUB		WINTERBERRY
	PROPOSED DECIDUOUS TREE/SHRUB		'HYPERION' DAYLILY
	BRICK PAVING		NANNYBERRY
	TOPSOIL (MOD.)		BOSTON IVY
	LILAC		ARBORVITAE
	'GROW LOW' SUMAC		EXISTING EVERGREEN TREE/SHRUB
	NINEBARK 'DIABLO'		EXISTING DECIDUOUS TREE/SHRUB
	COMPACT PHYTZER JUNIPER		PROJECT DEMARCATION FENCE
			SNOW FENCE (MOD. - ARCH)

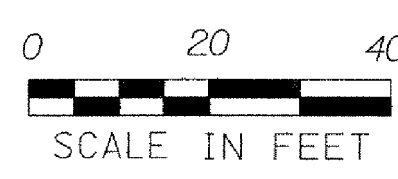

DATUM
 VERTICAL NGVD 1929
 HORIZONTAL N/A

NOTES: 1.) REFER TO TYPICAL ROADWAY SECTION SHEETS FOR SEEDING FORMULAS AND LANDSCAPING DETAIL SHEETS FOR PLANTING DETAILS.

PROJECT: HARTFORD	PROJECT NO.: RS 0113(40)
DESIGN FILE NAME: z027bdr.dgn	PLOT DATE: 1/15/2007
IPARM FILE NAME:	SURVEY DATE: 1/87
SURVEYED BY: FANTONI	DRAWN BY: E. ATKINS
SQUAD LEADER: KEN UPMAL	SHEET: 186 OF 239