
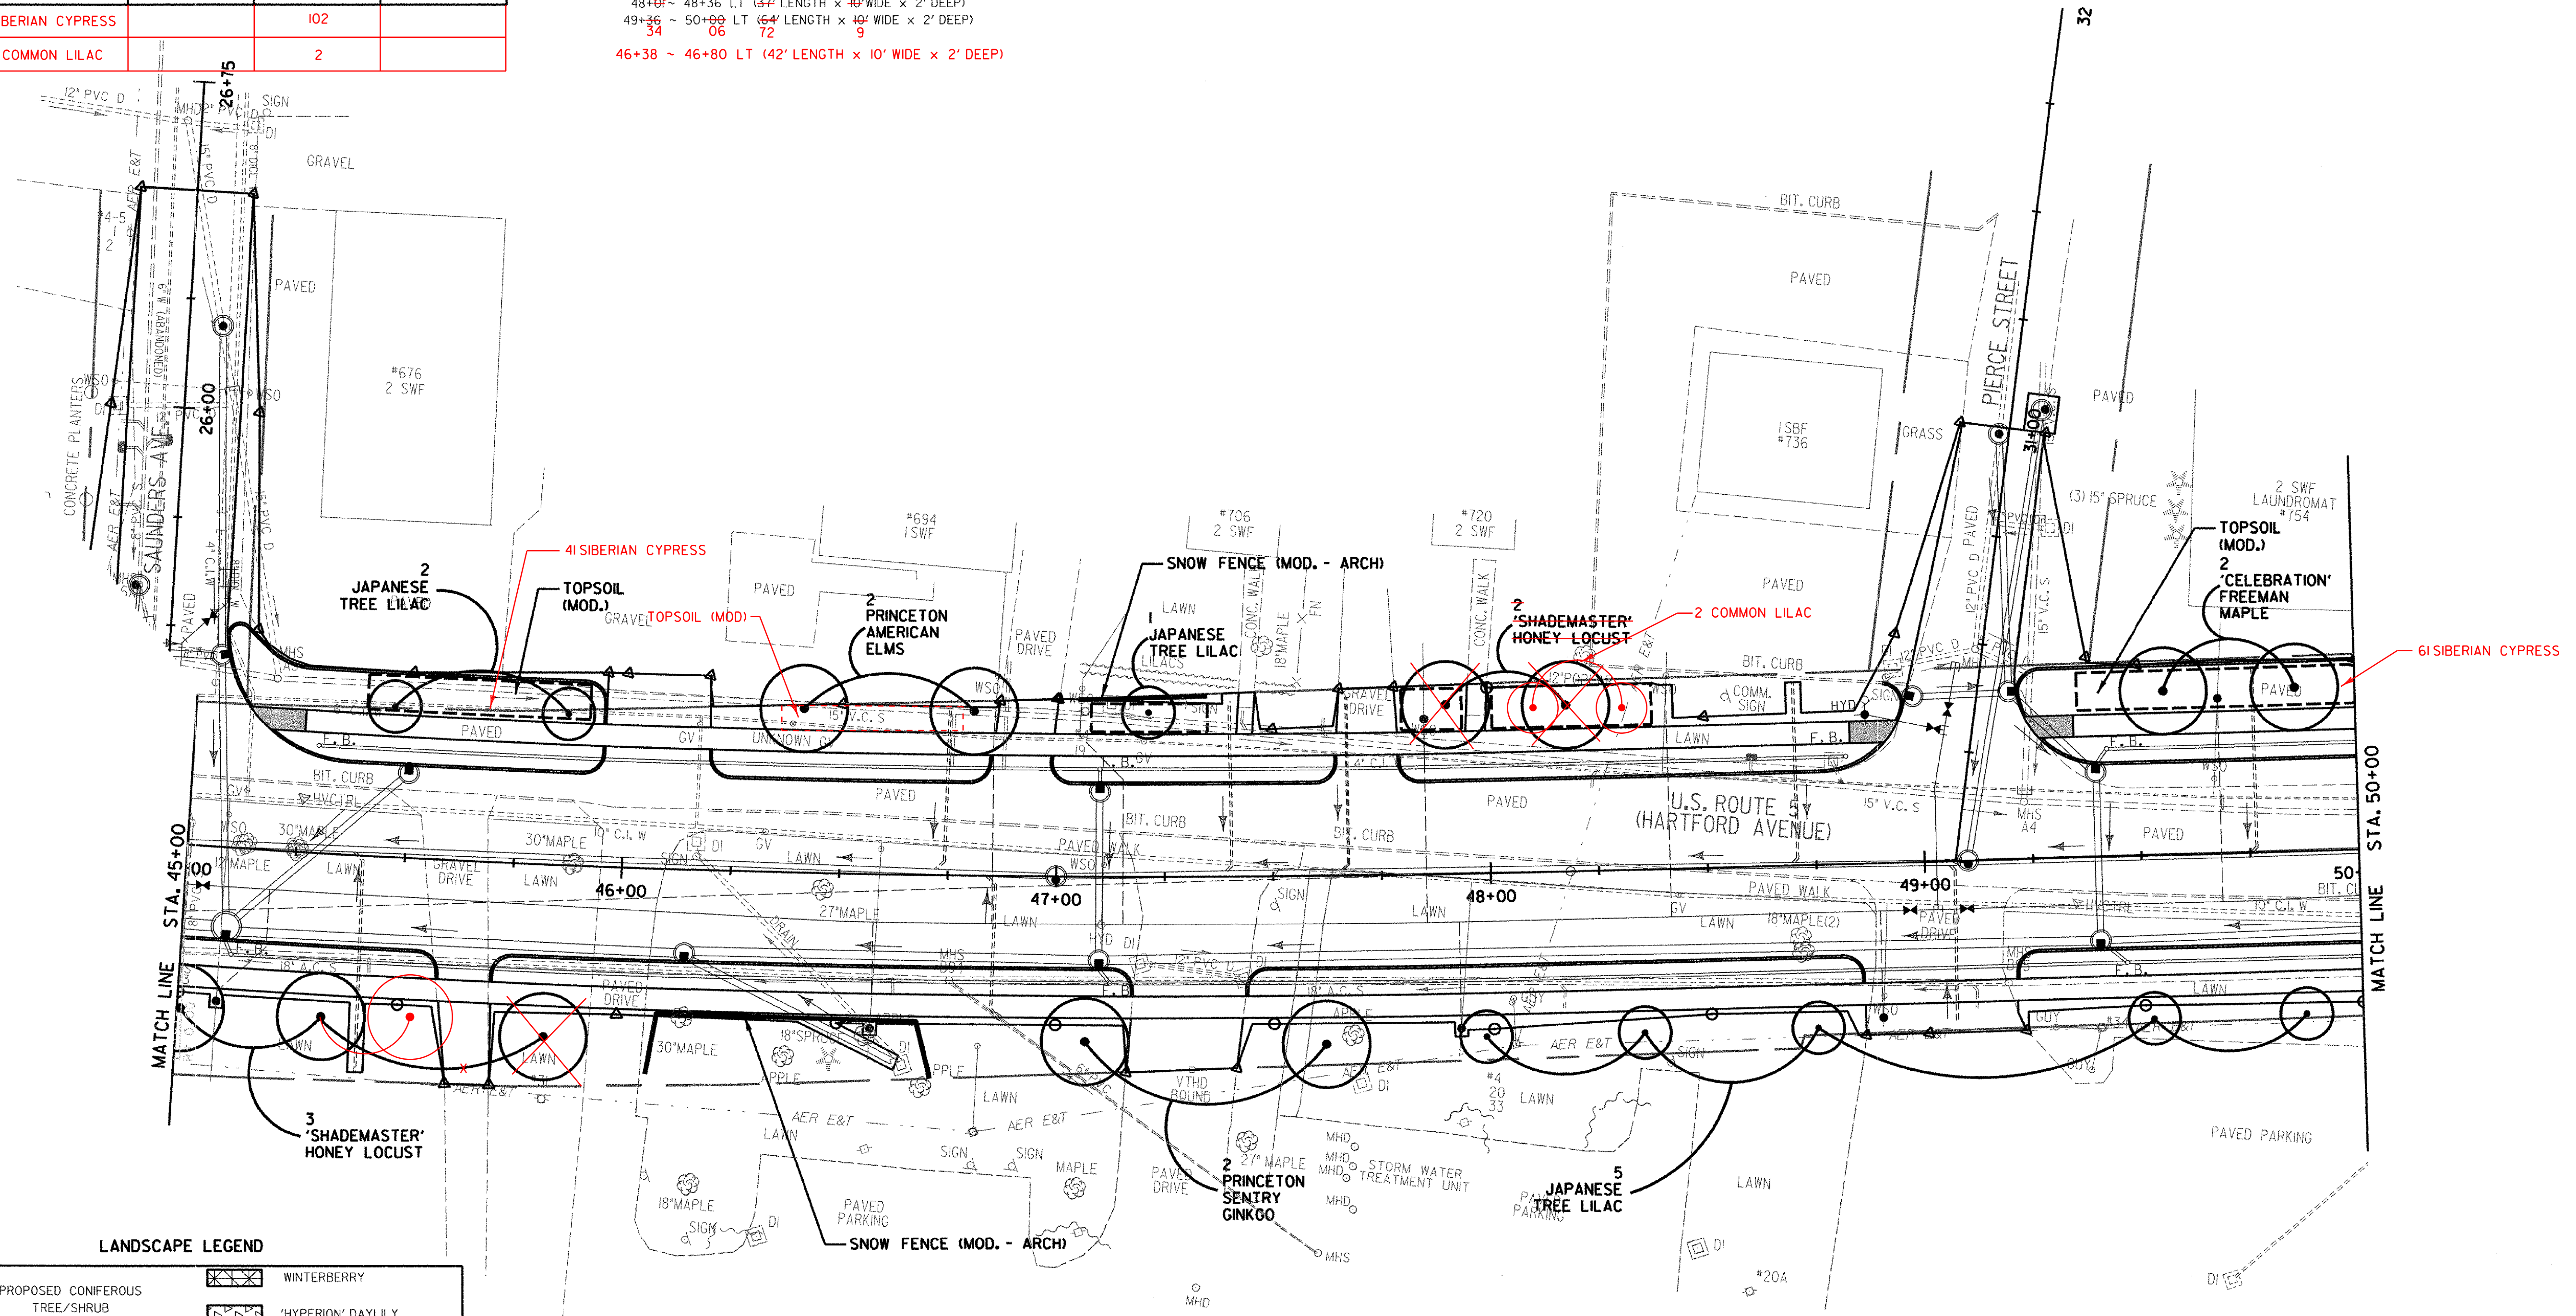


BOTANICAL NAME	COMMON NAME	SIZE	QUANTITY	SPECIFICATIONS
ACER X FREEMANII 'CELEBRATION'	FREEMAN MAPLE	2.5"-3" CAL.	2	B&B
GINKGO BILOBA 'PRINCETON SENTRY'	PRINCETON SENTRY GINKGO	2.5"-3" CAL.	2	B&B
GLEDTISIA TRIACANTHOS 'SHADEMASTER'	'SHADEMASTER' HONEY LOCUST	2.5"-3" CAL.	5 3	B&B
SYRINGA RETICULATA 'IVORY SILK'	'IVORY SILK' JAPANESE TREE LILAC	1.5"-2" CAL.	8	B&B
ULMUS AMERICANA 'PRINCETON'	'PRINCETON' AMERICAN ELM	2.5"-3" CAL.	-2	B&B BRANCH HEIGHT TO 5'
	SIBERIAN CYPRESS		102	
	COMMON LILAC		2	


**SNOW FENCE (MOD. - ARCH)**  
 46+07 ~ 46+74 RT - 89'  
 47+05 ~ 47+35 LT HEDGE PROTECTION - 60'

**TOPSOIL (MOD.)**  
 45+48 ~ 45+95 LT 47' LENGTH x 8' WIDE x 2' DEEP  
 47+88 ~ 47+35 LT 47' LENGTH x 7' WIDE x 2' DEEP  
 47+86 ~ 47+94 LT 8' LENGTH x 10' WIDE x 2' DEEP  
 48+01 ~ 48+36 LT 35' LENGTH x 10' WIDE x 2' DEEP  
 49+36 ~ 50+06 LT 70' LENGTH x 10' WIDE x 2' DEEP  
 46+38 ~ 46+80 LT (42' LENGTH x 10' WIDE x 2' DEEP)

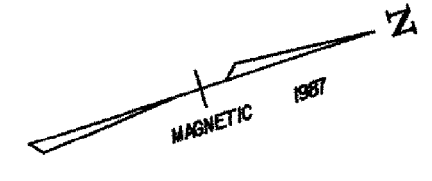

**LANDSCAPE LEGEND**

	PROPOSED CONIFEROUS TREE/SHRUB		WINTERBERRY
	PROPOSED DECIDUOUS TREE/SHRUB		'HYPERION' DAYLILY
	BRICK PAVING		NANNYBERRY
	TOPSOIL (MOD.)		BOSTON IVY
	LILAC		ARBORVITAE
	'GROW LOW' SUMAC		EXISTING EVERGREEN TREE/SHRUB
	NINEBARK 'DIABLO'		EXISTING DECIDUOUS TREE/SHRUB
	COMPACT PFITZER JUNIPER		PROJECT DEMARCATION FENCE
			SNOW FENCE (MOD. - ARCH)

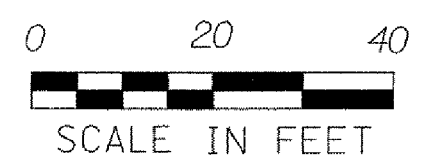

**DATUM**  
 VERTICAL NGVD 1929  
 HORIZONTAL N/A

NOTES: 1.) REFER TO TYPICAL ROADWAY SECTION SHEETS FOR SEEDING FORMULAS AND LANDSCAPING DETAIL SHEETS FOR PLANTING DETAILS.

PROJECT: <b>HARTFORD</b>	PROJECT NO.: RS 0113(40)
DESIGN FILE NAME: z027bdr.dgn	PLOT DATE: 1/15/2007
IPARM FILE NAME:	SURVEY DATE: 1/87
SURVEYED BY: FANTONI	DRAWN BY: E. ATKINS
SQUAD LEADER: KEN UPMAL	SHEET: 187 OF 239

**LANDSCAPING LAYOUT SHEET 6**