
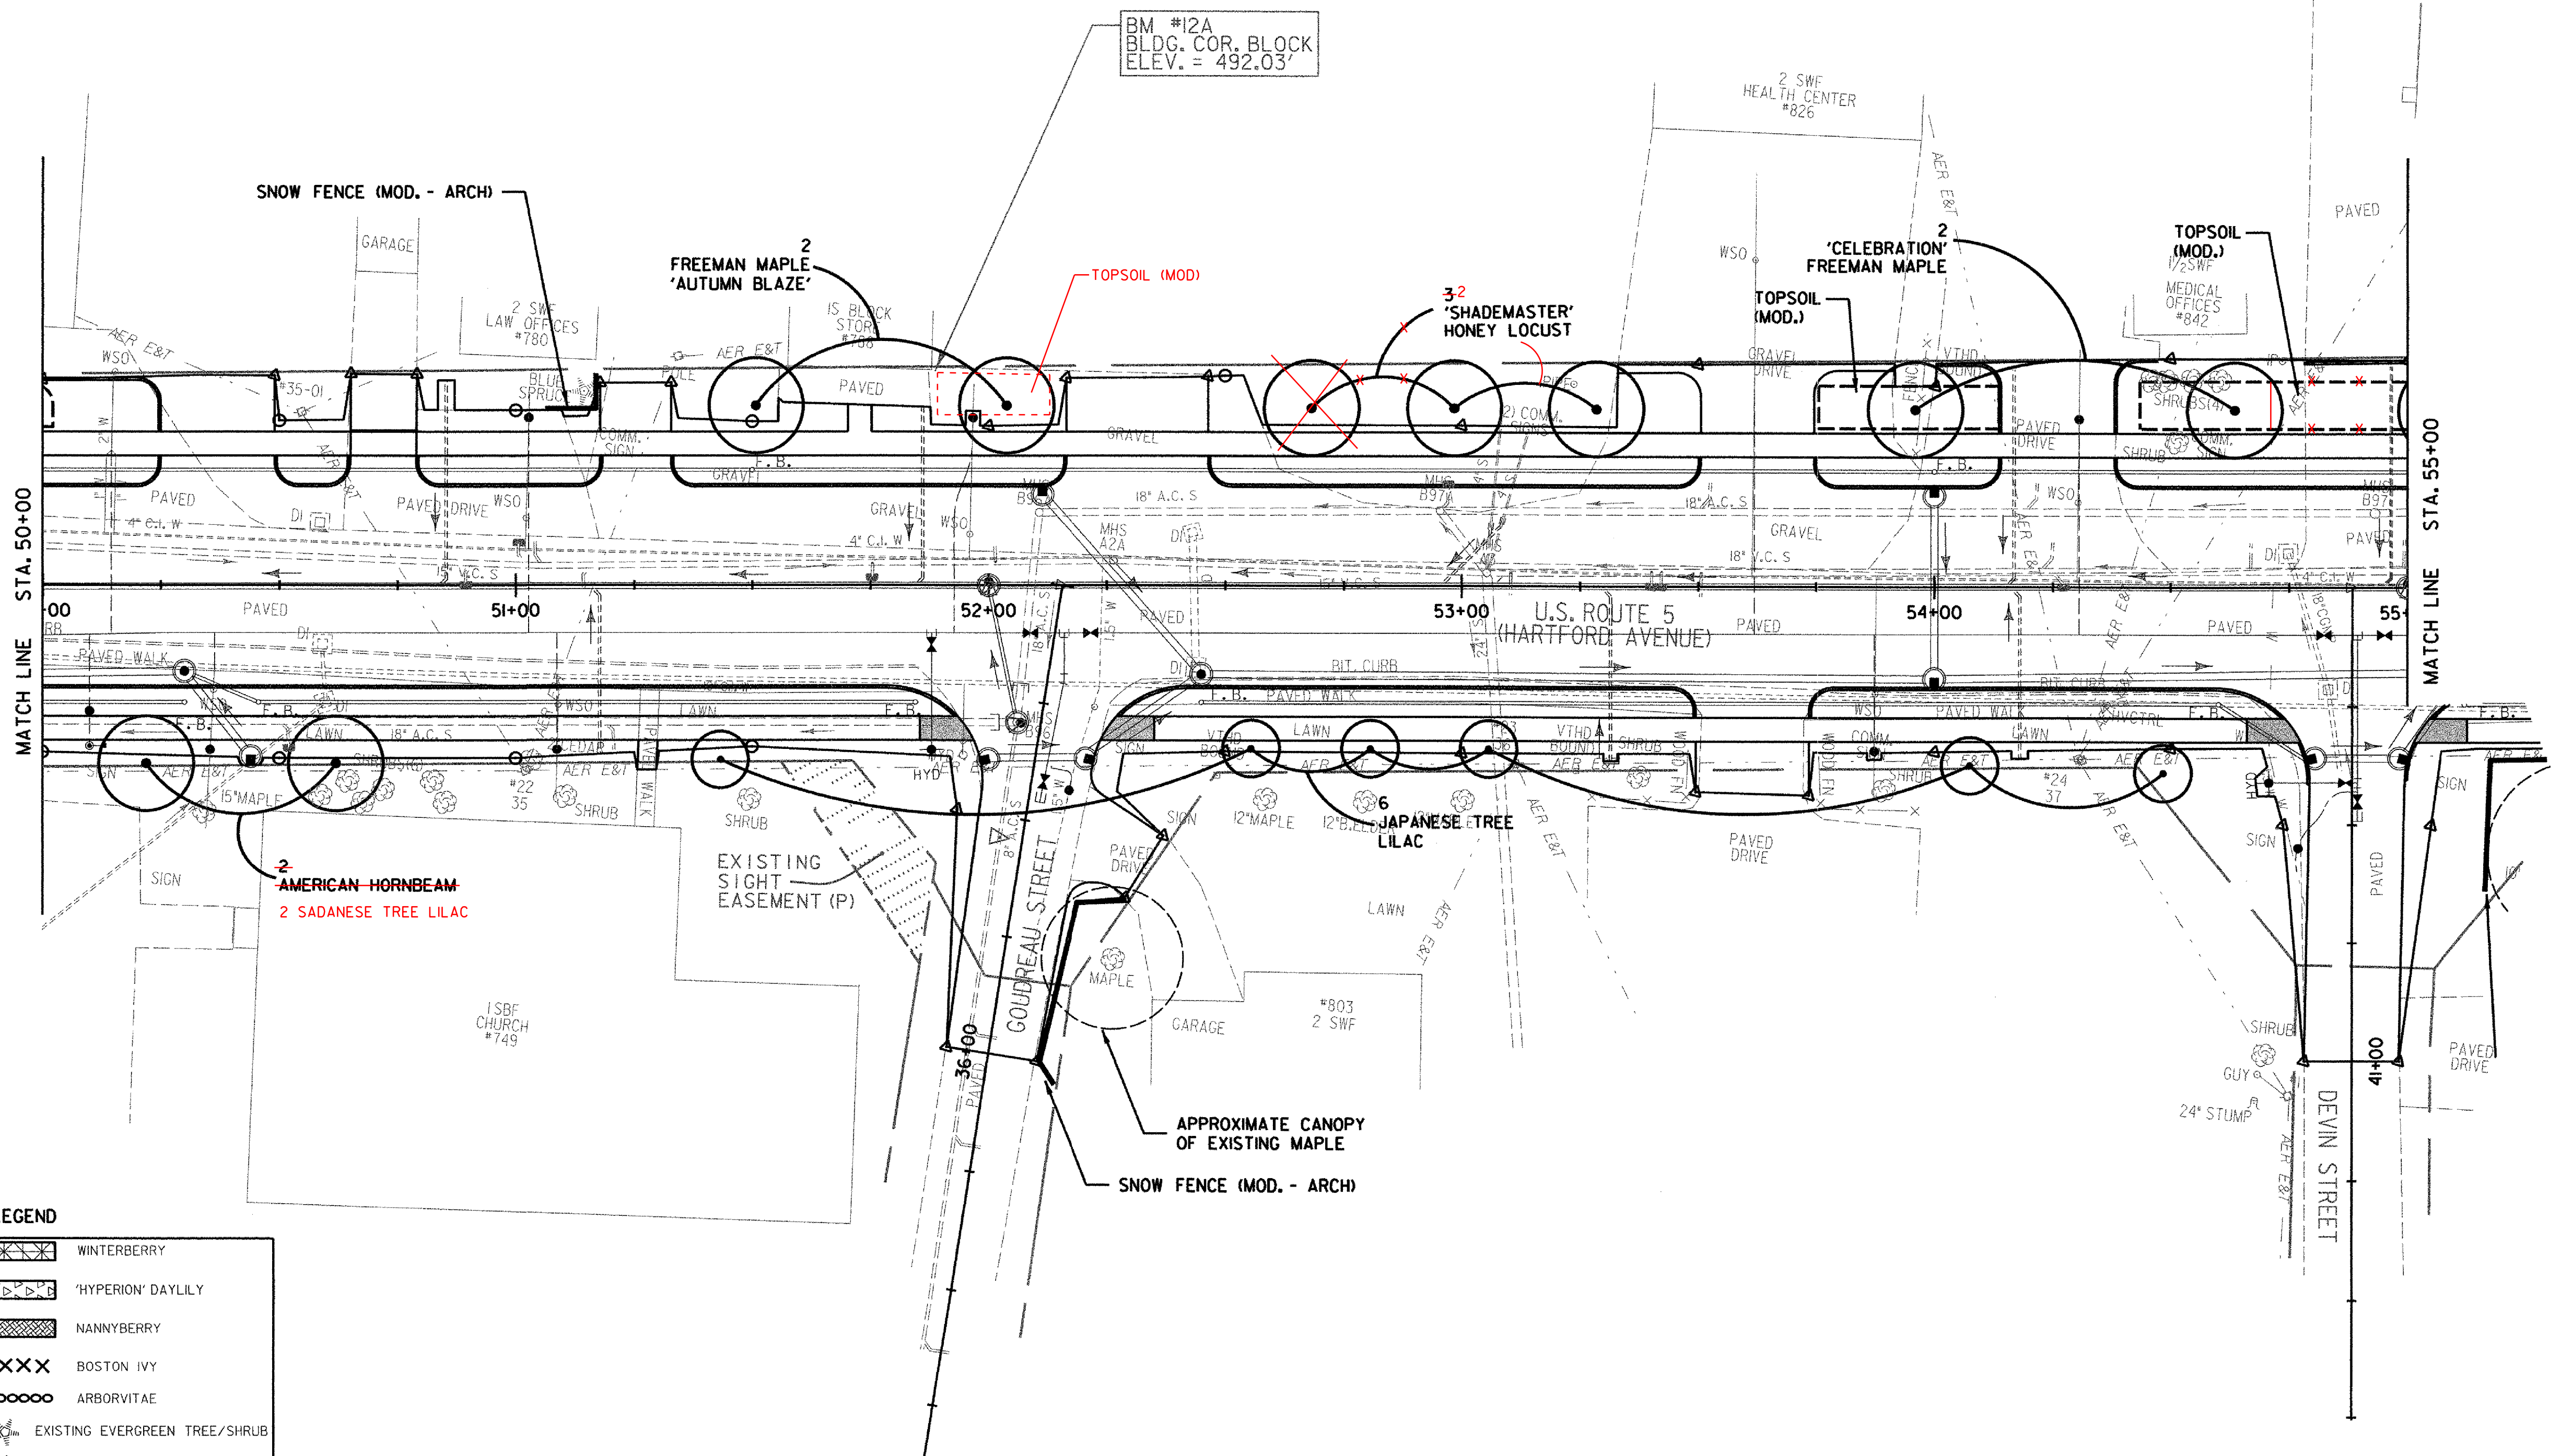


BOTANICAL NAME	COMMON NAME	SIZE	QUANTITY	SPECIFICATIONS
ACER X FREEMANII 'AUTUMN BLAZE'	'ARMSTRONG' FREEMAN MAPLE	2.5'-3" CAL.	2	B&B
ACER X FREEMANII 'CELEBRATION'	'CELEBRATION' FREEMAN MAPLE	2.5'-3" CAL.	2	B&B
CARPINUS CAROLINIANA	AMERICAN HORNBEAM	2.5'-3" CAL.	± 0	B&B
GLEDITSIA TRIACANTHOS 'SHADEMASTER'	'SHADEMASTER' HONEY LOCUST	2.5'-3" CAL.	± 2	B&B
SYRINGA RETICULATA 'IVORY SILK'	'IVROY SILK' JAPANESE TREE LILAC	1.5'-2" CAL.	± 8	B&B

76 10 TOPSOIL (MOD.)
 53+75 ~ 54+44 LT (38' LENGTH X 10' WIDE X 2' DEEP)
 54+44 ~ 55+00 LT (56' LENGTH X 10' WIDE X 2' DEEP)
 54+67 21
 SNOW FENCE (MOD. - ARCH)
 51+06 ~ 51+17 LT - 18 FT
 35+63 ~ 36+00 LT (GOUDREAU ST) - 51 FT

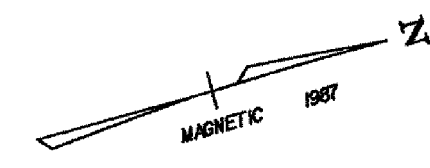

LANDSCAPE LEGEND

	PROPOSED CONIFEROUS TREE/SHRUB		WINTERBERRY
	PROPOSED DECIDUOUS TREE/SHRUB		'HYPERION' DAYLILY
	BRICK PAVING		NANNYBERRY
	TOPSOIL (MOD.)		BOSTON IVY
	LILAC		ARBORVITAE
	'GROW LOW' SUMAC		EXISTING EVERGREEN TREE/SHRUB
	NINEBARK 'DIABLO'		EXISTING DECIDUOUS TREE/SHRUB
	COMPACT PFITZER JUNIPER		PROJECT DEMARCATION FENCE
			SNOW FENCE (MOD. - ARCH)



DATUM
 VERTICAL NGVD 1929
 HORIZONTAL N/A

NOTES: 1.) REFER TO TYPICAL ROADWAY SECTION SHEETS FOR SEEDING FORMULAS AND LANDSCAPING DETAIL SHEETS FOR PLANTING DETAILS.

PROJECT: HARTFORD	PROJECT NO. : RS 0113(40)
DESIGN FILE NAME: z027bdr.dgn	PLOT DATE: 1/15/2007
IPARM FILE NAME:	SURVEY DATE: 1/87
SURVEYED BY: FANTONI	DRAWN BY: E. ATKINS
SQUAD LEADER: KEN UPMAL	SHEET: 188 OF 239