


BL 3/23/10
 COMMON EXCAVATION DITCH LT 8x15.5=124.5 SF ✓
 ROUND DITCH 230x7.5=1725 SF ✓
 LANDSCAPE RT 7x2=14 SF ✓
 M/L COMMON 350.5x12.4=4346 SF ✓
 SAND 65.75 ✓
 SURFACE 169.58 ✓
 F.G.=80.5 LF
 BL 3/23/10
 RED 1/24/11
 6-8-10
 6-3-10
 368.9
 6/20/25/11

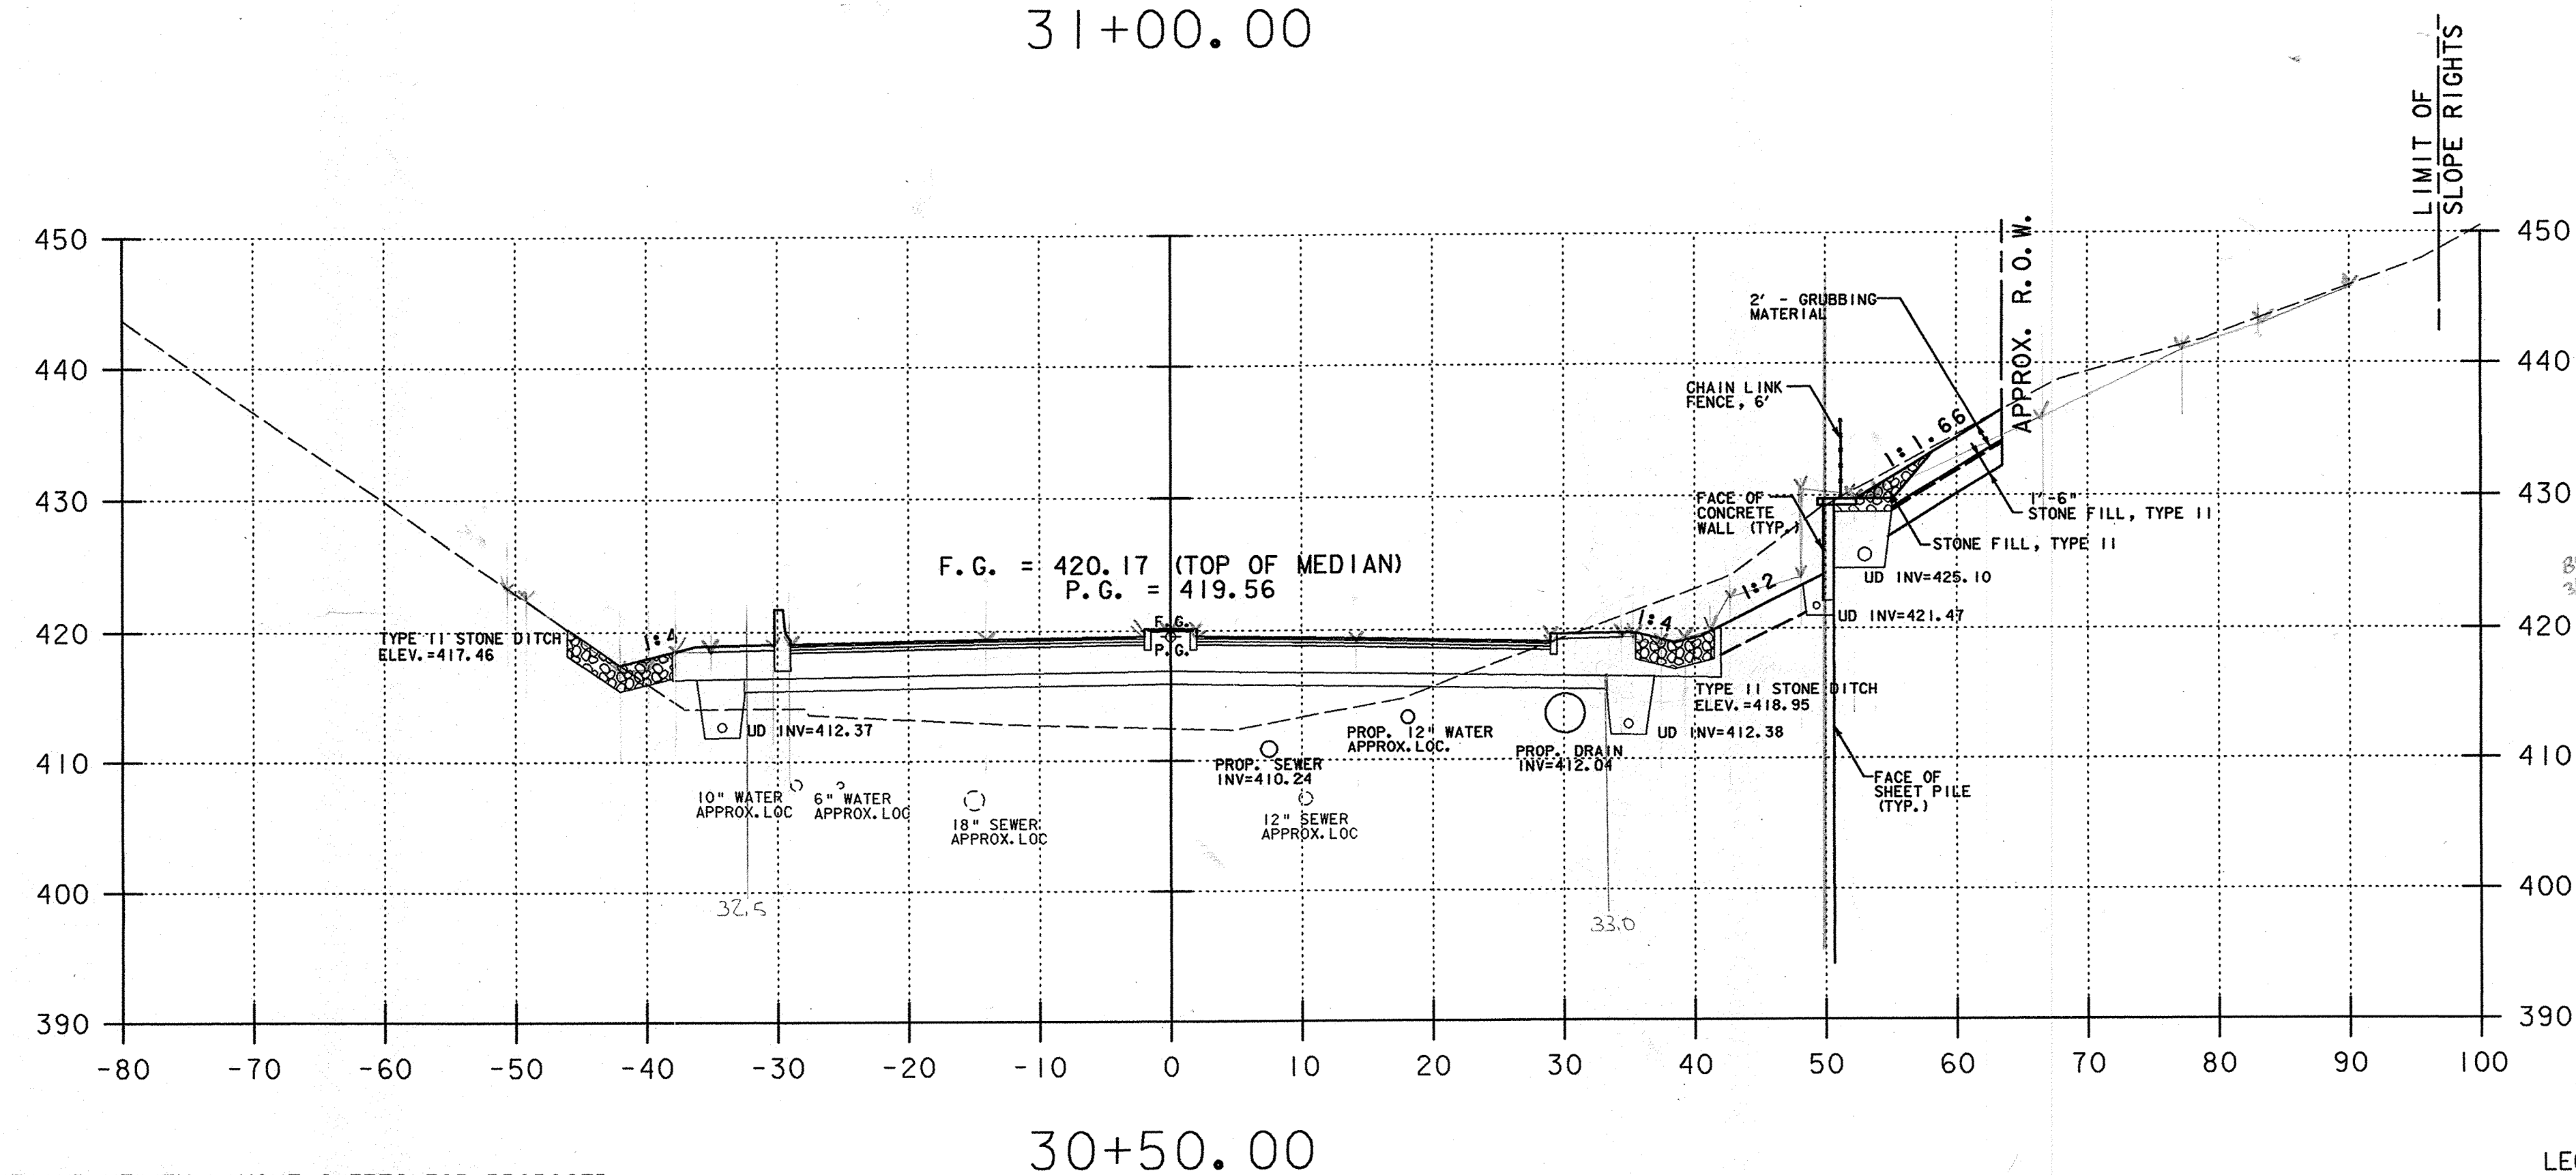

BL 3/23/10
 SAND 65.50 ✓
 SURFACE 169.58 ✓
 ROADWAY/DITCH 70x178x1.5=120.9 SF ✓
 LANDSCAPE RT 7.5x16=120 SF ✓
 DITCH LT 6x1.5=9.3 SF ✓
 M/L COMMON 120.9x9.3=1124 SF ✓
 F.G.=80.0 LF
 RED 1/24/11
 6-8-10
 6-8-10

U.S. ROUTE 5 HARTFORD AVENUE

- NOTES:**
- 1) REFER TO ROADWAY LAYOUT AND UTILITY LAYOUT SHEETS FOR PROPOSED ABANDONMENT, REMOVAL, OR PROTECTION REQUIREMENTS OF EXISTING UTILITIES IN CONFLICT WITH PROPOSED WORK.
 - 2) THE WALL SHOWN ON THE SECTIONS IS FOR PRESENTATION ONLY. SEE U.S. RTE. 5 SHEET PILE WALL PLAN AND PROFILE SHEETS AND DETAIL SHEETS FOR CONSTRUCTION REQUIREMENTS.

LEGEND:

F.G. FINISHED GRADE

P.G. PROFILE GRADE

| | |
|------------------------------|------------------------|
| PROJECT NAME: HARTFORD | |
| PROJECT NUMBER: RS 0113(40) | |
| FILE NAME: ...z86c027xsl.DGN | PLOT DATE: 3/13/2008 |
| PROJECT LEADER: | DRAWN BY: T. DUGUAY |
| DESIGNED BY: D. HOWEY | CHECKED BY: D. WOTRING |
| SHEET 4 OF 14 | |