


32+50.00

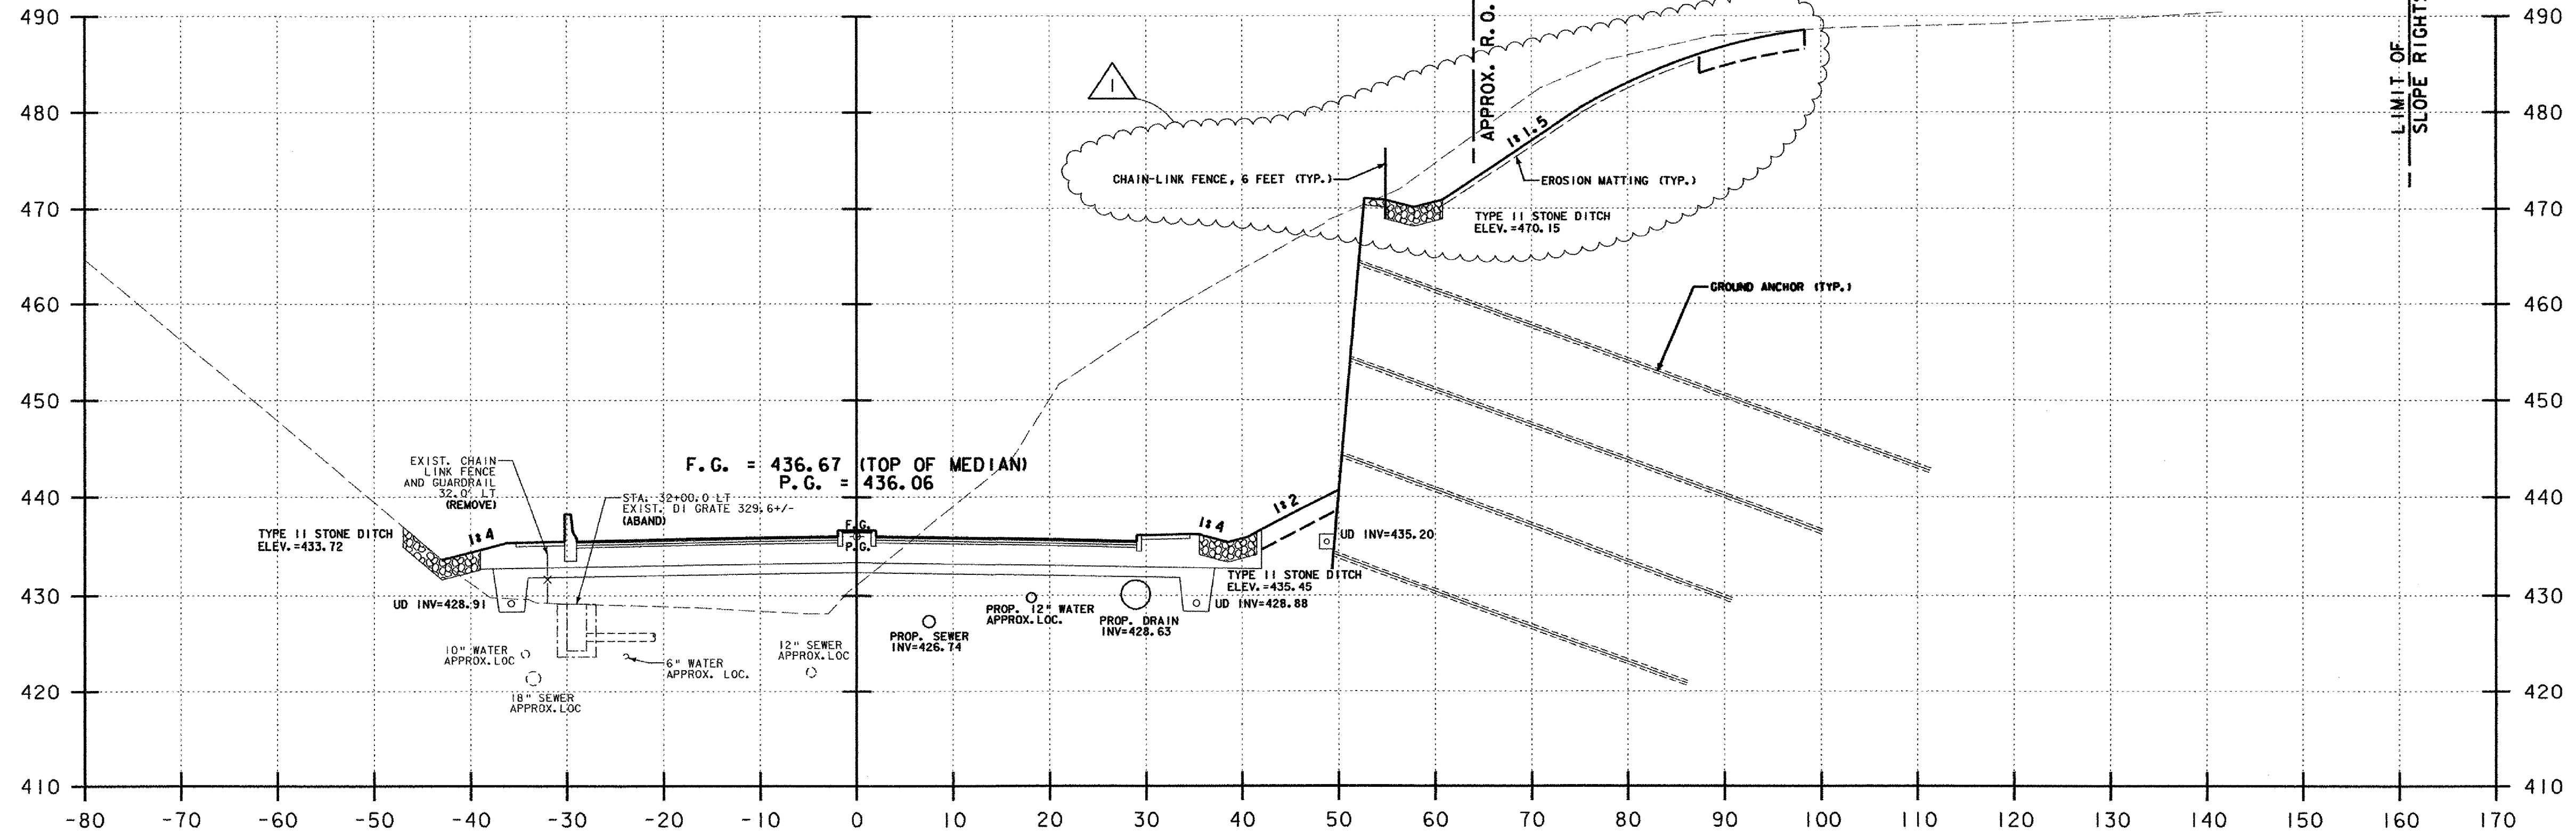

32+00.00

SEE VALUE ENGINEERING
RETAINING WALL

LEGEND:
 F.G. FINISHED GRADE
 P.G. PROFILE GRADE

U.S. ROUTE 5 HARTFORD AVENUE

- NOTES:
- REFER TO ROADWAY LAYOUT AND UTILITY LAYOUT SHEETS FOR PROPOSED ABANDONMENT, REMOVAL, OR PROTECTION REQUIREMENTS OF EXISTING UTILITIES IN CONFLICT WITH PROPOSED WORK.
 - THE WALL SHOWN ON THE SECTIONS IS FOR PRESENTATION ONLY. SEE U.S. RTE. 5 GROUND ANCHORED SOLIDER PILE WALL PLAN AND PROFILE SHEET AND DETAIL SHEETS FOR CONSTRUCTION REQUIREMENTS.

ADDENDUM #1: REVISED APRIL 18, 2007

PROJECT NAME:	HARTFORD	PLOT DATE:	4/18/2007
PROJECT NUMBER:	RS 0113(40)	DRAWN BY:	E. ATKINS
FILE NAME:	z86c027xsl.dgn	CHECKED BY:	K. ISHIKURA
PROJECT LEADER:	KEN UPMAL	SHEET	200 OF 239
DESIGNED BY:	E. ATKINS		