


COMMON EXCAVATION  
 DITCH LT = 8x1.5 = 12 SF } BL  
 ROADWAY 40' x 1.5 = 60 SF } RCO 3/23/10  
 LANDSCAPE RT = 8x2 = 16 SF } RCO 1/10/11  
 COMMON = 95.25 SF }  
 01/25/11

SAND 67.5 } BL 3/23/10  
 SUBBASE 173.32 SF } RCO 1/10/11  
 160.15 SF } RCO 01/10/11  
 F.G. = 80.50 LF } RCO 1/24/11  
 01/25/11

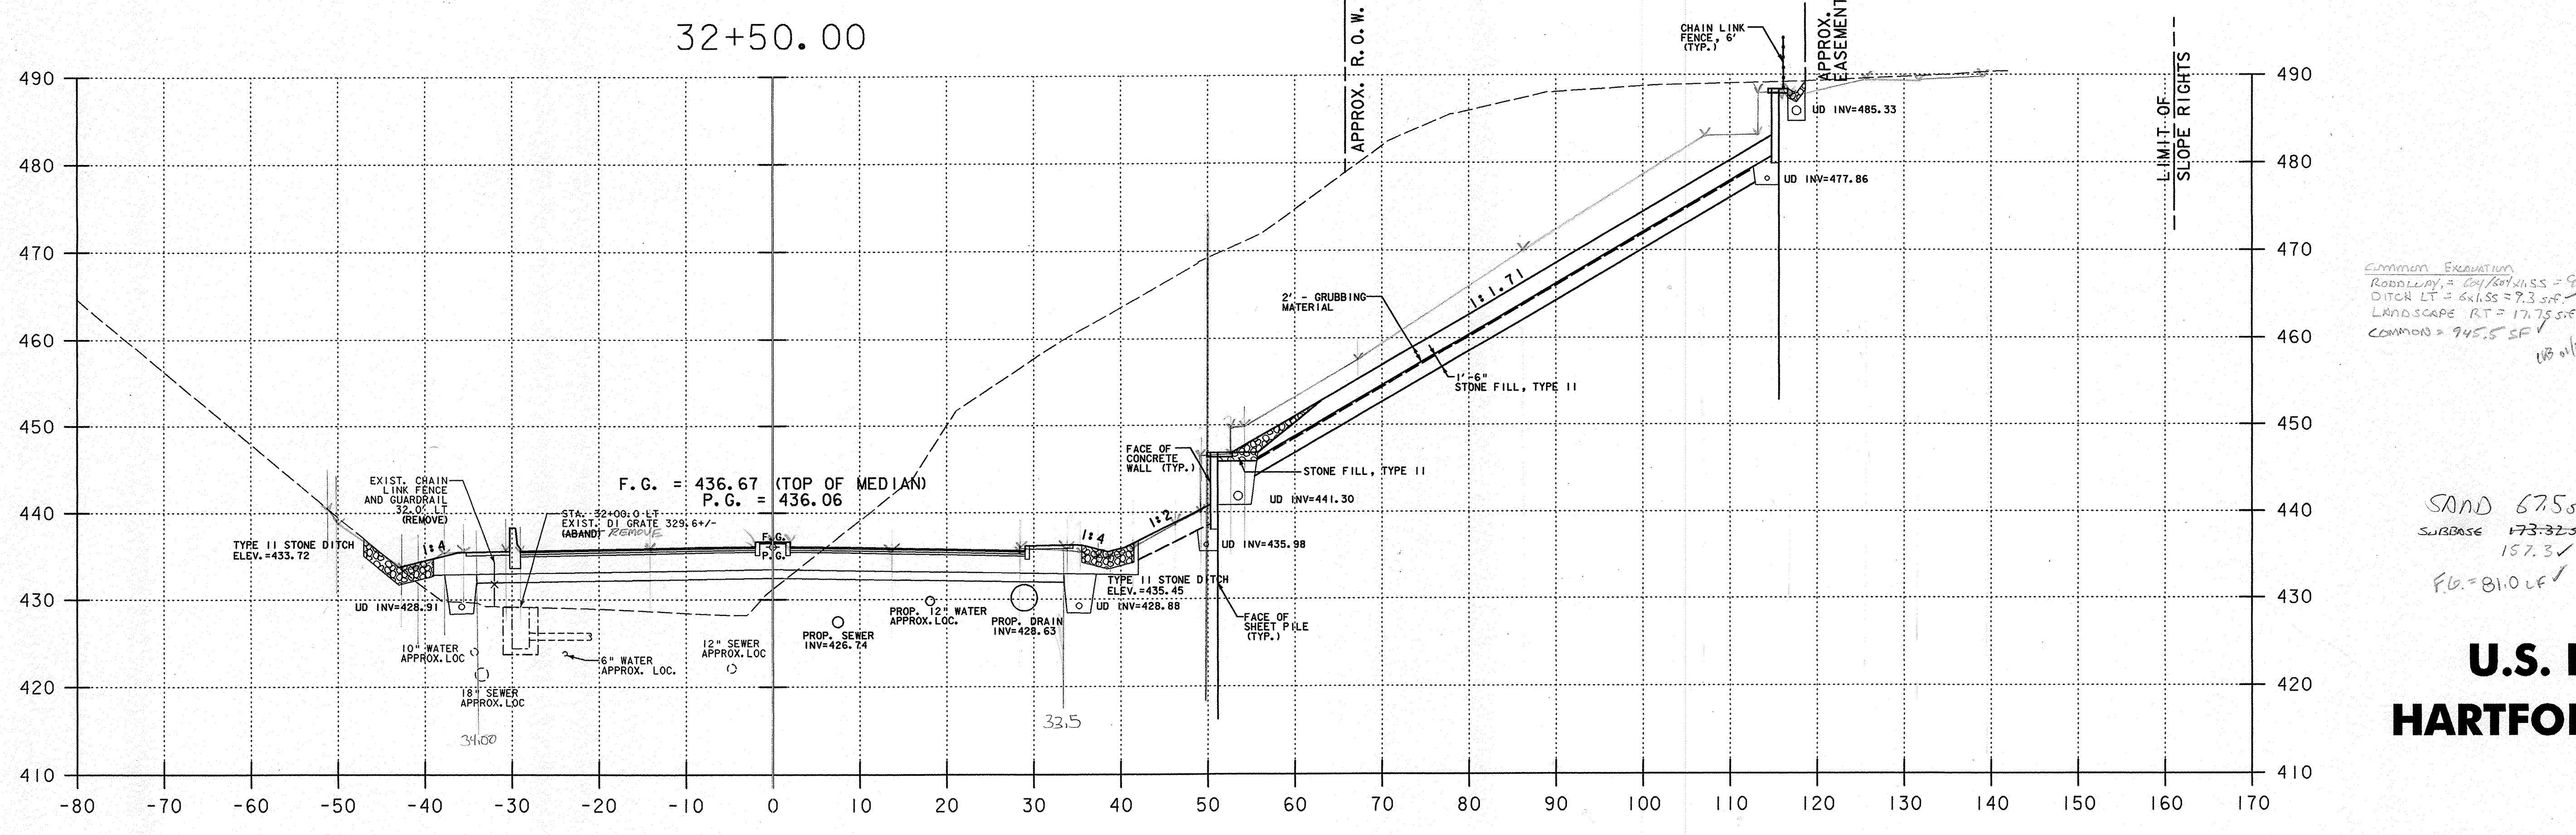

COMMON EXCAVATION  
 ROADWAY = 40' x 1.5 = 60 SF } BL 3/23/10  
 DITCH LT = 8x1.5 = 12 SF } RCO 1/10/11  
 LANDSCAPE RT = 17.75 SF } RCO 01/10/11  
 COMMON = 94.5 SF }  
 01/25/11

SAND 67.5 SF } BL 3/23/10  
 SUBBASE 173.32 SF } RCO 1/10/11  
 157.3 SF } RCO 01/10/11  
 F.G. = 81.0 LF } RCO 1/24/11  
 01/25/11

## U.S. ROUTE 5 HARTFORD AVENUE

- NOTES:**
- REFER TO ROADWAY LAYOUT AND UTILITY LAYOUT SHEETS FOR PROPOSED ABANDONMENT, REMOVAL, OR PROTECTION REQUIREMENTS OF EXISTING UTILITIES IN CONFLICT WITH PROPOSED WORK.
  - THE WALL SHOWN ON THE SECTIONS IS FOR PRESENTATION ONLY. SEE U.S. RTE. 5 SHEET PILE PLAN AND PROFILE SHEETS AND DETAIL SHEETS FOR CONSTRUCTION REQUIREMENTS.

**LEGEND:**  
 F.G. FINISHED GRADE  
 P.G. PROFILE GRADE

PROJECT NAME: HARTFORD	PLOT DATE: 3/13/2008
PROJECT NUMBER: RS 0113(40)	DRAWN BY: T. DUGUAY
FILE NAME: ...z86c027xsl.DGN	CHECKED BY: D. WOTRING
PROJECT LEADER:	SHEET 6 OF 14
DESIGNED BY: D. HOWEY	