



SUBBASE = 125.38 SF 13L 3/23/10
 COMMON = 195.2 SF RCD 1/12/11
 F.G. = 54.0 LF RCD 1/25/11
 200.8


52+50.00

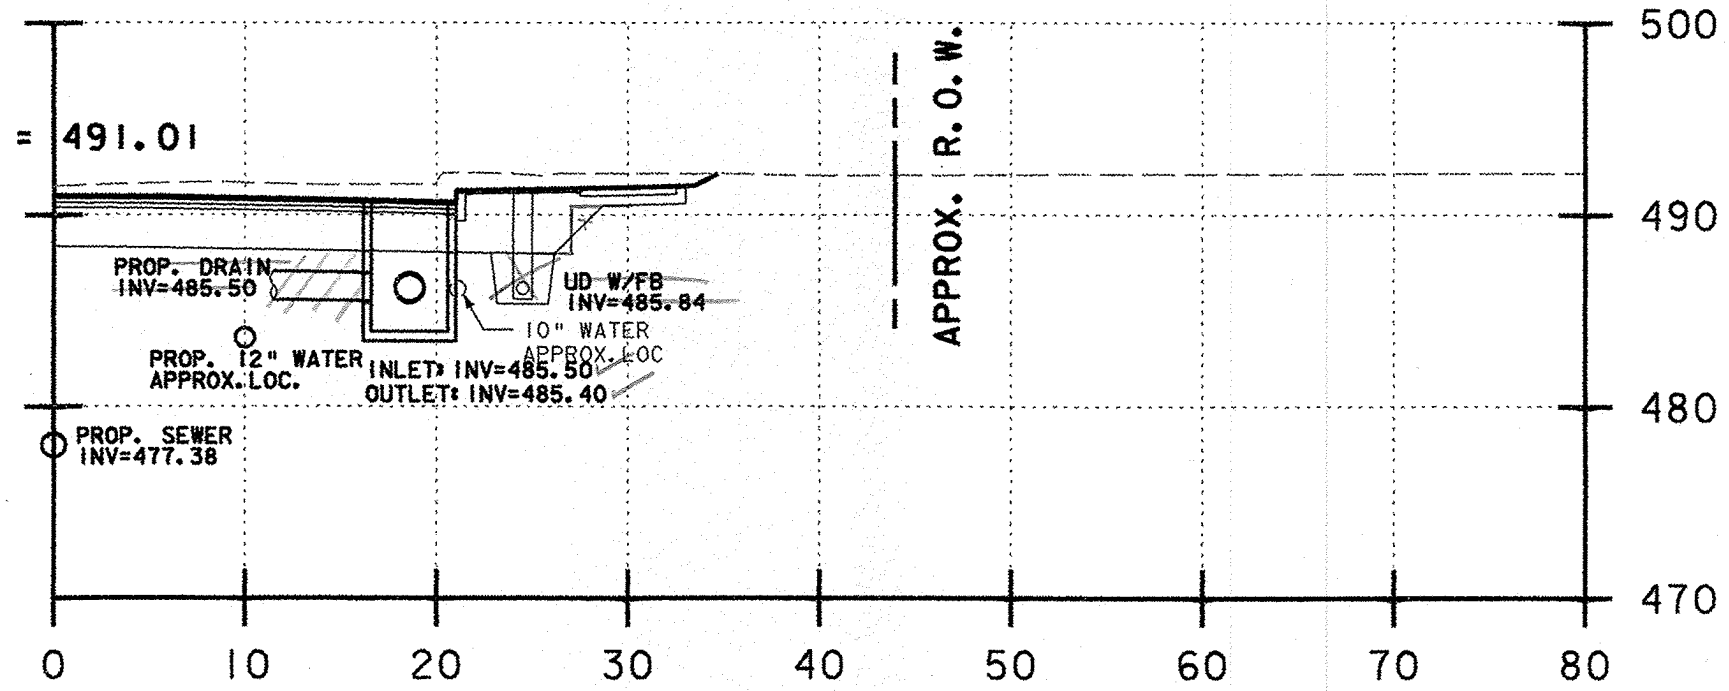


52+45.00

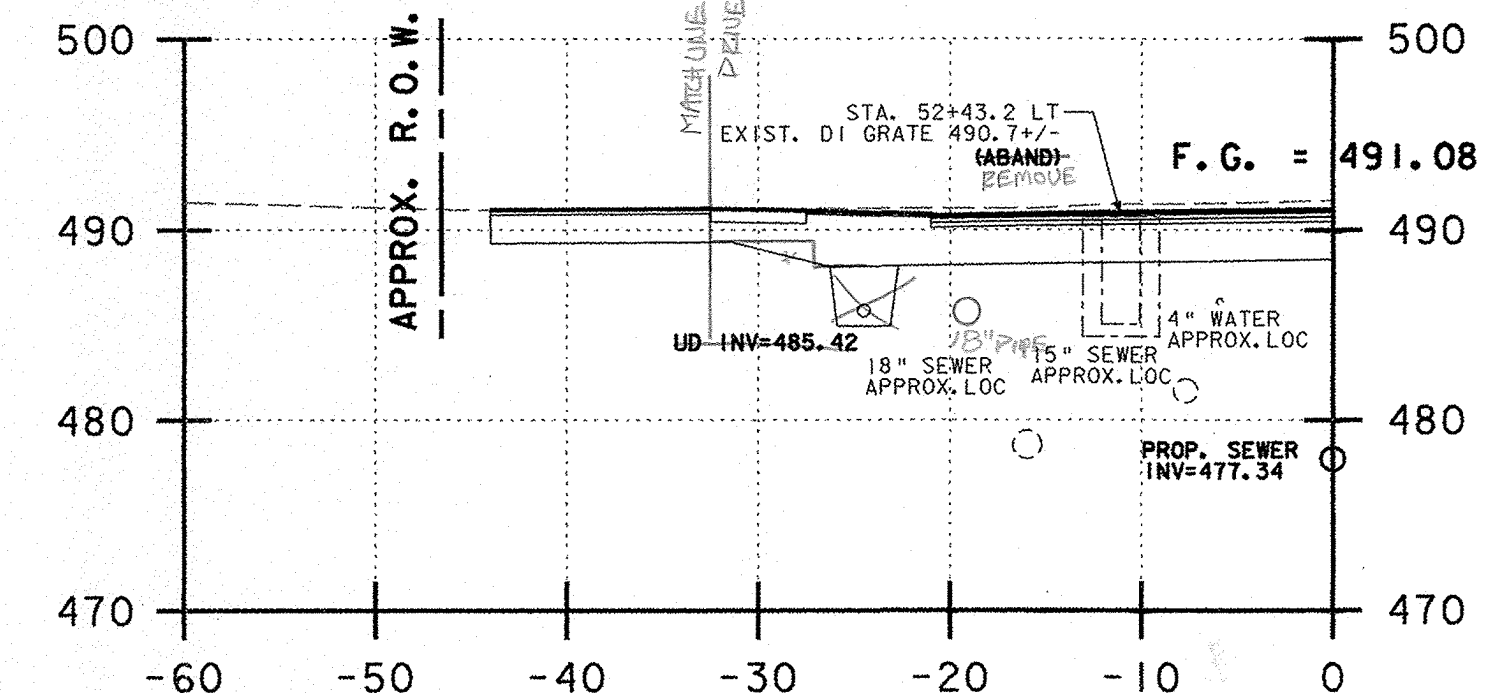

52+31.38 DRIVEWAY

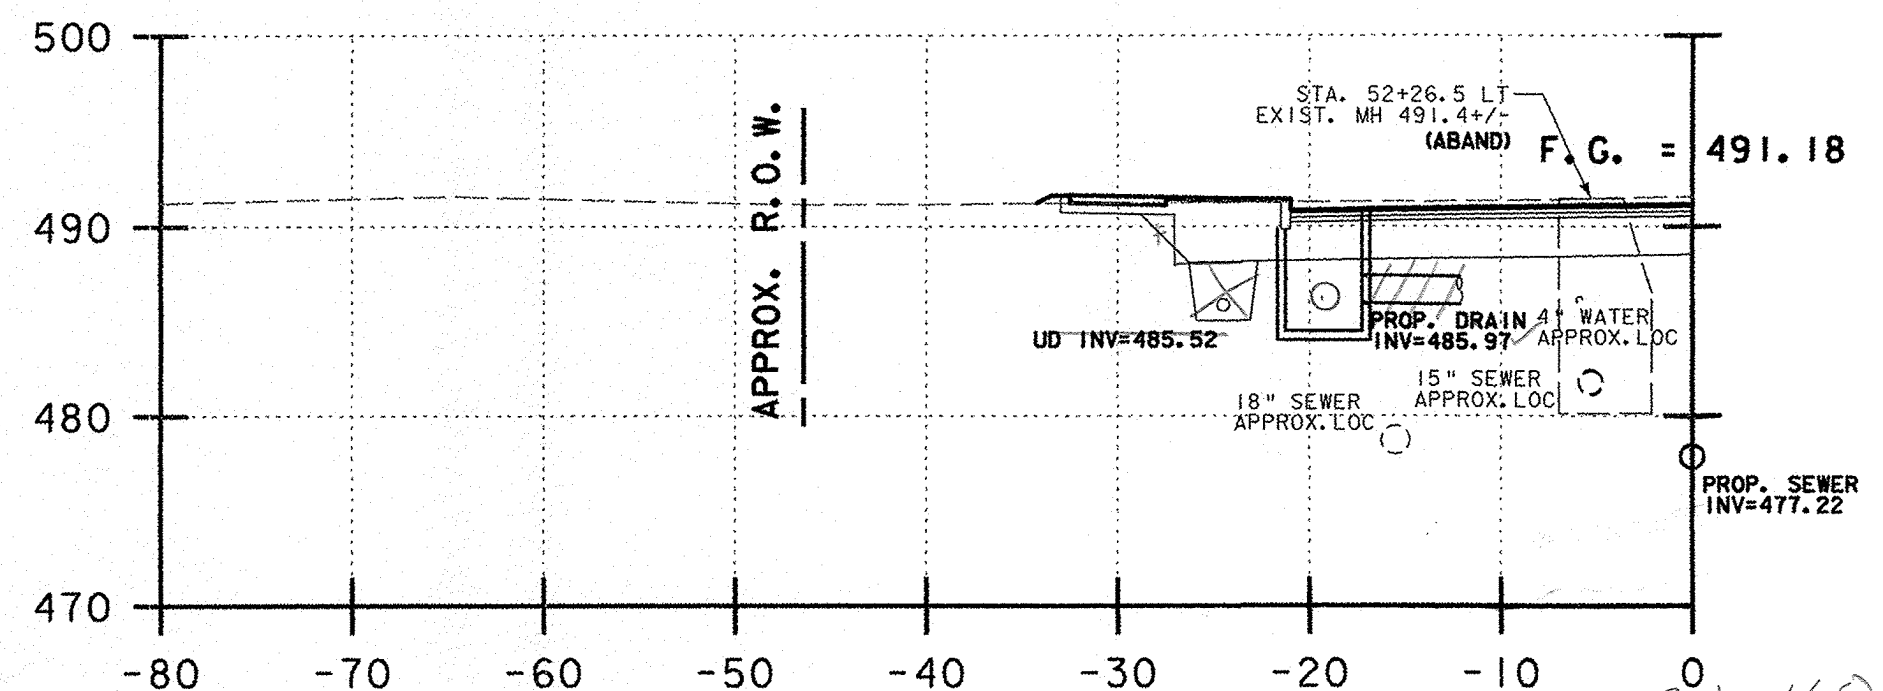

52+11.38

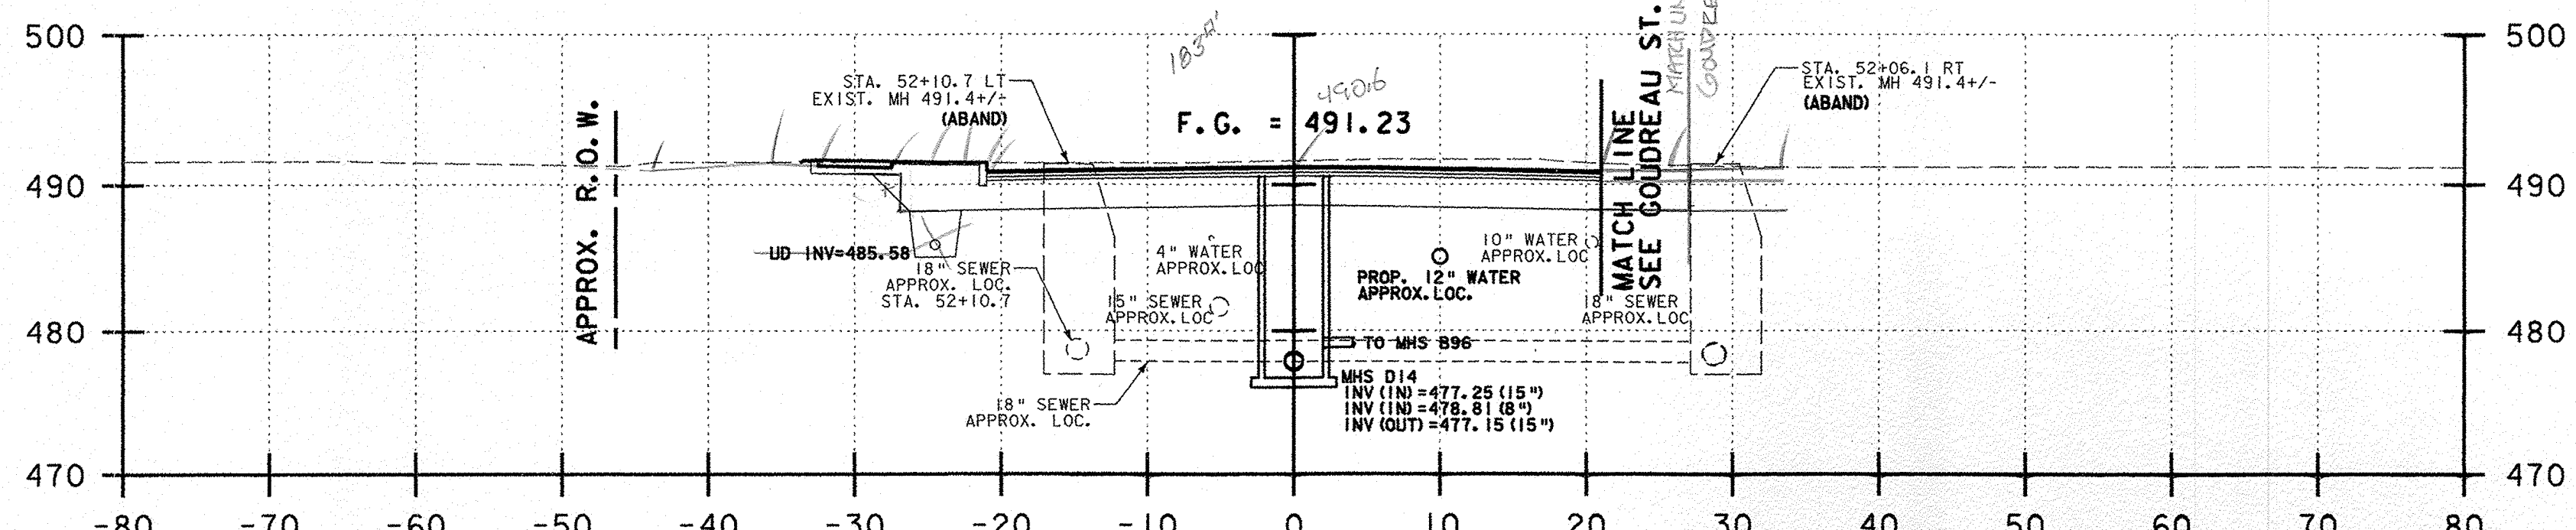

52+00.00

SUBBASE 116.59 SF 13L 3/23/10
 COMMON = 175.7 SF RCD 1/12/11
 F.G. = 54.0 LF RCD 1/25/11
 185'

NOTES:

1) REFER TO ROADWAY LAYOUT AND UTILITY LAYOUT SHEETS FOR PROPOSED ABANDONMENT, REMOVAL, OR PROTECTION REQUIREMENTS OF EXISTING UTILITIES IN CONFLICT WITH PROPOSED WORK.

U.S. ROUTE 5 HARTFORD AVENUE

PROJECT NAME: HARTFORD	
PROJECT NUMBER: RS 0113(40)	
FILE NAME: z86c027xsl.dgn	PLOT DATE: 1/11/2007
PROJECT LEADER: KEN UPMAL	DRAWN BY: E. ATKINS
DESIGNED BY: K. ISHIKURA	CHECKED BY: K. ISHIKURA
E. ATKINS	SHEET 218 OF 239